


LATERAL 18 MAIN 4 SWI SEWER
 BUILT BY: UTILITY CONTRACTORS INC
 PROJ. N^o DBKL 573070
 BOOKED 4-18-75 FROM G-1

on map

SCALE 1"=150'

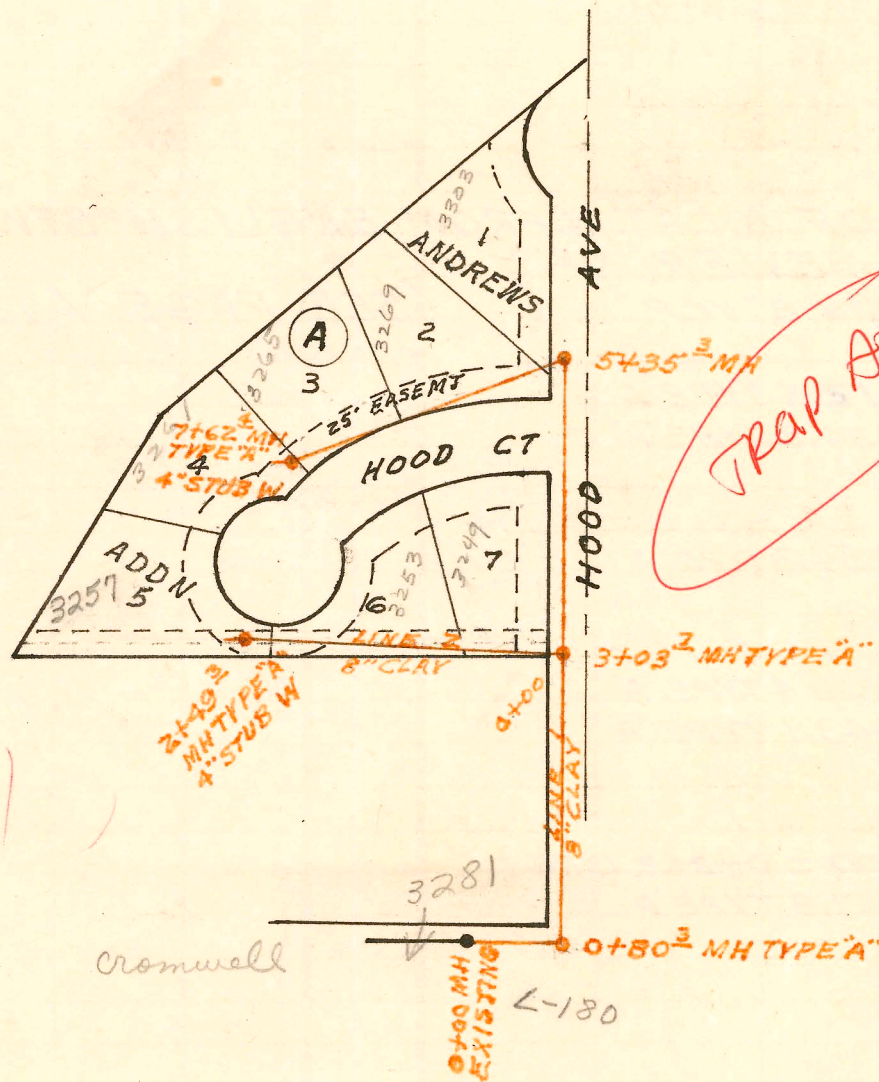


LATERAL 83 MAIN 4 S5 #23
 BUILT BY: W B CARTER CONST. CO.
 PROJ. N^o DBKL 574061
 BOOKED 4-21-75 FROM CG-16

Trap Area

on map

SCALE 1"=150'

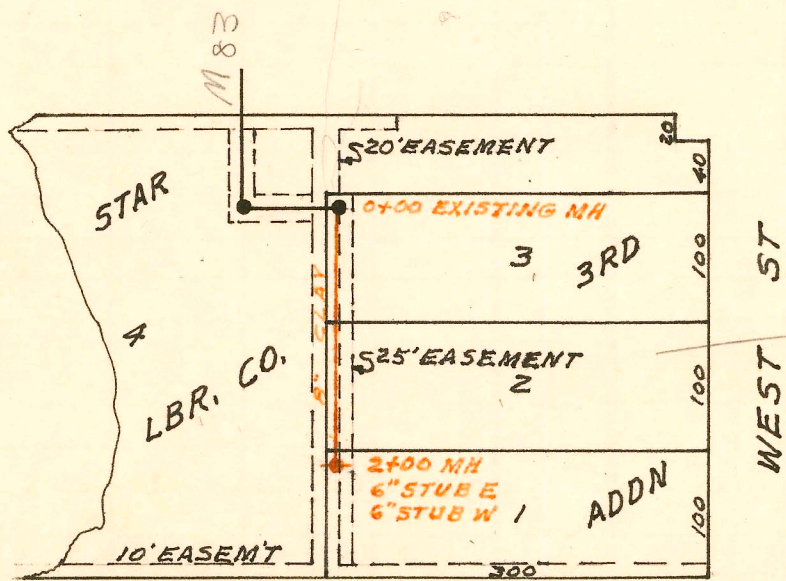

Refer to plat Book

STAR LUMBER CO. SAN. SEWER
 BUILT BY: (PRIVATE)
 PROJ. N^o DBKW 704064
 BOOKED 4-28-75 FROM PLAN

on map

SCALE 1"=150'

CONSTRUCTION RECORD

SERVICE RECORD

STATION	ELEVATION		Depth	MANHOLE	4-INCH "Y" BRANCHES		No. of Permit		House Number		DATE OF PERMITS	
	Ground	Grade			North West	South East	North West	South East	North West	South East	North West	South East
LATERAL 18 MAIN 4 SOUTHWEST INTERCEPT												
LINE 1	0+00	139.51	133.86	5.7	0+00							
	0+04 ²											
	1+00	140.2	134.26	5.9		tip 0+74.2		C54953	427 S. Socorro			4/23/76
	2+00	140.0	134.66	5.3		H6096	15801		411 S Socorro		8-11-86	
		140.0	134.70	5.3	2+09.9	TYPE 'A'						
	3+00	139.8	135.06	4.7					408 Jurguine		9/2/75	
		140.0	135.22	4.8	3+57.1	TYPE 'A' 4" STUB S		22898	400 S. EVERGREEN			4-12-89
LINE 2	0+00	140.0	134.80	5.2	0+00 = 2+09.9	LINE 1						
	1+00	140.1	135.20	4.9		tip 1+46.6		C49006	8331 University		4-14-75	
		140.2	135.40	4.8	1+50.3	TYPE 'A' 4" STUB N		1608	8301 University		4-16-86	
LATERAL 83 MAIN 4 SAN SEWER N^o 23												
LINE 1	0+00	129.6	121.76	7.8	0+00	EXISTING MH						
		129.6	122.82	7.6	0+80.3	TYPE 'A'						
	1+00	129.7	122.05	7.7								
	2+00	130.0	122.21	7.8		tip 2+26.3		C49914	3281 Cranwell		6-13-75	
	3+00	130.4	122.37	8.0								
		130.4	122.38	8.0	3+03.7	TYPE 'A'						
	4+00	130.4	122.56	7.8								
	5+00	130.9	122.76	8.1								
		130.6	122.83	7.8	5+35.3	TYPE 'A'		C63451	3303 Wood Ct		10-11-77	
	6+00	130.6	123.06	7.5				C61516	3109 Wood Ct		6-9-77	
	7+00	130.5	123.26	7.2				C59893	3265 Wood Ct		2-14-77	
		129.6	123.39	6.2	7+62.4	TYPE 'A' 4" STUB W		C55714	3261 Wood Ct		6-14-76	
LINE 2	0+00	130.2	122.47	7.7	0+00 = 3+03.7	LINE 1						
	1+00	130.1	122.67	7.4		0+71		C63452	3249 Wood Ct		10-11-77	
	2+00	130.8	122.87	7.9		1+46.3		C61513	3253 N Wood Ct	Rep	6-9-77	
		129.8	122.97	6.8	2+49.3	TYPE 'A' 4" STUB W		C50355	3257 N Wood Ct	See below	7-16-75	
STAR LUMBER CO. SANITARY SEWER (PRIVATE)												
	0+00	118.8	113.84	5.0	0+00	EXISTING MH		C57161	325 S. West			12-17-76
		120.2	114.24	6.0	2+00	TYPE MH 6" STUB E						
								C49216	325 S. West		4-24-75	

Star 2004-01992 7/2/04 328 N. Wood Ct Rep A goal plumber -

92-7700-7 5/22/72 - 325 S. west Bldg #106 - Brand - s/o 6" in MH
 92-7948-7 5/29/72 - 325 S. west Bldg #104 - Brand - s/o inside MH 6" line.