



SERVICE RECORD CONSTRUCTION RECORD

LINCOLN

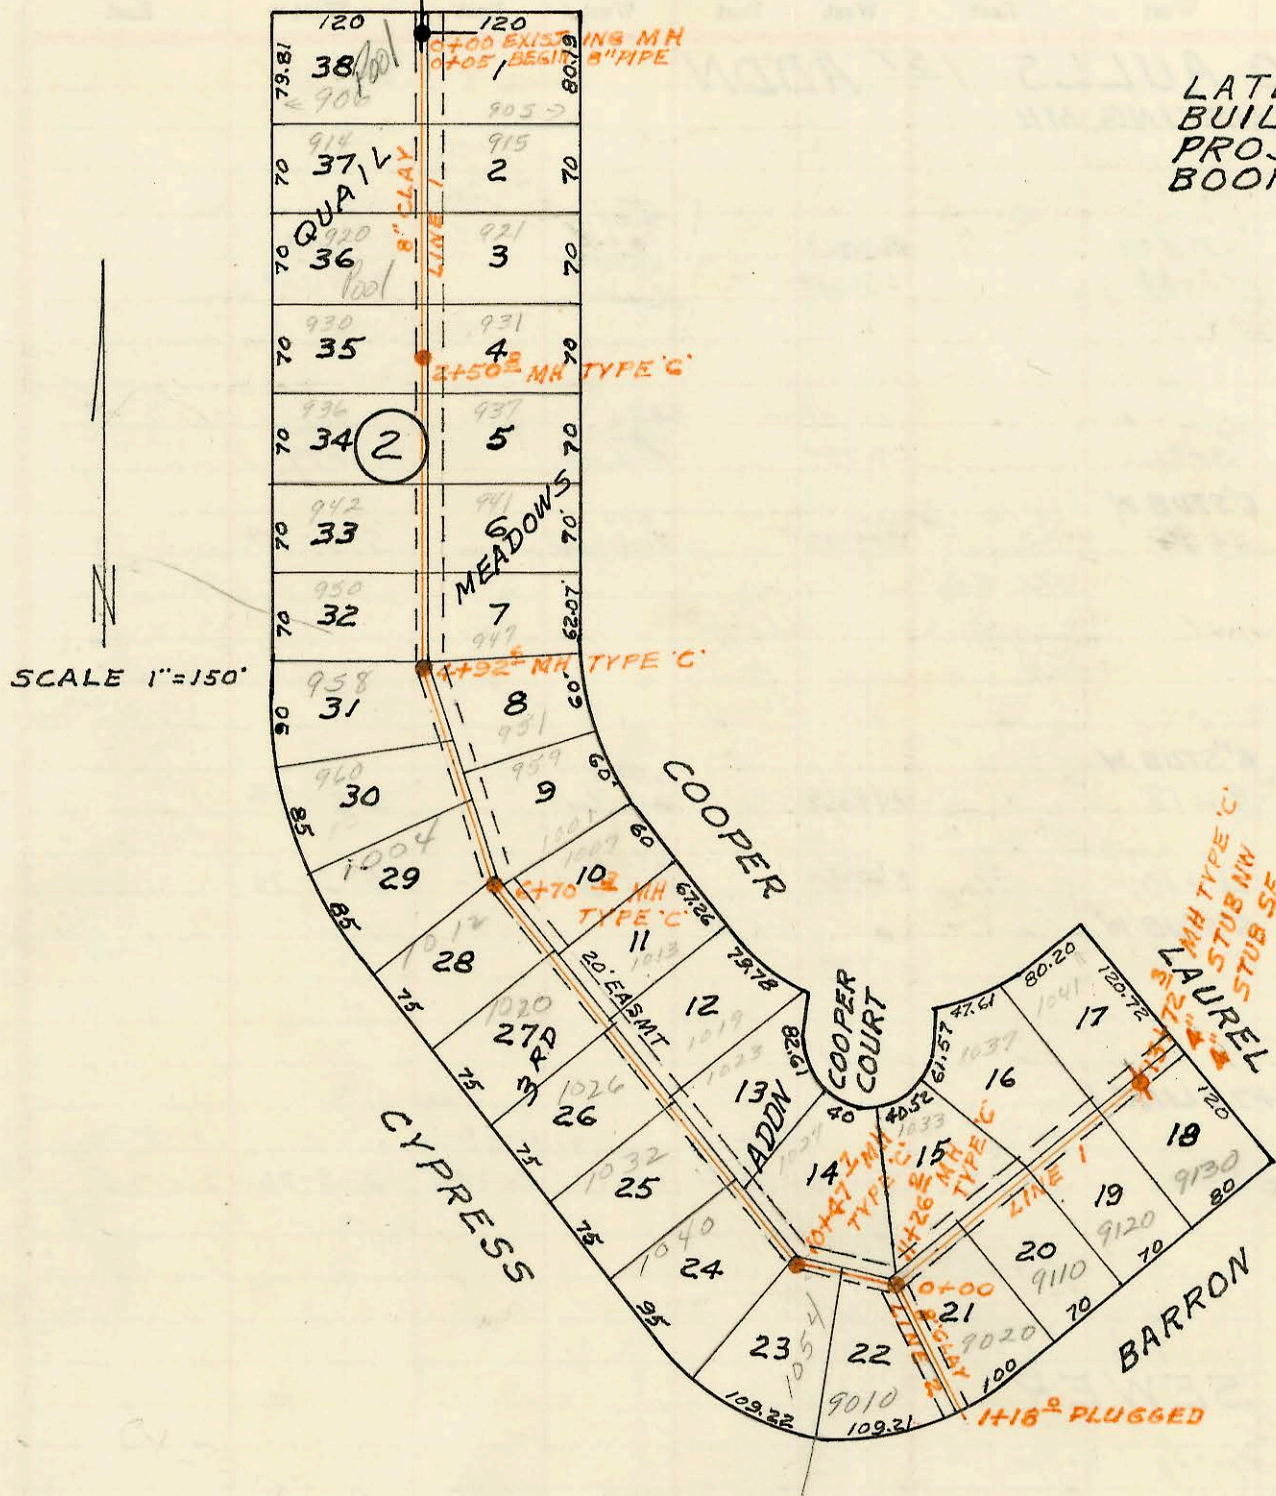

LATERAL 8 MAIN 18 WAR IND SEWER
 BUILT BY: WB CARTER CONST CO INC
 PROJ N^o DBKL574077
 BOOKED 5-29-75 FROM 261-Y

on map

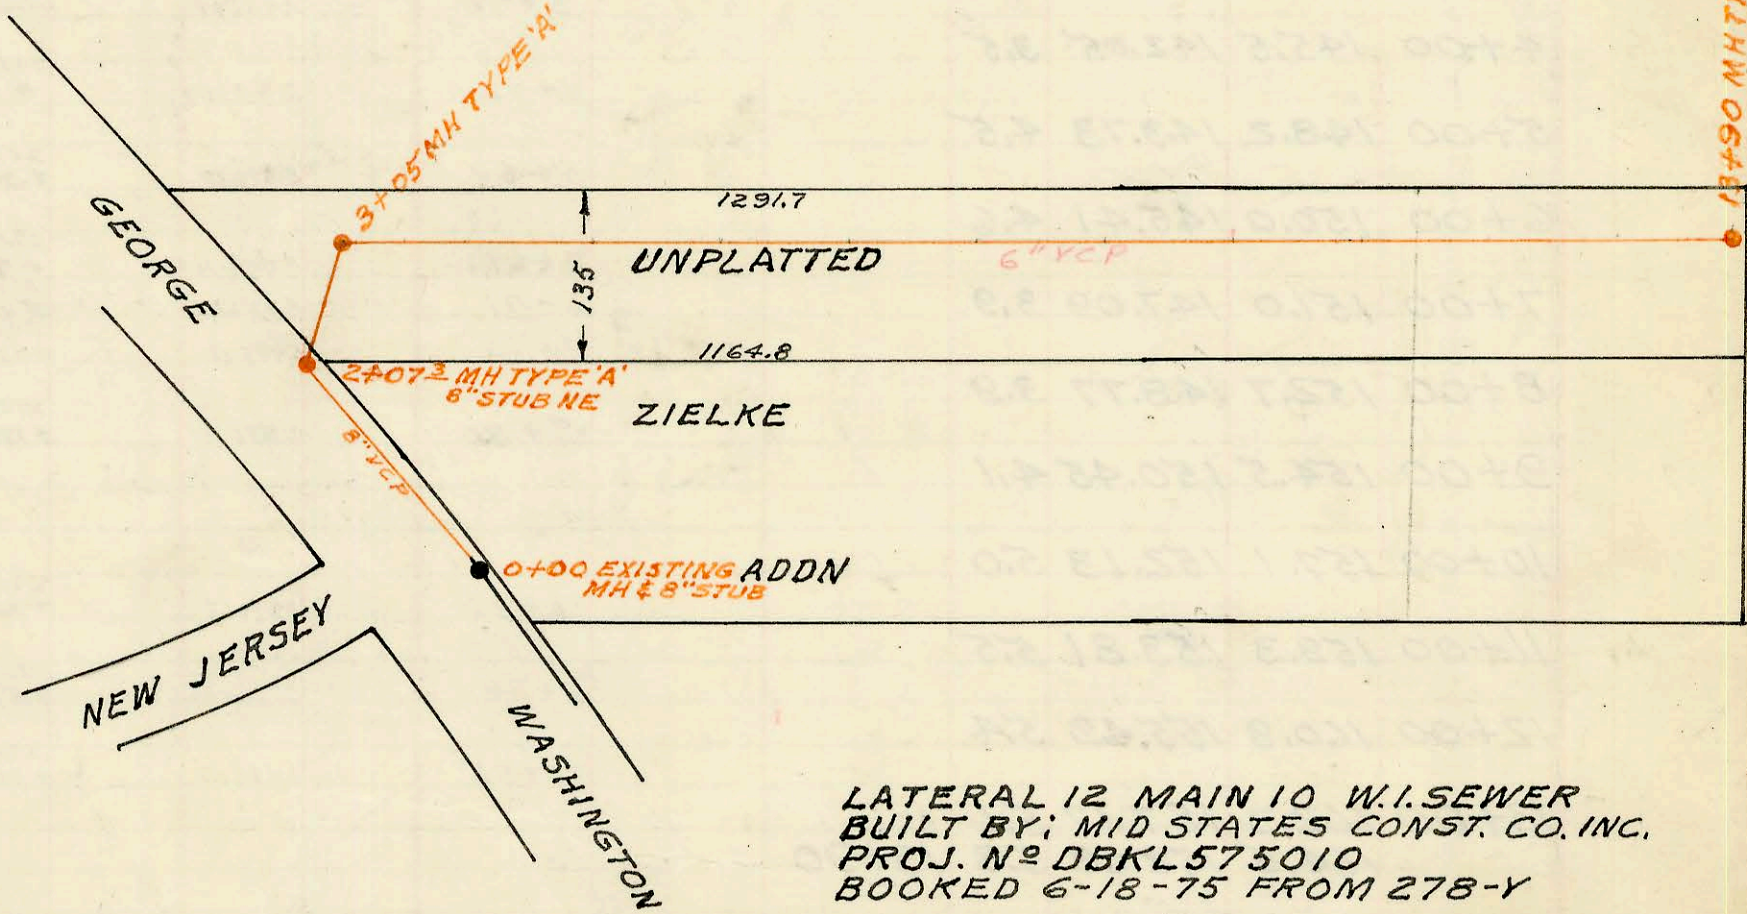

LATERAL 12 MAIN 10 W.I. SEWER
 BUILT BY: MID STATES CONST. CO. INC.
 PROJ. N^o DBKL575010
 BOOKED 6-18-75 FROM 278-Y

on map

CONSTRUCTION RECORD

SERVICE RECORD

STATION	ELEVATION		Depth	MANHOLE	4-INCH "Y" BRANCHES		No. of Permit		House Number		DATE OF PERMITS		
	Ground	Grade			North West	South East	North West	South East	North West	South East	North West	South East	
LAT 99 DCM 2 55 N#12 (CONT)													
LINE 4	0+00	201.7	191.05	10.7	0+00=10+90.8								
	1+00		193.09			0+71.0		17186				10-23-86	
		203.2	193.80	9.4	1+30.2	1+14.5		95-125127	21090	7700 E 1374 #83	87095	7-14-88	
	2+00		194.86					96-51337		7700 #60 7700 #59 1374 #58	4-4-92		
		204.0	195.65	8.5	2+45.7	3+89.1		6284		7700 #57 1374 #57	5-19-86		
	3+00		195.92					15092			11-21-85		
	4+00		196.42										
		206.0	196.55	9.5	4+26.3	4" STUB N 4" STUB S		14749		7700 E 1374 #56	9-26-85		
LINE 5													
	0+00	199.2	189.24	10.0	0+00=3+65.2	LINE 1							
		199.4	189.50	9.9	0+64.7	4" STUB N E	25-5 STAP	18734			7-21-87		
						4" STUB N W	0+57.2	CS1183	#109	#107	9-5-75	9-5-75	
LINE 6													
	0+00	201.4	191.16	10.2	0+00=3+65.3	LINE 2							
	1+00		191.58										
		202.3	191.72	10.6	1+10.1	4" STUB SE	0+48	CS1182	#110	#108	9-5-75	8-25-77	
	2+00		192.33										
		202.9	192.54	10.4	2+31.8	4" STUB N 4" STUB S	1+92.4	CS1182	#110	#108	9-5-75	8-25-77	
LINE 7													
	0+00	202.0	194.10	7.9	0+00=2+15.0	LINE 3							
		204.0	194.50	9.5	1+00.5	4" STUB N W 4" STUB S W	0+91.5	CS0841	#28	#11	8-14-75	8-25-75	
LINE 8													
	0+00	200.3	191.22	9.1	0+00=9+60.5	LINE 1							
		201.1	191.50	9.6	0+70.3	4" STUB N 4" STUB S	0+92.4	CS0837	#26		8-14-75		
LINE 9													
	0+00	204.8	195.00	9.8	0+00=9+40.6	LINE 2							
		205.3	195.26	10.0	0+62.8	4" STUB N 4" STUB S		CS0955				8-11-75	
LINE 10													
	0+00	203.2	193.94	9.3	0+00=1+30.2	LINE 4	0+84.5	19841		85	#35	8-6-87	
	1+00		195.54				0+40.5	20891	CS1450	#15	#34	6-17-88	
		206.0	196.41	9.6	1+49.7	4" STUB N 4" STUB S						9-22-75	
LINE 11													
	0+00	204.4	194.74	9.7	0+00=14+01.4	LINE 1	0+44.4	CS0966	#66			8-10-95	
		204.7	195.02	9.7	0+70.0	4" STUB N 4" STUB S	0+44.4	CS0966	#67	#68	8-22-75	8-22-75	
LINE 12													
	0+00	206.5	195.62	10.9	0+00=13+56.3	LINE 2							
		206.8	196.14	10.7	0+65.3	4" STUB N 4" STUB S		CS0891	#49	#47	8-19-75	8-11-75	
LATERAL 8 MAIN 18 WAR INDUSTRIES SEWER													
LINE 1	0+00	160.1	148.62	11.7	0+00 EXISTING MH								
	0+05				BEGIN 8" PIPE	0+41.2	0+33	CS4720	CS5769	906	705	4-9-76	6-7-76
	1+00	162.0	149.42	12.6		1+10	1+18	CS4727	CS5770	914	718	4-9-76	6-7-76
	2+00	162.6	150.22	12.4		1+74	1+70.2	CS4728	CS5771	920	724	4-9-76	6-7-76
		162.6	150.62	12.0	2+50.8	2+40.8	2+60.8	CS4729	CS5772	930	734	4-9-76	4-12-76
	3+00	162.6	151.02	11.6		3+19.8	3+25.8	CS4730	CS5773	936	740	4-9-76	4-21-76
	4+00	163.1	151.82	11.3		3+85.6	3+96.8	CS4731	CS5774	942	746	3-11-76	4-21-76
		162.8	152.56	10.2	4+92.6	4+55	4+46.1	CS4732	CS5775	950	754	3-11-76	4-22-76
	5+00	162.8	152.77	10.0		5+22.6	5+36.6	CS3008	C61485	958	762	1-2-76	7-7-77
	6+00	165.0	154.27	10.7		5+95.6		CS3007		960	764	1-2-75	
		166.5	155.42	11.7	6+70.3	6+31.2	6+32.6	CS2789	C61486	964	768	12-12-75	7-6-77
	7+00	166.9	155.87	11.0		7+07.2	7+35.1	CS2790	C58487	970	774	12-12-75	11-4-76
	8+00	168.2	157.37	10.8		7+83.2	8+05.3	CS2791	C62647	976	780	12-12-75	8-19-77
	9+00	170.0	158.87	11.1		8+61.2	8+35.5	CS2792	CS7760	982	786	12-12-75	9-17-76
	10+00	170.5	160.37	9.6		9+29.2	9+17.9	CS2793	C62823	988	792	12-12-75	8-31-77
		171.3	161.16	10.2	10+47.7	10+08.2		CS2794		994	798	12-12-75	
	11+00	172.3	161.49	10.8		10+92.2		CS5143		1000	804	12-21-95	
		172.5	161.63	10.9	11+26.2	11+12.2			CS1994	1033	807	10-20-75	
	12+00	173.2	162.19	11.0		12+07.8	11+60.3	CS9579	CS51993	1037	811	9-8-76	10-20-75
	13+00	173.7	162.79	10.9		12+83.2	12+08.9	CS4898	CS51284	1041	815	4-21-76	9-10-75
		173.9	163.21	10.7	13+72.3	13+12	13+12	CS4909	CS51286	1045	819	4-20-76	9-10-75
LINE 2													
	0+00	172.5	161.73	10.8	0+00=11+26.2	LINE 1							
	1+00	173.1	162.13	11.0									
	1+18	173.2	162.20	11.0	PLUGGED								
LATERAL 12 MAIN 10 WAR INDUSTRIES SEWER													
	0+00	146.3	139.39	6.9	0+00 EXISTING MH	8" STUB							
	1+00	144.7	139.66	5.0									
	2+00	143.2	139.93	3.3									
		143.2	139.95	3.3	2+07.3								

(CONT'D NEXT PAGE) 99-29107 21549 7700 #1374 #67

top - 1029 Cooper Ct - 82576 - 57372 (104-35.1)

01653
7-06-86