


LATERAL 4 MAIN 3 WESTLINK SEWER
 BUILT BY: MID STATES CONST CO
 PROJ. NO DBKL 574028
 BOOKED 7-22-75 FROM 9-L


SCALE 1"=150'

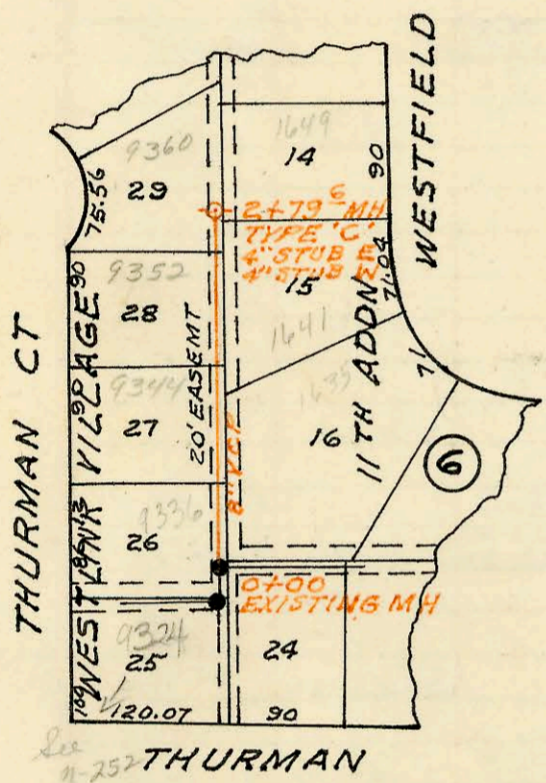

LATERAL 5 MAIN 3 WESTLINK SEWER
 BUILT BY: MID STATES CONST CO
 PROJ. NO DBKL 574029
 BOOKED 7-23-75 FROM 9-L

SCALE 1"=150'

LATERAL 6 MAIN 18 WAR IND. SEWER
 BUILT BY: UTILITY CONT. INC.
 PROJ. NO DBKL 574075
 BOOKED 7-24-75 FROM 289Y

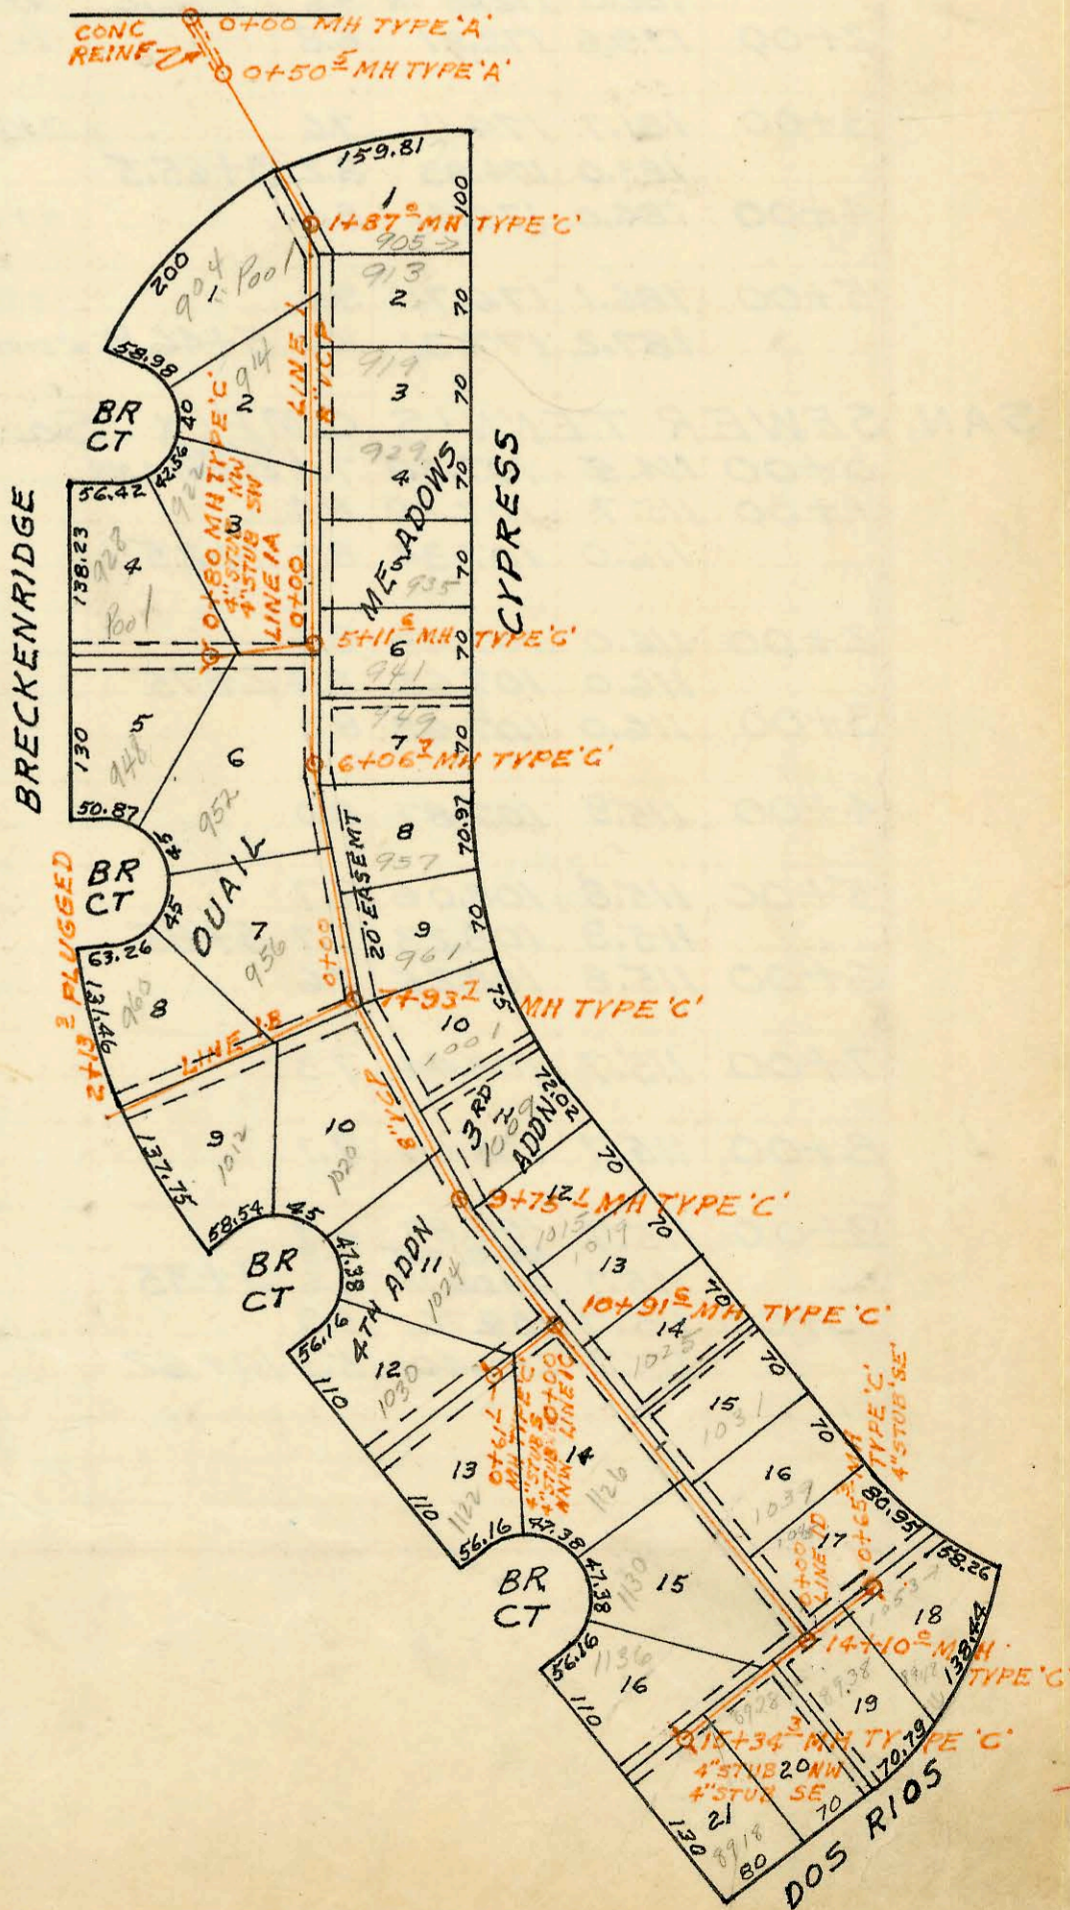

SCALE 1"=150'

CONSTRUCTION RECORD

SERVICE RECORD

STATION	ELEVATION		Depth	MANHOLE	4-INCH "Y" BRANCHES		No. of Permit		House Number		DATE OF PERMITS		
	Ground	Grade			North West	South East	North West	South East	North West	South East	North West	South East	
LATERAL 4 MAIN 3 WESTLINK SEWER													
0+00	155.0	143.95	11.1	0+00	0+42	0+21.2	C53549	C52265	1604	9424	2-3-76	11-3-75	
1+00	155.5	144.27	11.2		0+70.2	1+22	C53644	C50731	1610	9420	2-9-76	8-7-75	
2+00	156.0	144.60	11.4						1616	9414	11-3-75	8-7-75	
3+00	155.6	144.93	10.7		1+48.2	2+26.1	C52263	C50730	1620	9408	11-3-75	8-7-75	
4+00	155.4	145.26	10.1		2+04.2	3+00	C52264	C50729	1624	9408	2-3-76	8-7-75	
	155.2	145.36 OUT	9.8		3+13.2		C53562		1624	9408	2-3-76		
5+00	156.0	145.81	10.2		4+53.8	5+32.5	C53550	C50725	1654	9102	2-3-76	8-7-75	
	157.0	146.11 OUT	10.9		5+09.2		C53551		1654	9102	2-3-76		
	157.0	146.21 IN	10.8	5+54.8					1662		2-3-76		
6+00	157.7	146.41	11.3		5+84.2		C53552		1668		2-3-76		
7+00	158.8	146.91	11.9		6+67.2		C53553		1674		2-3-76		
8+00	158.8	147.41	11.4		8+95.2	11+42.9	C53554	C50728	1680	9366	2-3-76	8-7-75	
	159.0	147.61	11.4	8+32.9	4" STUB N	4" STUB S	C58755	C54362	1680	1657	11-18-74	3-31-76	
LATERAL 5 MAIN 3 WESTLINK SEWER													
0+00	160.0	147.50	12.5	0+00	EXISTING MH		C58214		9336		4-15-92		
1+00	159.2	147.90	11.3		76.7	76.5	C50723	57107	9344	1635	8-7-75	8-9-76	
2+00	158.8	148.30	10.5		1+76.6	2+21.2	C50726	C52650	9352	1641	8-7-75	12/3/75	
	158.6	148.62	10.0	2+79.6	4" STUB W	4" STUB E	C50727	C53517	9360	1649	8-7-75	1-30-76	
LATERAL 6 MAIN 18 WAR IND. SEWER													
LINE 1 0+00	153.5	147.17	6.3	0+00									
	153.7	147.32	6.4	0+50.5									
1+00	154.7	147.47	7.2										
	155.7	147.73 OUT	8.0										
2+00	155.8	147.83 IN	7.9	1+87.0	1+40	1+70	C62015	C58307	904	905	7-13-77	10-22-76	
						2+27		C58308	913			10-22-76	
						2+98		C58309	914			10-22-76	
3+00	156.2	148.17	7.7		3+06.6		C62016		914		7-13-77		
4+00	156.9	148.47	8.4										
					4+12.6		C62017	C56902	922	929	7-20-77	7-26-76	
5+00	156.5	148.77	7.7				C56907		935			7-26-76	
	156.6	148.80	7.8	5+11.6			C56014		941			6-21-76	
6+00	158.7	150.48	8.2		5+63.6	5+71.5	C63313	C56016	952	1199	10-3-77	6-21-76	
	158.8	150.59 OUT	8.2										
	158.8	150.63 IN	8.1	6+06.7									
7+00	161.2	152.48	8.7					C55500	957			5-19-76	
					7+08.5		C63314		950		10-3-77		
	163.6	154.21 OUT	9.4					C55501	961			5-19-76	
	164.0	154.31 IN	9.3	7+93.7									
8+00	164.0	154.41	9.6										
					8+48.3	8+69.2	C63317	C55389	1020	1001	10-3-77	5-12-76	
9+00	166.0	155.51	10.5		9+70.1		C63318		1024		11-25-77		
	166.5	156.23 OUT	10.2	9+75.1				C52109	1009			12-15-75	
	166.5	156.39 IN	10.1										
10+00	166.9	156.71	10.2										
								C58310	1015			10-22-76	
	168.2	157.65	10.6	10+91.6				C58311	1018			10-22-76	
11+00	168.3	157.81	10.5		4" pxtile								
					11+72.0	11+53.6	C63311	C58312	1126	1025	10-3-77	10-22-76	
12+00	169.5	158.91	10.6					C58313	1031			10-22-76	
								C58314	1039			10-22-76	
13+00	170.5	160.01	10.5										
14+00	171.4	161.11	10.3					C62982	1130	1039	9-9-77	10-22-76	
	171.5	161.17 OUT	10.3	14+10.0				C58315	1045			10-22-76	
		161.27 IN	10.2					C62895	1050			9-9-77	
								C62957	8725			9-8-77	
15+00	171.2	161.65	9.6					C62956	8725			9-8-77	
	170.9	161.77	9.1	15+34.3	4" STUB NW	4" STUB S	C62983	C62954	1136	8718	9-9-77	9-8-77	
LINE 1A	0+00	156.6	148.90	7.7	0+00=5+11.6								
		157.9	149.22	8.7	0+80.0	4" STUB NW	4" STUB SW	C61401	C63312	928	948	6-3-77	10-3-77
LINE 1B	0+00	163.6	154.31	9.3	0+00=7+93.7								
1+00	163.0	154.71	8.3										
2+00	163.6	155.11	8.1										
2+13.3	163.6	155.16	8.4	PLUGGED									

CONTINUED NEXT PAGE

Tap C50723 - 9344 Sherman Ct. - Van Hill - 8/7/75 (3+96.2)
Tap C53499 - 1634 Murray - Van Hill - 3-9-76

C50729 - 9408
C50730 - 9414