



LATERAL 5 MAIN 17 WAR IND SEW
 BUILT BY: UTILITY CONT. INC
 PROJ. N^o DBKL 573016
 BOOKED 7-25-75 FROM 279Y
 ON MAP

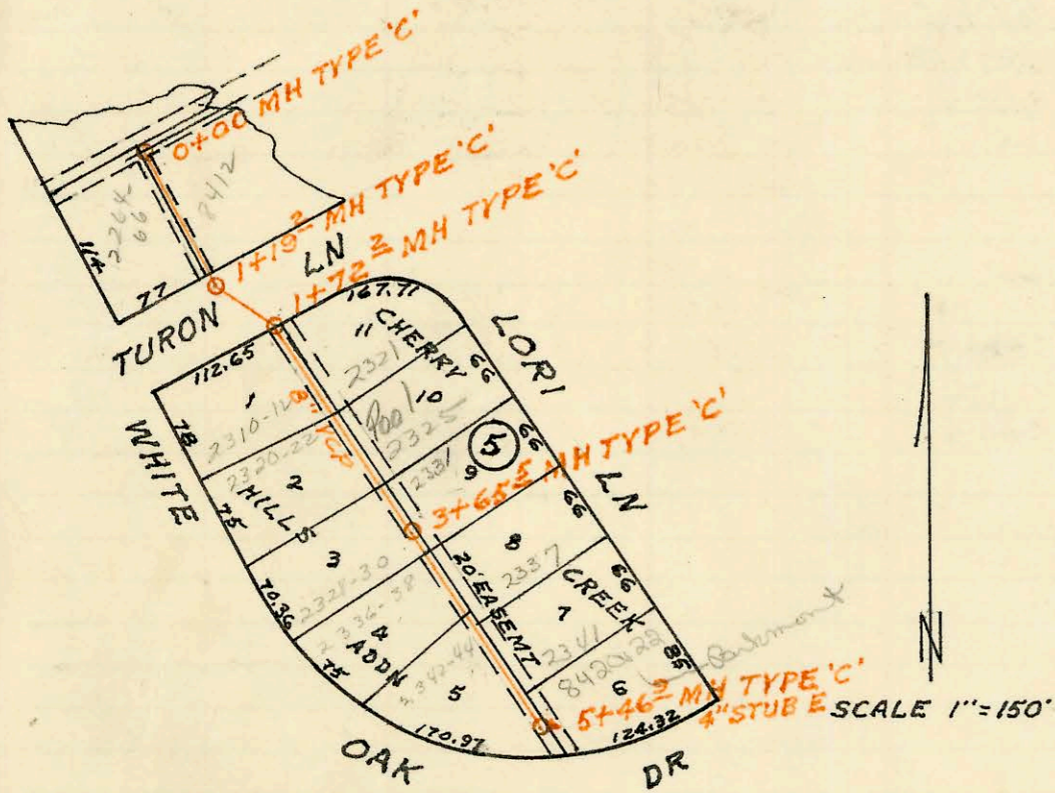

LATERAL 6 MAIN 17 WAR IND SEW
 BUILT BY: UTILITY CONT. INC.
 PROJ. N^o DBKL 573017
 BOOKED 7-25-75 FROM 279Y
 ON MAP

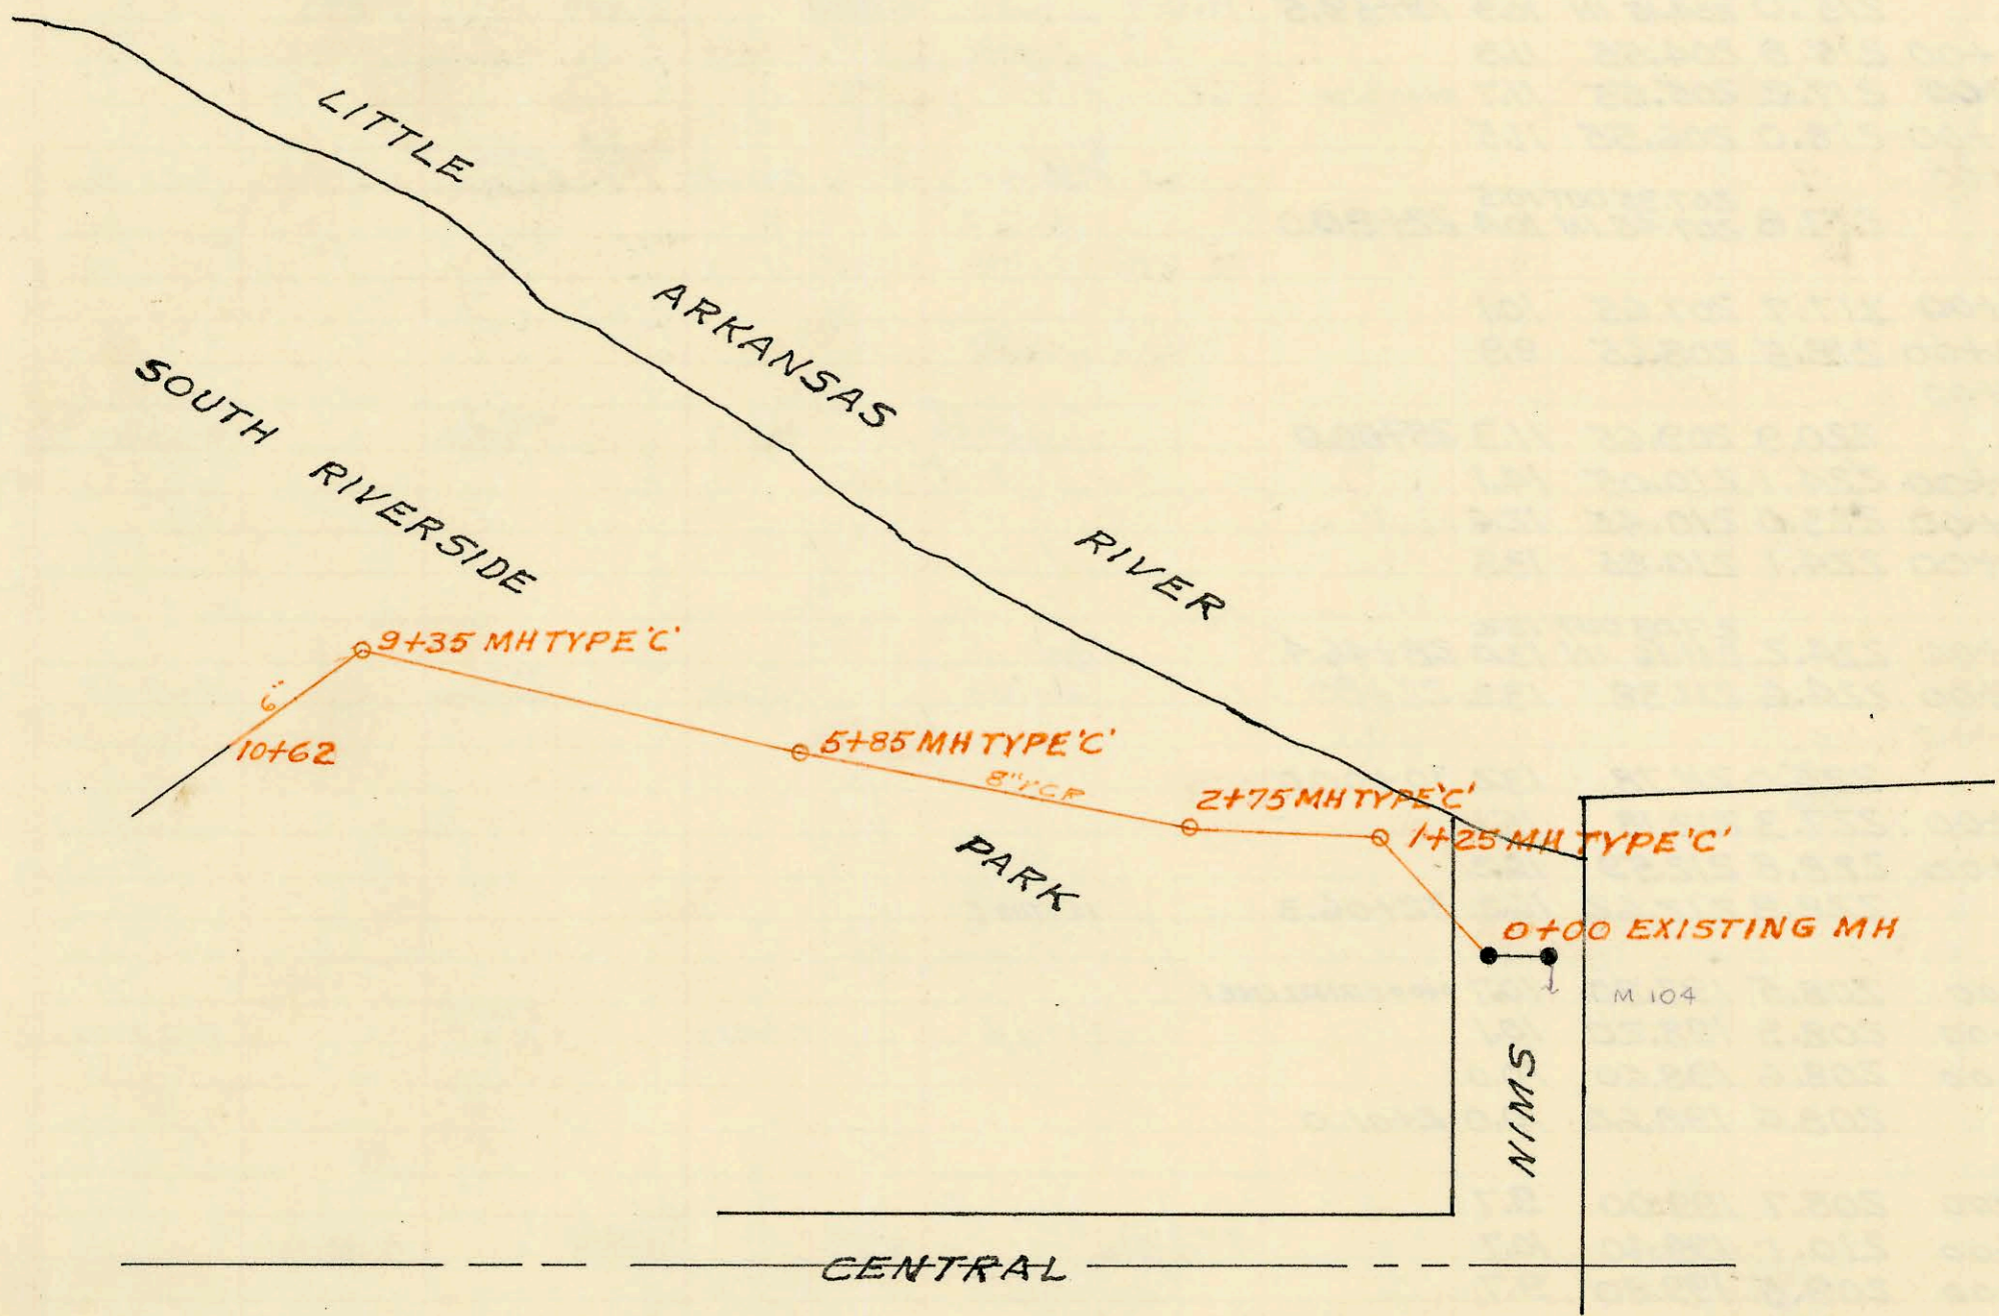

SANITARY SEWER TENNIS COMPLEX
 SOUTH RIVERSIDE PARK
 BUILT BY: (PRIVATE)
 PROJ. N^o DBKW 705003
 BOOKED 7-28-75 FROM PLAN
 ON MAP

