



LATERAL 12 MAIN 3 WESTLINK SEWER
 BUILT BY: MIDSTATES CONST CO INC
 PROJ. N^o DBKL574036
 BOOKED 8-21-75 FROM G-2

(14-7-3-20
 Engg. file number)

SCALE 1"=150'

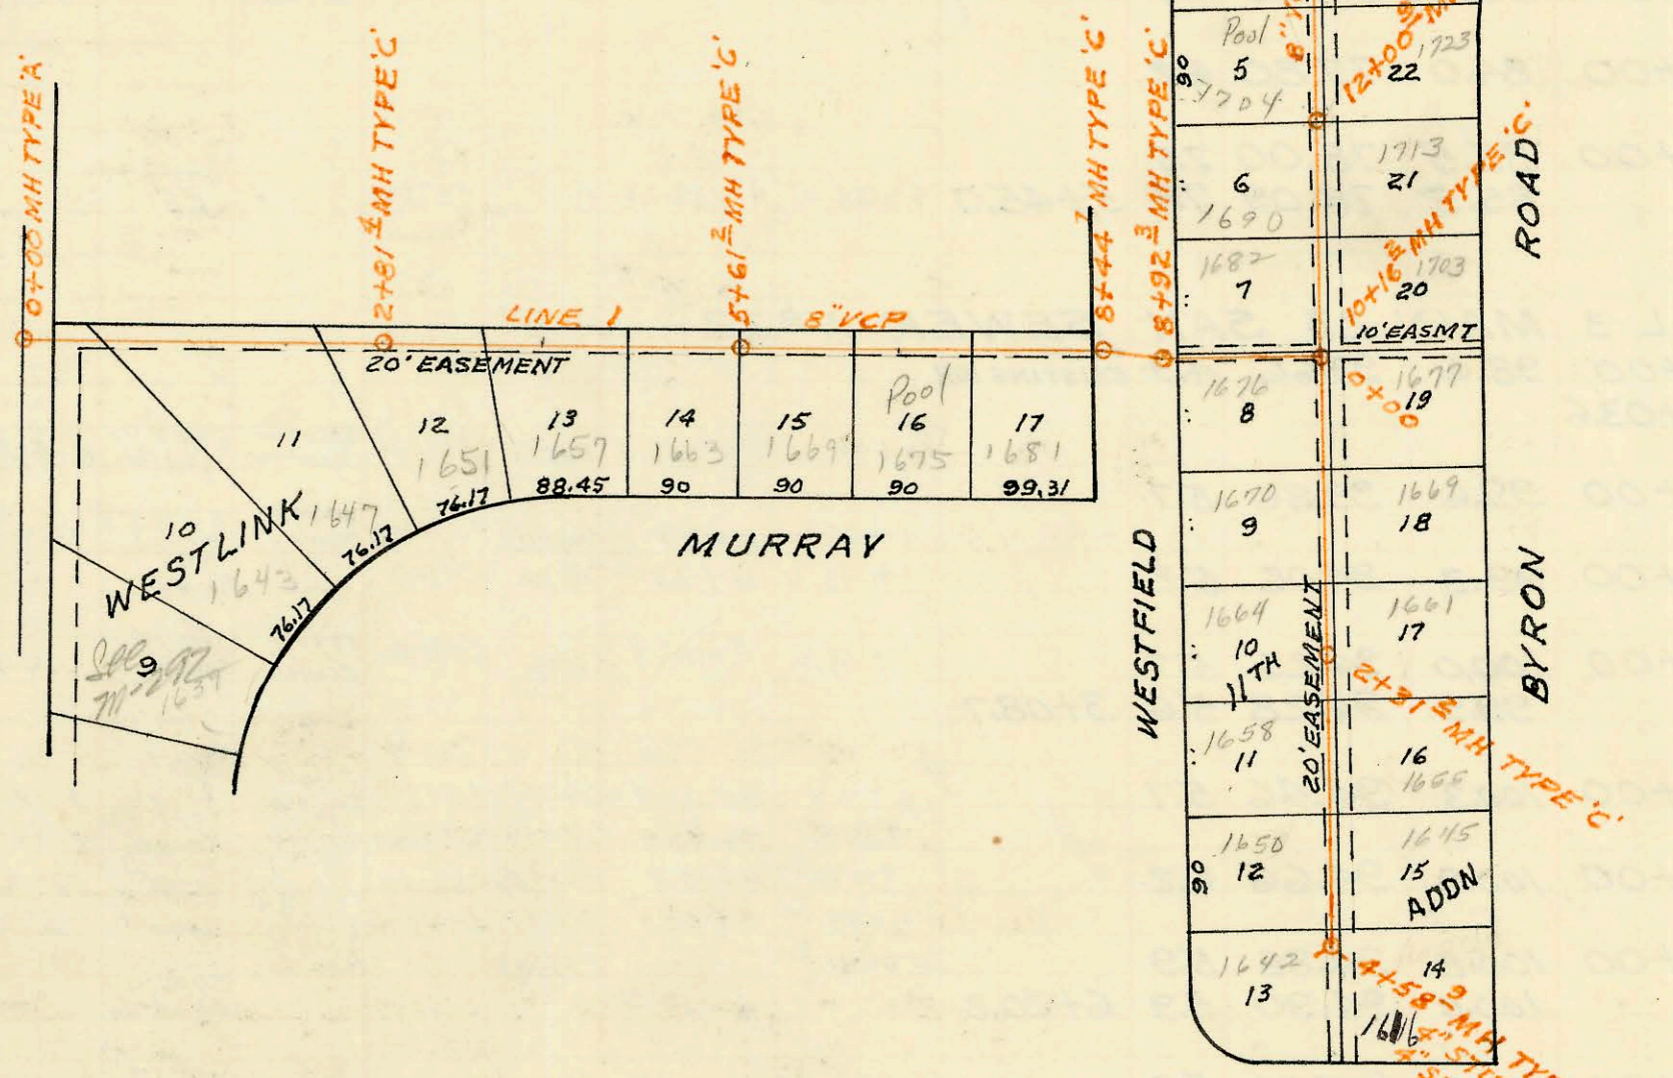

HARRY

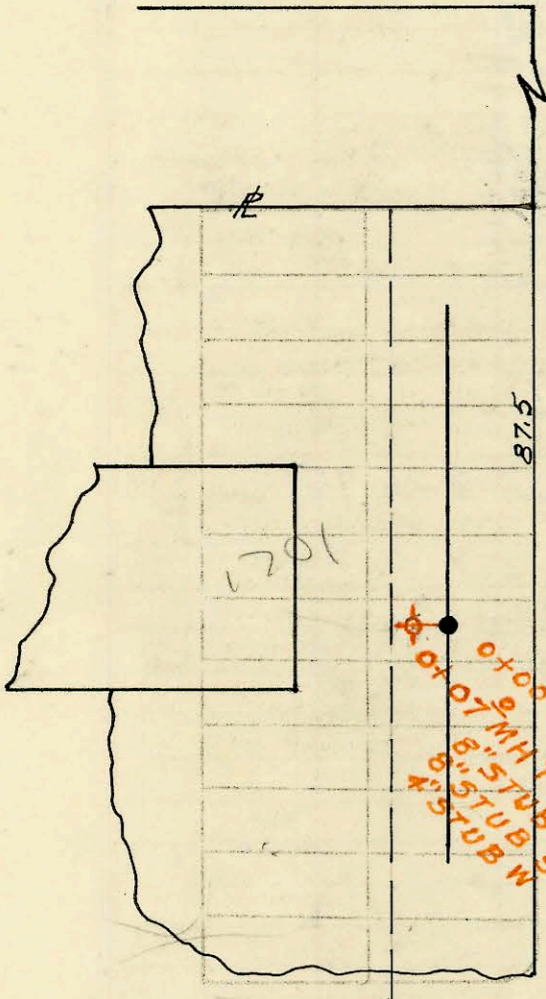

SCALE 1"=40'

SAN SEWER FOR THORNTON & FLORENCE
 ELECTRIC INC.
 BUILT BY: UTILITY CONT. INC.
 PROJ. N^o DBKW705015
 BOOKED 8-25-75 FROM PLAN

0+00 EXISTING MH = STA 176+75 ± SW1 (PAGE M 141)

CONSTRUCTION RECORD

SERVICE RECORD

STATION	ELEVATION		Depth	MANHOLE	4-INCH "Y" BRANCHES		No. of Permit		House Number		DATE OF PERMITS	
	Ground	Grade			North West	South East	North West	South East	North West	South East	North West	South East
LATERAL 12 MAIN 3 WESTLINK SEWER												
LINE 1 0+00	152.2	142.24 OUT 143.07 IN	9.0	0+00								
1+00	154.6	143.37	11.2			0+35.3	C56141		1643 Murray			6-25-76
2+00	155.5	143.67	11.8			2+13.6	C56143		1647 Murray			6-25-76
		155.8	143.91	11.9	2+81.4				1651 Murray			3-29-76
3+00	155.8	143.97	11.8			2+81.4	C54496					
4+00	156.5	144.27	12.2						1657 Murray			6-25-76
5+00	156.3	144.57	11.7			4+05.6	C56142		1663 Murray			7-11-77
		156.3	144.75	11.6	5+61.2	5+21.9	C61905					
6+00	156.3	144.87	11.4			5+75.8	C61906		1669 Murray			7-11-77
						6+82.2	C54489		1675 Murray			3-29-76
7+00	156.2	145.17	11.0			7+25.4	C59467		1681 Murray			1-13-77
8+00	156.5	145.47	11.0									
		156.7	145.60	11.1	8+44.7							
		157.0	145.75 OUT 145.77 IN	11.3	8+92.3							
9+00	157.2	145.79	11.4									
10+00	157.3	146.07	11.2									
		157.6	146.12	11.5	10+16.2							
						10+58.2	C53595	C50874	1682 N Westfield	1703 N Byron Rd	2-4-76	8-18-75
11+00	157.2	146.48	10.7			11+40.2	C53283	C50875	1690 N Westfield	1713 N Byron Rd	1-20-76	8-18-75
12+00	156.9	146.78	10.1									
		156.9	146.78	10.1	12+00.9	12+27.2	C50876		1723 N Byron Rd		1-20-76	8-18-75
						12+36.3	C53284		1704 N Westfield		2-4-76	8-18-75
13+00	156.4	147.08	9.3			13+35.6	C53598		1712 Westfield		2-4-76	8-18-75
		156.3	147.31 OUT 147.41 IN	8.9	13+78.6	13+91.9	C65356		731 Byron Rd		2-4-76	3-14-78
						14+22.4	C53599	C66451	1724 Westfield	1741 Byron Rd	2-4-76	5-17-78
14+00	156.4	147.48	8.9			14+97.1	C54114		1734 Westfield		5-13-76	
15+00	156.5	147.78	8.7			15+76.3	C60450		1746 Westfield		3-21-77	
16+00	156.8	148.08	8.7			16+29.6	C66450		1753 Byron Rd		3-21-77	5-17-78
16+82.0	157.2	148.33	8.9	PLUGGED								
LINE 2 0+00	157.5	147.27	10.2	0+00 = 10+16.2 LINE 1								
1+00	158.4	147.67	10.7			0+50.3	C53106		1676 N Westfield	1677 N Byron Rd	1-13-76	8-18-75
2+00	159.0	148.07	10.9			1+47.7	C53107	C50873	1670 N Westfield	1669 N Byron Rd	1-13-76	8-18-75
		159.1	148.19	10.9	2+31.2	2+26.2	C53594	C50872	1664 N Westfield	1661 N Byron Rd	2-4-76	8-18-75
3+00	159.6	148.47	11.1			3+22	C53649	C50871	1658 N Westfield	1655 N Byron Rd	12/3/75	8-18-75
						3+26.9	C61580		1650 N Byron Rd	1645 N Byron Rd	12/3/75	7-28-78
4+00	159.7	148.87	10.8			4+15.2	C52648	C60373	1643 N Westfield	1640 N Byron Rd	12/3/75	3-14-77
		159.2	149.10	10.1	4+58.9	4" STUB SW 4" STUB SE	C50804	C59876	1643 N Westfield	1640 N Byron Rd	8-12-75	2-11-77
SAN SEWER FOR THORNTON & FLORENCE ELECTRIC INC.												
0+00	111.0	104.00	7.0	0+00 = 176+75.4 SWI								
0+07.0	111.0	104.10 OUT 104.30 IN		0+07.0	4" STUB W 8" STUB N 8" STUB S mH Top OK		98-128207 4662		1701 Hoover	1701 S Hoover	10-1-78	11-16-81