



LATERAL 131 SAN SEWER N^o22
 BUILT BY: UTILITY CONT. INC.
 PROJ. N^o DBKL 575031
 BOOKED 8-27-75 FROM JK #4

SCALE 1"=150'

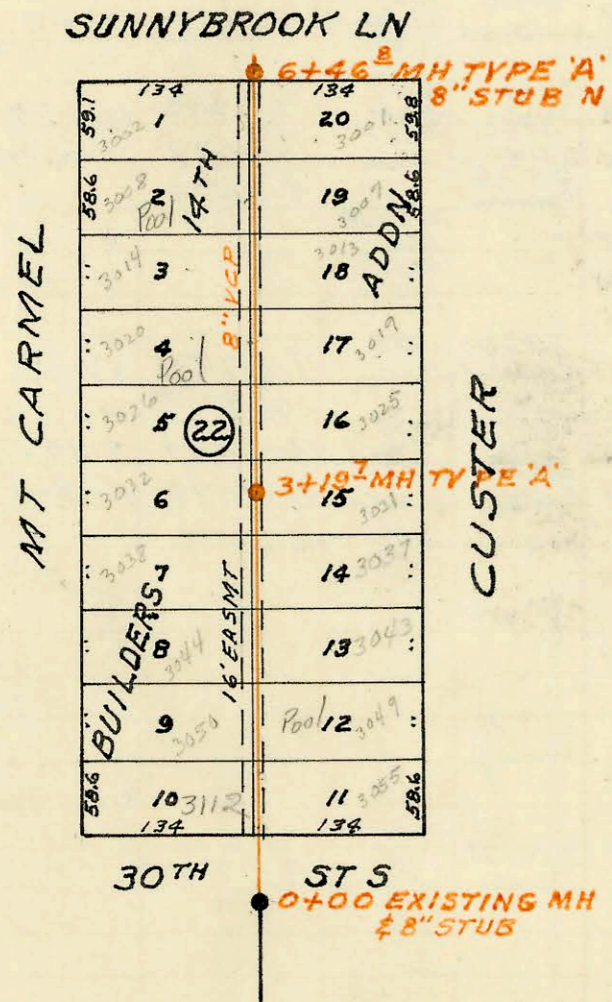

LATERAL 132 SAN SEWER N^o22
 BUILT BY: UTILITY CONT. INC.
 PROJ. N^o DBKL 575032
 BOOKED 8-27-75 FROM JK #4

SCALE 1"=150'

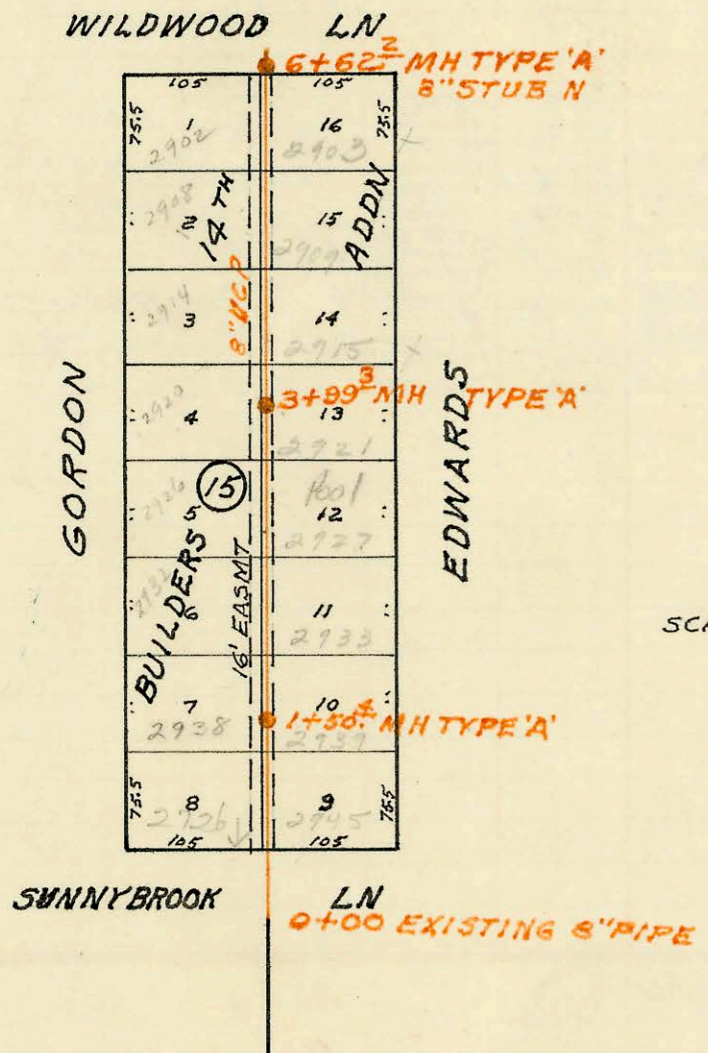

LATERAL 108 SAN SEWER N^o22
 BUILT BY: UTILITY CONT. INC.
 PROJ. N^o DBKL 568008
 BOOKED 8-28-75 FROM JAK #11

SCALE 1"=150'

CONSTRUCTION RECORD

SERVICE RECORD

LATERAL 131 SAN SEWER No 22

STATION	ELEVATION		Depth	MANHOLE	4-INCH "Y" BRANCHES		No. of Permit		House Number		DATE OF PERMITS	
	Ground	Grade			North West	South East	North West	South East	North West	South East	North West	South East
0+00	98.8	92.21	6.6	0+00 MH EXISTING								
0+50	100.0	92.28	7.7									
1+00	99.8	92.36	7.4		+78.2	1+24.6	C57181	C54503	3156 S. Custer	3155 S. Custer	8-11-76	3-25-76
2+00	99.8	92.51	7.3		1+54.2	1+49	C58420	C55801	3150 S. Custer	3149 S. Custer		6-8-76
3+00	100.1	92.66	7.4		1+49.2	2+02.2	C73517	C58419	3144 S. Custer	3143 S. Custer	8-9-77	10-29-76
3+00	100.0	92.71	7.3	3+29.9	2+56.4	2+66.5	C59920	C63667	3138 S. Custer	3137 S. Custer	2-15-77	10-25-77
4+00	100.3	92.81	7.5		3+21.5	3+95.0	4905	C63666	3132 S. Custer	3131 S. Custer	12-11-81	10-25-77
5+00	100.1	92.96	7.1		3+81.1	3+77.9	C57919	C63553	3126 S. Custer	3125 S. Custer	2-15-77	10-17-77
6+00	100.1	93.11	7.0		4+39.6	4+16.1	C64718	C63552	3120 S. Custer	3119 S. Custer	1-4-78	10-17-77
6+00	100.1	93.20	6.9	6+58.0	4+77	4+77	C64717	C73634	3114 S. Custer	3113 S. Custer	1-7-78	8-15-79
					4+94.3		C60579		3108 S. Custer		4-1-77	
					5+60.5		C5780		3102 S. Custer		7-12-76	
					6+21.2	6+09.4	56625	56626	3101 W. Custer	3074 W. Custer	7-12-76	7-12-76

LATERAL 132 SAN SEWER No 22

STATION	ELEVATION		Depth	MANHOLE	4-INCH "Y" BRANCHES		No. of Permit		House Number		DATE OF PERMITS	
	Ground	Grade			North West	South East	North West	South East	North West	South East	North West	South East
0+00	100.1	93.20	6.9	0+00 MH EXISTING								
1+00	100.1	93.35	6.8		1+02.4		C60535		3112 S. Custer		3-28-77	11-15-76
2+00	99.9	93.50	6.4		1+16	1+45.7	C65757	C58682	3049 S. Custer	3048 S. Custer		11-15-76
3+00	100.0	93.65	6.4		2+25.5	1+93.8	C64512	C55056	3044 S. Custer	3043 S. Custer	12-23-77	5-3-76
3+00	100.0	93.68	6.3	3+19.7	2+64.2	2+53.7	C69341	C55055	3038 S. Custer	3037 S. Custer	11-9-77	5-3-76
4+00	100.0	93.80	6.2		3+33.1	3+15.4	C64427	C64205	3032 S. Custer	3031 S. Custer	12-13-77	11-28-77
5+00	100.2	93.95	6.3		3+72.0	3+72.0	C64204		3025 S. Custer			11-28-77
6+00	100.2	94.10	6.1		3+66.5		C64792		3026 S. Custer		1-9-78	
6+00	100.0	94.17	5.8	6+46.8	4+36.0	4+31.1	C69580	C68681	3020 S. Custer	3019 S. Custer	11-22-78	10-3-78
					4+76.8	4+83.1	C671	C72532	3014 S. Custer	3013 S. Custer	4-14-80	6-25-79
					5+55.0	5+55.3	C71859	C67534	3008 S. Custer	3007 S. Custer	5-21-79	11-27-78
					6+07.3	6+07.3	C70108		3001 S. Custer		1-12-79	
					8+51.0	8+51.0	C72683-7		3002 S. Custer		5-24-91	

LATERAL 108 SAN SEWER No 22

STATION	ELEVATION		Depth	MANHOLE	4-INCH "Y" BRANCHES		No. of Permit		House Number		DATE OF PERMITS	
	Ground	Grade			North West	South East	North West	South East	North West	South East	North West	South East
0+00	98.5	93.67	4.8	0+00 EXISTING 8" PIPE								
1+00	99.0	93.82	5.2		Tap 0+82.8		C51630		2945 S. Edwards		9-30-75	
1+00	99.8	93.90	5.9	1+50.4	Tap 0+99		C54823		2938 S. Edwards		4-12-76	9-30-75
2+00	99.4	93.97	5.4		1+29.5	2+22.9	C59893	C5728	2932 S. Edwards	2931 S. Edwards	2-11-77	10-16-75
3+00	99.2	94.12	5.1		3+06.6	3+06.6	C59818		2926 S. Edwards		2-11-77	
3+00	99.8	94.27	5.5	3+99.3	Tap 3+01.3		C51628		2927 S. Edwards			9-30-75
4+00	99.8	94.27	5.5		3+82.8	3+66.3	C60442	C51627	2920 S. Edwards	2921 S. Edwards	3-21-77	9-30-75
5+00	101.0	94.42	6.6		4+57.3		C60441		2914 S. Edwards		5-2-77	
6+00	100.2	94.57	5.6		Tap 4+49.3		C51927		2908 S. Edwards			10-16-75
6+00	100.2	94.67	5.5	6+62.2 8" STUB N	5+29.4	5+36.2	C61637	C51930	2902 S. Edwards	2903 S. Edwards	6-16-77	10-16-75
					6+10.7	6+10.6	C61636	C51626	2902 S. Edwards	2903 S. Edwards	6-16-77	9-30-75