



LATERAL 21 MAIN 17 WAR INDUSTRIES SEWER
 BUILT BY: WOODSIDE CONST. CO. INC.
 PROJ. NO DBKL 574104
 BOOKED 9-8-75 FROM 9N
on map

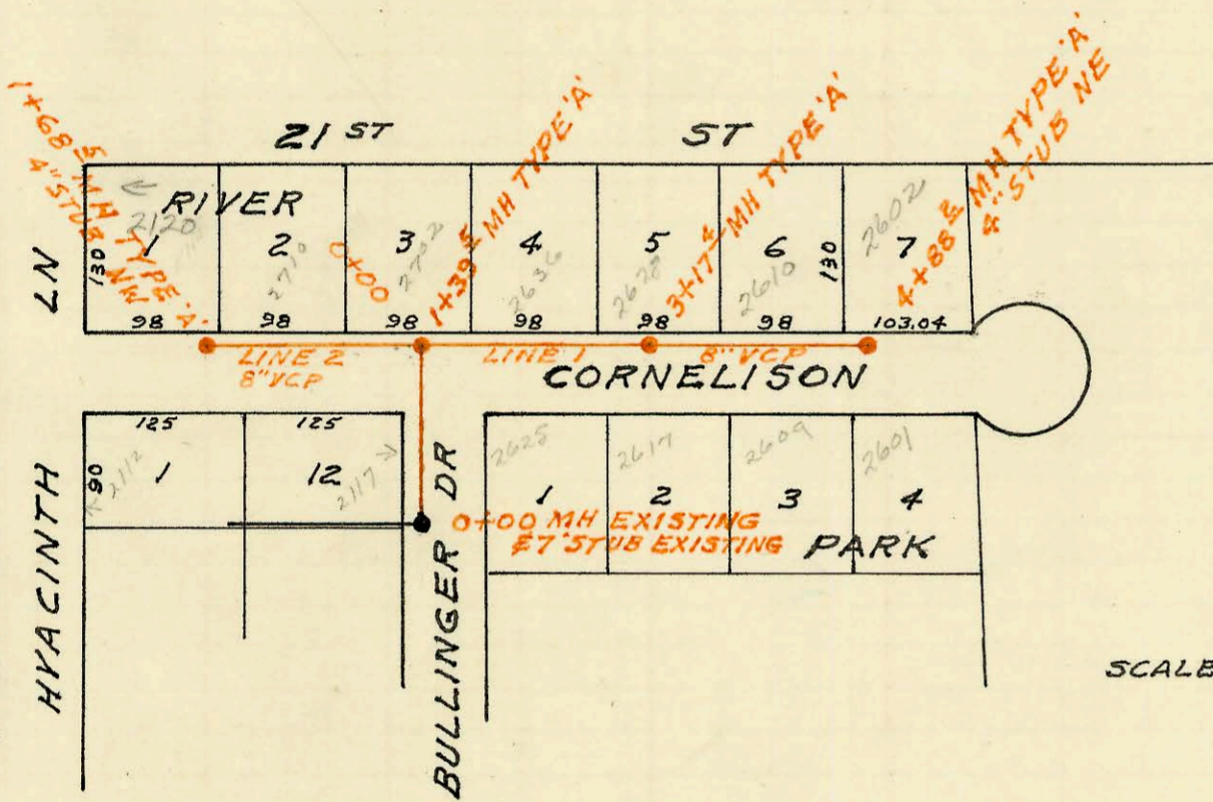

LATERAL 6 MAIN 19 SAN SEWER NO 22
 BUILT BY: MID STATES CONST. CO. INC.
 PROJ. NO DBKL 564016
 BOOKED 9-9-75
on map

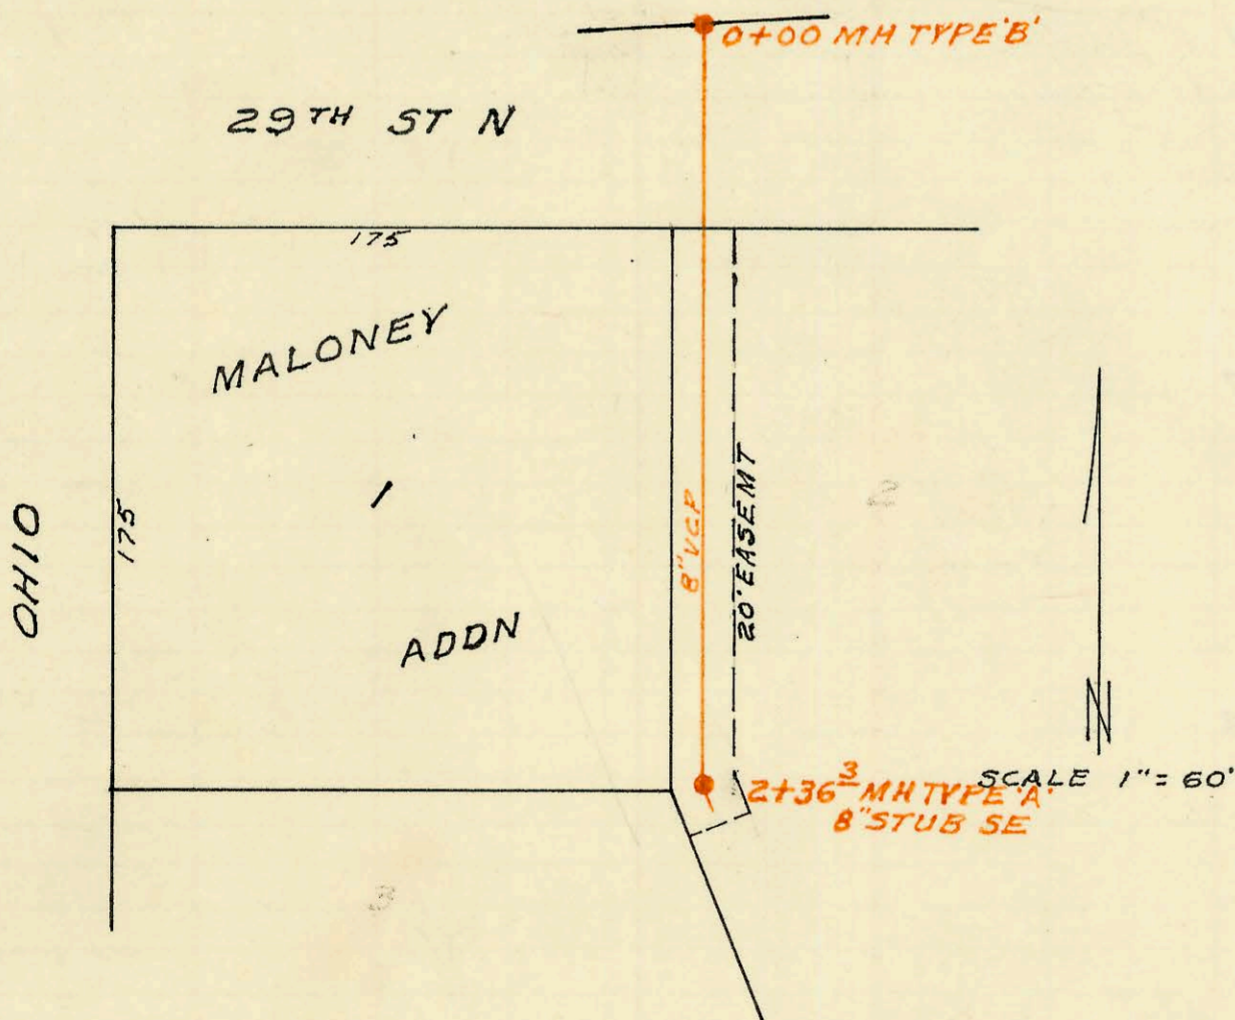

SAN SEWER MALONEY ADDN
 BUILT BY: UTILITY CONT. INC.
 PROJ. NO DBKW 705018
 BOOKED 9-12-75 FROM PLAN
on map

CONSTRUCTION RECORD

SERVICE RECORD

STATION	ELEVATION		Depth	MANHOLE	4-INCH "Y" BRANCHES		No. of Permit		House Number		DATE OF PERMITS	
	Ground	Grade			North West	South East	North West	South East	North West	South East	North West	South East
LATERAL 21 MAIN 17 WAR INDUSTRIES SEWER												
LINE 1 0+00	148.33	136.02	12.3	0+00 MH EXISTING								
1+00	149.8	138.62	11.2		Jap 0+65	0+23	C59849		1806 White Oak	8254 Bluestem	4-16-76	5-14-79
2+00	152.0	141.22	10.8		1+67.6	2+14.8	C59851		1810 White Oak	8246 Bluestem	4-16-76	7-17-79
3+00	156.0	143.82	12.2			2+79.7		C73022				3-30-78
	157.0	144.47	12.5	3+27.8				165639				
4+00	158.6	146.42	12.2		3+32.7	3+55.9	C55840	C57002	1820 White Oak	8238 Bluestem	6-10-76	8-2-76
	160.7	148.08	12.6	4+60.7	3+94.5	4+31.1	C55841	C57003	1828 White Oak	8234 Bluestem	6-10-76	8-2-76
5+00	161.5	149.12	12.4		4+94.3		C55842		1834 White Oak		6-10-76	
	161.6	149.56	12.0	5+18.4 4" STUB SSW		4+96.4		C57001	1842 White Oak	8210 Bluestem	6-10-76	8-2-76
LINE 2												
0+00	157.0	144.57	12.4	0+00 = 3+27.8 LINE 1								
1+00	156.4	144.97	11.4									
1+33	156.7	145.10	11.6	PLUGGED								
LATERAL 6 MAIN 19 SAN SEWER No 22												
LINE 1 0+00	124.6	118.64	6.0	0+00 MH EXISTING								
0+07	124.7	118.65	6.1									
1+00	124.9	118.84	6.1									
	125.8	119.02	6.8	1+39.5								
2+00	125.9	119.14	6.8		1+66.4				2636 Cornelian		1-29-76	
3+00	124.6	119.34	5.3									
	126.0	119.36	6.6	3+17.4	3+30.7				2628 Cornelian		11-2-77	
4+00	123.6	119.54	4.1		4+02.4				2610 Cornelian		5-24-77	
	126.3	119.70	6.6	4+88.2 4" STUB NE					2602 Cornelian		1-14-76	
LINE 2												
0+00	126.0	119.02	7.0	0+00 = 1+39.5 LINE 1								
1+00	126.7	119.42	7.3		0+39.5				2702 Cornelian		8-3-76	
	127.1	119.70	7.4	1+68.5 4" STUB NW	1+00.4				2710 Cornelian		3-13-78	
									2720 Hypocinth		3-4-76	
SAN SEWER MALONEY ADDN												
0+00	127.1	117.47	9.6	0+00								
1+00	126.2	117.87	8.3									
2+00	125.8	118.27	7.5		Jap 2+11.3			92-5254-7	2950 H.R		4-15-72	
	125.5	118.42	7.1	2+36.3				C51671	2932 N. Ohio		10-2-75	
								C67988	Ohio		8-22-78	