


SERVICE RECORD

CONSTRUCTION RECORD

DATE OF SERVICE	BY	DATE OF SERVICE	BY	DATE OF SERVICE	BY	DATE OF SERVICE	BY

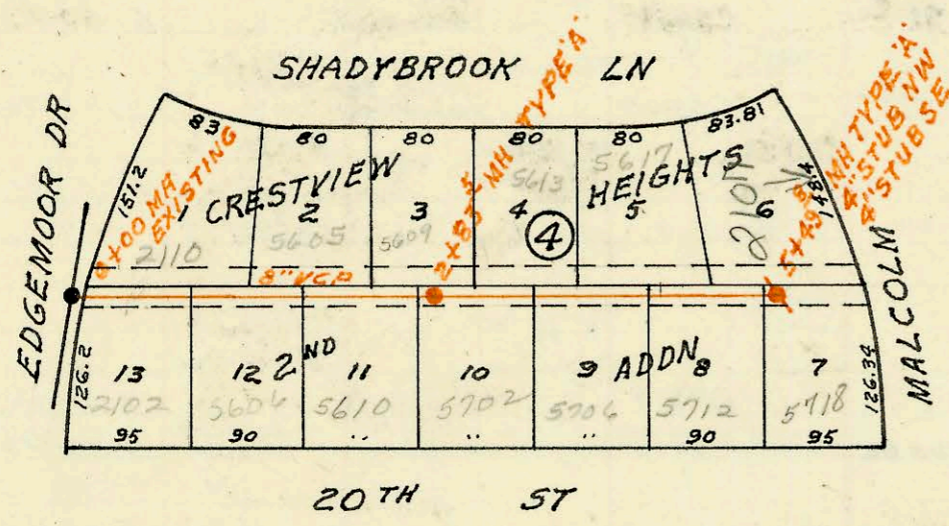

SCALE 1"=150'

N

LATERAL 12 SUBMAIN 5 SAN SEWER N°23
 BUILT BY: WOODSIDE CONST. CO. INC.
 PROJ. N° DBKL 566041
 BOOKED 10-9-75 FROM 1H77

CONSTRUCTION RECORD

SERVICE RECORD

STATION	ELEVATION		Depth	MANHOLE	4-INCH "Y" BRANCHES		No. of Permit		House Number		DATE OF PERMITS	
	Ground	Grade			North West	South East	North West	South East	North West	South East	North West	South East
LINE 2 (CONT'D)												
4+00	153.7	139.44	14.3		8325 F. HARRY							
					4+98.4							
5+00	154.0	139.85	14.2				C52103		Bldg #6		10-23-75	
6+00	154.0	140.25	13.8		8325 F. HARRY							
	154.0	140.28	13.7	6+07.2	6+04.2		C52101		Bldg #9		10-23-75	
					6+06.2		C52102		Bldg #8		10-23-75	
7+00	154.6	140.65	14.0		7+20		C52100		Bldg #9		10-23-75	
8+00	155.2	141.06	14.1									
9+00	155.0	141.46	13.5		8419 F. HARRY							
	154.9	141.70	13.2	9+09.6								
10+00	154.2	142.06	12.1		10+42.6		C52102		Bldg #4		10-23-75	
11+00	150.7	142.47	8.2									
12+00	150.0	142.87	7.1		8419 F. HARRY							
	152.0	142.93	9.1	12+18.2								
		143.18	8.8									
13+00	151.5	143.50	8.0		12+88		C51836		Bldg #6		10-10-75	
	151.5	143.62	7.9	13+30.2								
LINE 2A												
0+00	152.0	146.92	5.1	0+00=12+18.2 LINE 2	8419 F. HARRY							
					0+21	1+01.2	C52108	C52109	Bldg #8	Bldg #7	10-23-75	10-23-75
1+00	153.9	147.73	6.2		1+26.3		C52107		Bldg #5			
	154.9	147.98	6.9	1+31.3								
LINE 2B												
0+00	154.9	148.09	6.8	0+00=9+09.6 LINE 2	8419 F. HARRY							
1+00	158.8	150.09	8.7		1+41.2		C52104		Bldg #2		10-23-75	
2+00	160.3	152.09	8.2		2+20.2	2+42.2	C51823		Bldg #3	Bldg #1	10-10-75	10-23-75
	160.9	153.00	7.9	2+46.3			C52106					
LINE 3												
0+00	146.0	135.94	10.1	0+00=2+41.2 LINE 1	8201 F. HARRY							
					0+34.3		C52093		Bldg #9		10-23-75	
1+00	146.6	137.14	9.5		1+13	1+06.6	C52092	C52090	Bldg #18	Bldg #7	10-23-75	10-23-75
2+00	149.5	138.34	11.2			2+05.4	C52099		Bldg #16		11-23-75	
3+00	148.5	139.53	9.0		8201 F. HARRY							
	148.5	139.67	8.8	3+11.4								
		139.92	8.6									
4+00	149.0	140.73	8.3		3+74.2		C52098		Bldg #15		10-23-75	
	149.0	141.30	7.7	4+47.5								
LATERAL 12 SUBMAIN 5 SAN SEWER N ^o 23												
0+00	209.5	199.11	10.4	0+00 MH EXISTING	YN	YS						
0+04												
1+00	211.6	199.51	12.1		1+69.5	1+34.5	56651	C55149	5605 Shadybrook	5606 E. 20th St.	7-12-76	5-10-76
2+00	211.0	199.91	11.1			2+61.1		C51170		5610 B. 20th St.		10-2-75
	212.7	200.23	12.5	2+83.5	2+91.5		C53964		5609 Shadybrook		2-27-76	
3+00	213.0	200.31	12.7		3+58.5	3+16.3	C55145	C55146	5613 Shadybrook	5702 E. 20th St.	5-10-76	5-10-76
4+00	212.8	200.71	12.1		4+58.5	4+15.9	C53484	C51445	5617 Shadybrook	5706 B. 20th St.	1-29-76	10-17-75
5+00	212.8	201.11	11.7		4+77.2		C52459		5712 E. 20th St.		11-14-75	
	213.1	201.31	11.8	5+49.8	4" STUB NW	4" STUB SE	515887	C62057	5718 E. 20th St.		9-12-75	7-14-77