

SCALE 1"=150'


LATERAL 86 MAIN 4 SS No 23
BUILT BY: W.B. CARTER CONST CO INC
PROJ. No DBKL 575037
BOOKED 10-22-75 1H 58

CLEVELAND

NEW YORK

SE COR NE 1/4
SEC 4 T 27 S R 1 E

MATHEWSON

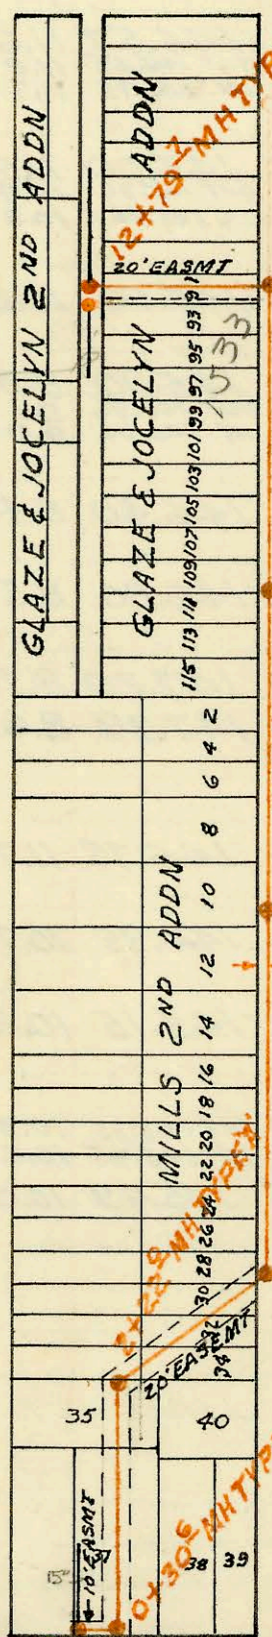

SCALE 1"=150'

RELOCATION MAIN 'D' SS No 1
BUILT BY: WOODSIDE CONST. CO.
PROJ. No DBKM 575002
BOOKED 10-23-75 FROM 1H 90

See A 399

2045

2525 New York

LOT 3
2525 New York

2525 New York
Lot 2

L:27

0+00 EXISTING MH

Private line -
not responsibility
of city

0+00 MH TYPE 'A'

10' EASEMT

13 TH ST

See A 399

CONSTRUCTION RECORD						SERVICE RECORD						
STATION	ELEVATION		Depth	MANHOLE	4-INCH "Y" BRANCHES		No. of Permit		House Number		DATE OF PERMITS	
	Ground	Grade			North West	South East	North West	South East	North West	South East	North West	South East
LATERAL 86 MAIN 4 SAN SEWER N ^o 23												
0+00	124.5	115.46	9.0	0+00 MH EXISTING								
1+00	124.5	115.66	8.8									
2+00	124.8	115.86	8.9					97-01329	2461 New York			11-24-99
3+00	125.0 125.2	116.06 116.17 116.27	8.9 9.0 8.9	3+54.3								
4+00	125.2	116.36	8.8				18428		2525 Bldg 8 New York			6-3-87
5+00	125.4 125.2	116.56 116.68	8.8 8.5	5+61.1	MH Tap stubbed NE			26029	2549 N. York			8-28-90
6+00	125.5	116.76	8.7									
7+00	125.6 125.7	116.96 117.09 117.19	8.6 8.6 8.5	7+66.4								
8+00	126.0 126.7	117.26 117.46	8.7 9.2	8+98.5	8+12.5 tap 8+72.5 tap		8720 8721		2545-74 New York 2545-70 New York			7-15-83 7-15-83
9+00	126.7 127.6	117.46 117.54 117.64	9.2 10.1 10.0	9+41.2	9+46.2 tap 6" STUB 6" STUB		12-1642-7		2525 Bldg New York 2545 New York (Rid Floor York)			2-4-92 ?
10+00	127.8 127.6	117.76 117.78	10.0 9.8	10+12.7	10" STUB NE 6" STUB SE			93-1952-7	2549 N New York (Mech Equip)			7-27-93
11+	127.5	117.96	9.5	11+01.6								
12+00	126.7 126.5	118.16 118.23	8.5 8.3	12+38.0								
13+00	126.9	118.36	8.5									
14+00	127.7 128.4	118.56 118.67	9.1 9.7	14+55.4	14+30.1 8" STUB N 4" STUB NE		2000-02562 058151		2645 Bldg New York 2645 New York			11-2-100 10-10-96 7-20-76
RELOCATION MAIN D SAN SEWER N ^o 1												
0+00	116.0	109.57	6.4	0+00								
	116.6	109.65	7.0	0+30.6								
1+00	117.2	109.70	7.5									
2+00	117.8 117.6	109.78 109.80	8.0 7.8	2+22.0								
3+00	117.3 116.7	109.90 109.95	7.4 6.8	3+67.0								
4+00	116.8	109.97	6.8									
5+00	116.6	110.05	6.6									
6+00	116.7 116.7	110.13 110.17	6.6 6.5	6+50.6								
7+00	116.9	110.20	6.7									
8+00	117.3	110.28	7.0		8+41.0 tap 8+96.0 tap		11444		1501 N New York			7-12-84
9+00	117.5	110.36	7.1	9+00			7599		1501 N New York			3-4-83
10+00	117.2	110.41	6.8									
11+00	117.5 117.9	110.47 110.49	7.0 7.4	11+39.0								
12+00	117.9 118.0	110.53 110.58	7.4 7.4	12+79.7								

18993 9387 2645 N New York - New Con - Ruitledge - (6" line to run off their own private line ending in a MH)
 Bldg + 158 -> (6" Manhole tap - stubbed west - 8" ran to fall)

2029 2/4/92 2525 N New York Bldg J Sampled Sews - 8+89.5 tap 4" ABS 40
 # 1862 1-18-92 2525 N New York Bldg H Sampled Sews - (Jance) 4" PVC 40 1/4" Fall tap 95.67 E of MH
 # 1861 1-18-92 2525 N New York Bldg H Sampled Sews - (Jance) 4" PVC 40 1/4" Fall tap 95.67 E of MH
 # 1861 3-25-92 2525 N New York Bldg H Sampled Sews - (Jance) 4" PVC 40 1/4" Fall tap 95.67 E of MH (4+49.3)