


SCALE 1"=150'

LATERAL 23 MAIN 17 WAR IND SEWER
BUILT BY: UTILITY CONT. INC.
PROJ. NO DBKL 574106
BOOKED 11-4-75 FROM 279-Y

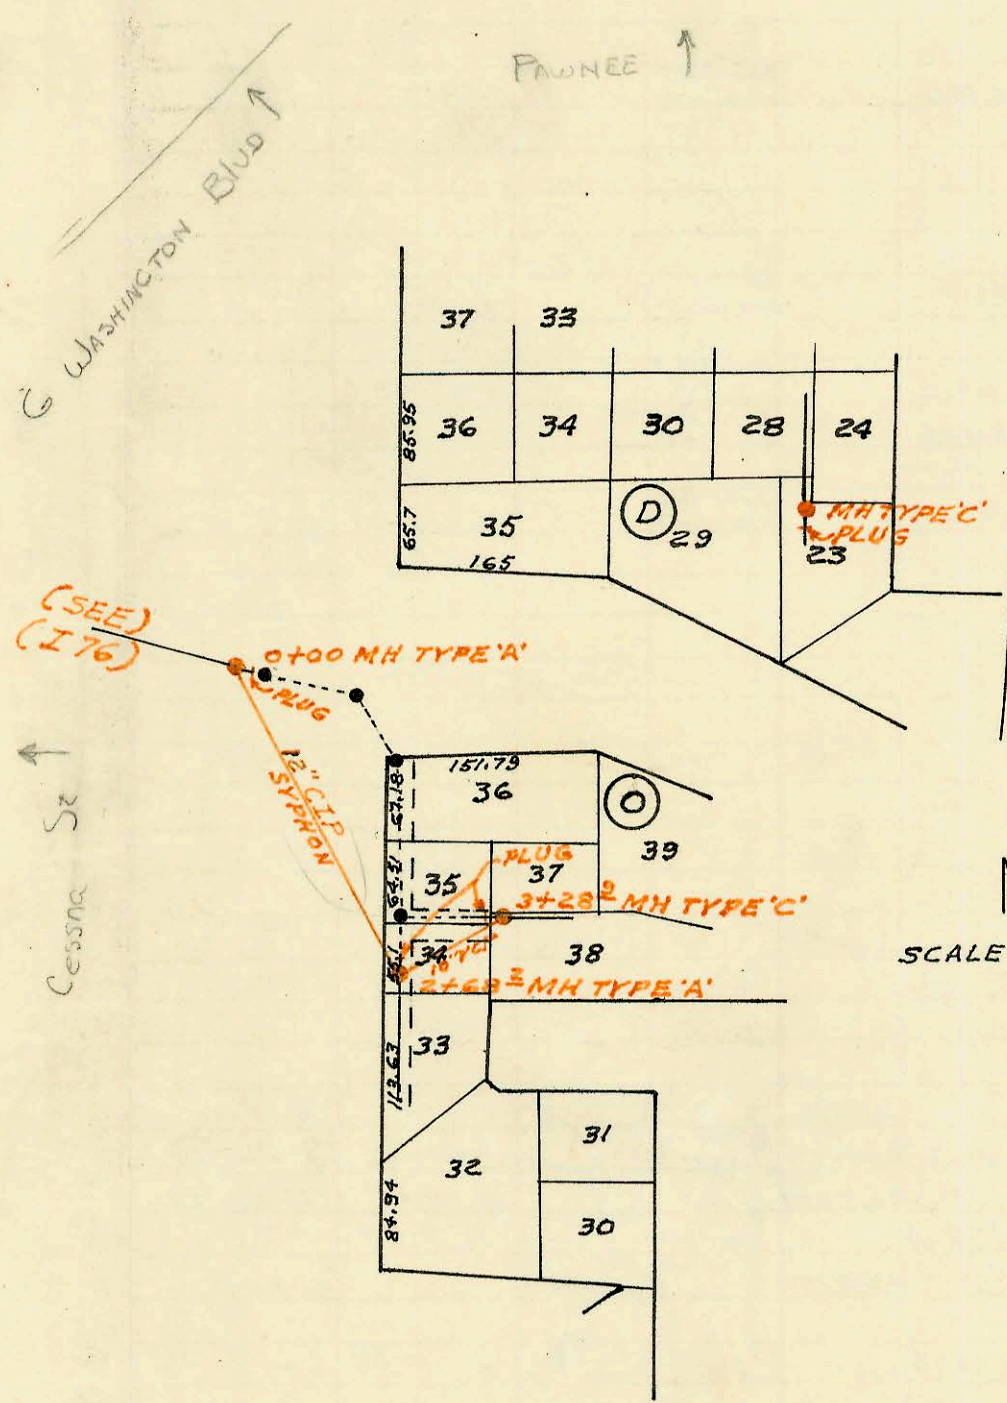

SUPPLEMENT TO PLANEVIEW SEWER
BUILT BY: UTILITY CONT. INC.
PROJ. NO DBKL 575023
BOOKED 11-4-75 FROM 261-Y

LATERAL 14 MAIN 3 WESTLINK SEWER
BUILT BY: UTILITY CONT. INC.
PROJ. NO DBKL 575039
BOOKED 11-11-75 FROM CG 16

SCALE 1"=150'

