



LATERAL 3 MAIN 6 SS #23  
BUILT BY: W.B. CARTER CONST CO.  
PROJ. N<sup>o</sup> DBKL 574058  
BOOKED 11-6-75 FROM 1H81

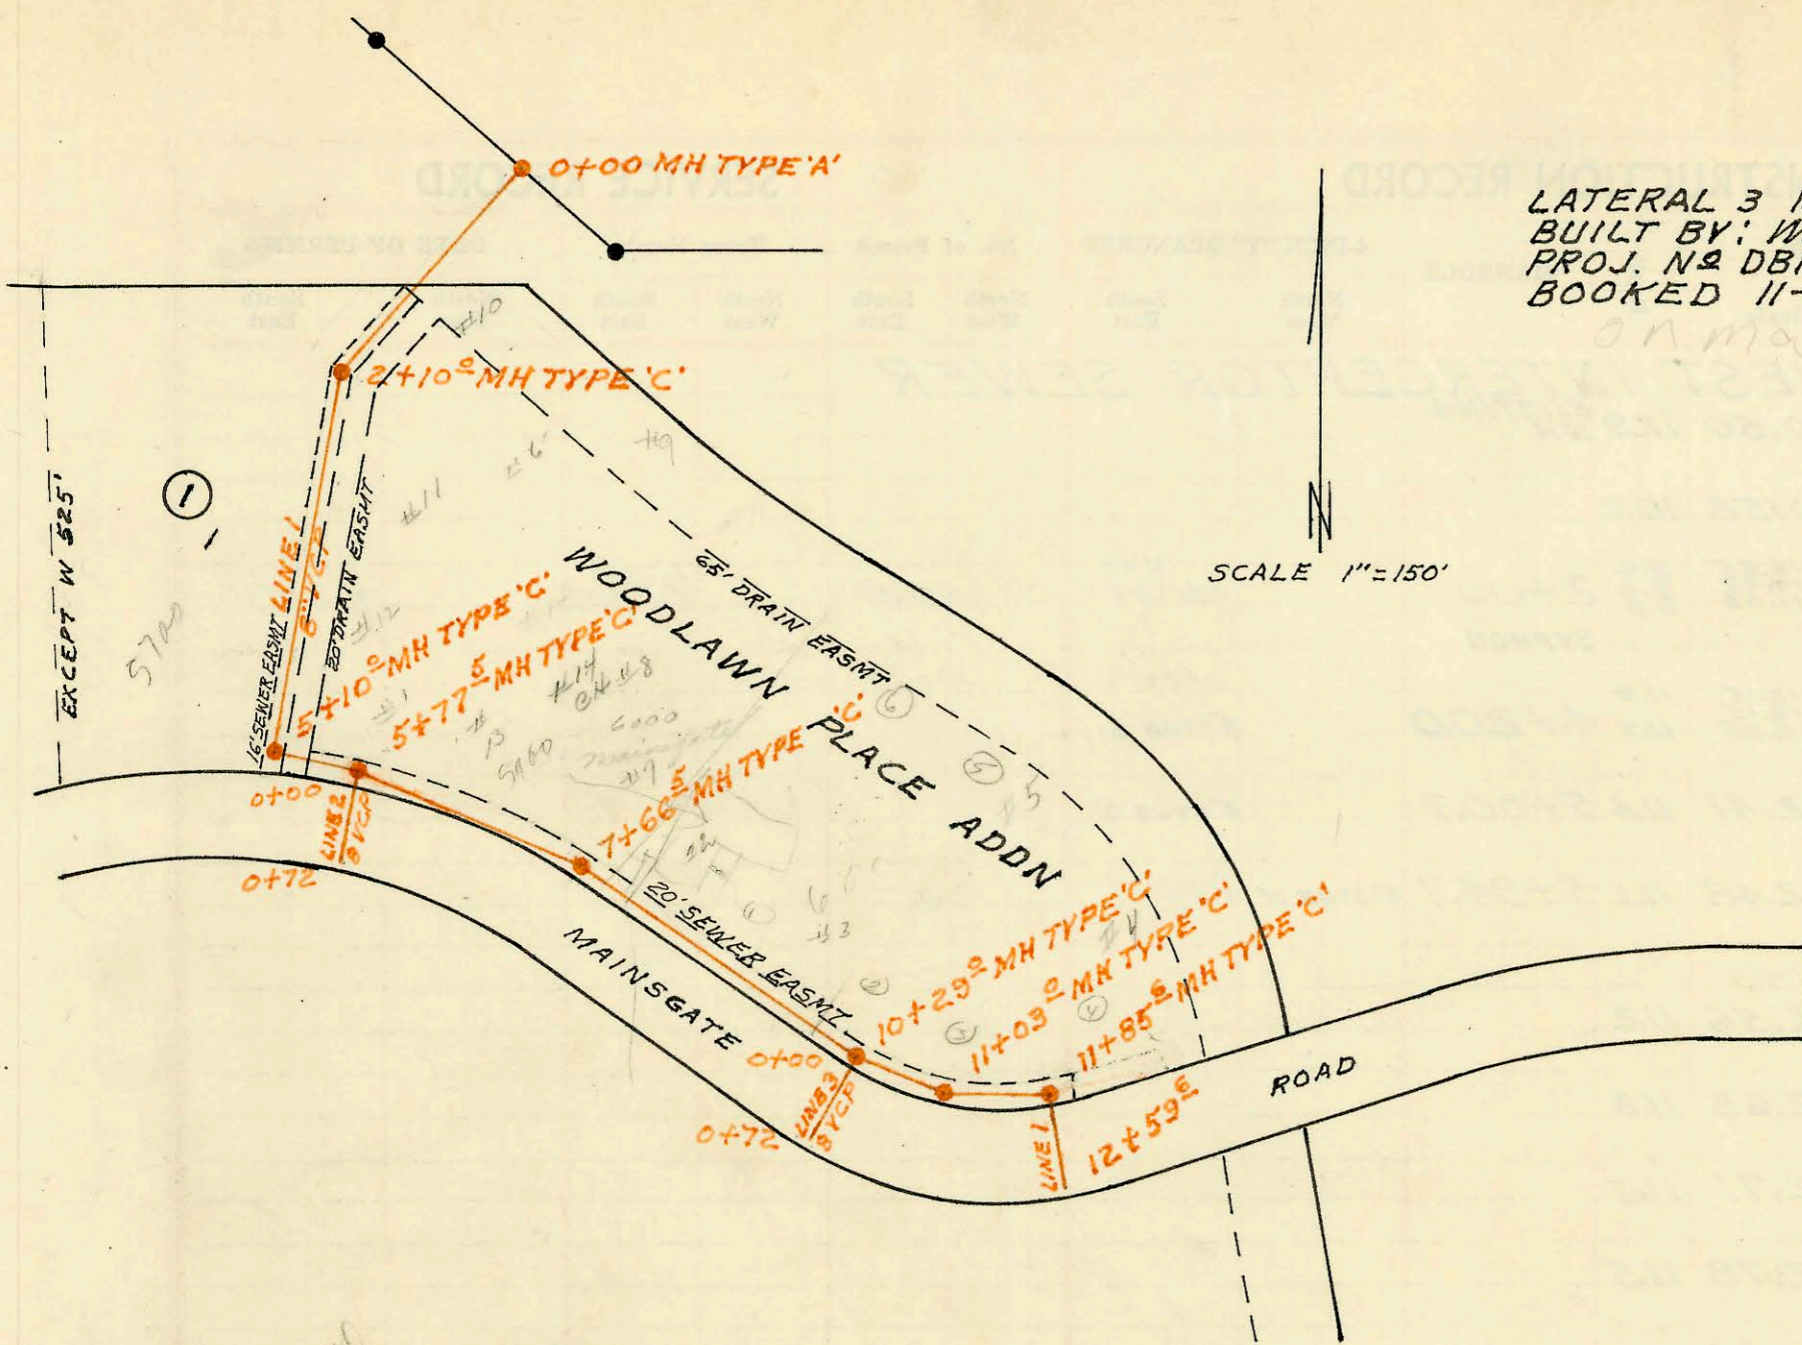

SCALE 1"=150'

*Sixteen woods 2nd adf  
2-9-95  
Do not wrap  
any MC sewer  
permits unless  
checked with Betty*

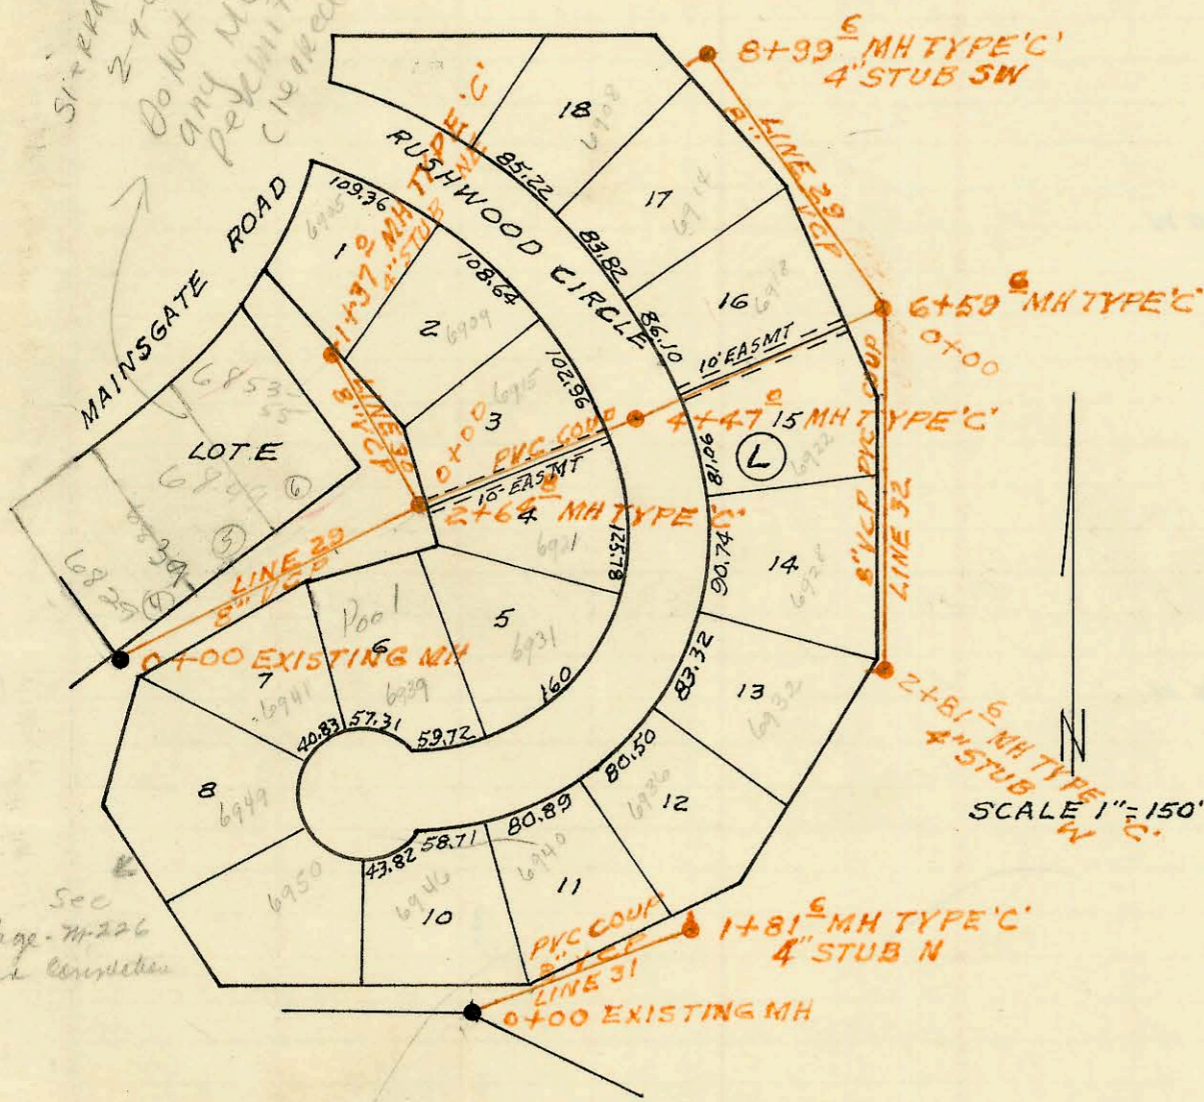

SCALE 1"=150'

LATERAL 4 MAIN 6 SS N<sup>o</sup> 23  
BUILT BY: MID STATES CONST CO.  
PROJ. N<sup>o</sup> DBKL 574072  
BOOKED 11-10-75 FROM 9I

*Sec  
Page M-226  
for connection*

*[Handwritten signature]*

CONSTRUCTION RECORD

SERVICE RECORD

STATION	ELEVATION		Depth	MANHOLE	4-INCH "Y" BRANCHES		No. of Permit		House Number		DATE OF PERMITS	
	Ground	Grade			North West	South East	North West	South East	North West	South East	North West	South East
LATERAL 3 MAIN 6 SAN SEWER No 23												
LINE 1 0+00	174.5	163.83	10.7	0+00								
1+00	174.0	164.23	9.8									
2+00	175.6	164.61	11.0			1+39.0	C66302		6000 #10			5-17-78
	175.6	OUT 164.65 IN 164.75	11.0 10.9	2+10.0		2+35.0	C66303		6000 #9			5-17-78
						2+47.9	C61995		6000 #6			7-12-77
3+00	175.8	165.13	10.7			2+59.0	C66305		6000 #11			5-9-78
4+00	177.2	165.53	11.7									
5+00	178.5	165.93	12.6									
	178.5	OUT 165.98 IN 166.08	12.5 12.4	5+10.0								
	180.3	OUT 166.33 IN 166.43	14.0 13.9	5+77.5								
6+00	179.8	166.52	13.3			6+44.5	C66307		6000 #13			5-15-78
						6+91.1	C66308		6000 #15			5-16-78
7+00	181.1	166.92	14.2									
	182.2	OUT 167.18 IN 167.28	15.0 14.9	7+66.5								
						7+73.1	C61992		6000 #2			7-12-77
8+00	181.0	167.42	13.6									
9+00	180.8	167.82	13.0									
10+00	180.1	168.22	11.9			10+06.0	C61994		6000 #5			7-12-77
	182.0	OUT 168.33 IN 168.43	13.7 13.6	10+29.0								
						10+91.6	C61947		6000 #3			6-29-77
11+00	179.8	168.71	11.1			11+00	C61993		6000 #4			7-12-77
	179.8	OUT 168.72 IN 168.82	11.1 11.0	11+03.0								
						11+76.3	C61660		6000 #1			6-17-77
12+00	180.1	OUT 169.13 IN 169.23	11.0 10.9	11+85.6								
12+00	180.5	169.58	10.9									
12+59.6	180.9	169.52	13.4									
LINE 2												
0+00	178.6	166.43	12.2									
+72	178.6	166.72	11.9									
LINE 3												
0+00	182.0	168.43	13.6									
+72	181.2	168.72	13.3									
LATERAL 4 MAIN 6 SAN SEWER No 23												
LINE 29 0+00	197.5	185.04	12.5	0+00 MK EXISTING		0+33.5	16806		6829			8-7-86
						0+85 TAP			6839			7-25-77
1+00	199.2	185.44	13.8			TAP 1+14.8	16807		6839			7-25-77
						TAP 1+84.8			6939			11-3-86
2+00	200.9	185.84	15.1			1+12.0 TAP	17247		6931			12-7-78
	201.5	OUT 186.10 IN 186.20	15.4 15.3	2+64.8		TAP 2+54.4	24927		6931			
3+00	201.7	186.34	15.4			3+49.8	3+46.8	C66906	6915			6-19-78
								C66905	6918			6-19-78
4+00	202.8	186.74	16.1									
	202.2	186.92	15.3	4+47.0								
5+00	204.1	187.14	17.0			5+47		C60019	6918			2-22-77
6+00	205.4	187.54	17.9									
	206.0	OUT 187.78 IN 187.88	18.2 18.1	6+59.6								
7+00	205.3	188.04	17.3									
8+00	203.9	188.44	15.5			8+43.8		C69668	6914			12-4-78
	202.5	188.84	13.7	8+99.6		4" STUB SW		C60118	6908			2/28/77
LINE 30												
0+00	201.5	186.20	15.3	0+00 = 2+64.8 LINE 29								
1+00	199.4	186.60	12.8									
	198.5	186.74	11.8	1+37.0		4" STUB NE	9114757	C61190	6853-55			7-15-94
						0+78.7		C61191	6905			5-27-77
LINE 31												
0+00	205.7	198.54	7.2	0+00 MK EXISTING		0+7.7		C62051	6946			7-14-77
						1+58.6		C59636	6970			1-31-77
1+00	208.5	198.94	9.6									
	209.0	199.26	9.7	1+81.6		4" STUB N		C51679	6936			1-31-77
LINE 32												
0+00	206.0	189.88	16.1	0+00 = 6+59.6 LINE 29		0+57		C73566	6922			8-13-79
1+00	207.1	191.88	15.2									
2+00	208.2	193.88	14.3			3+71.1		C3938	6928			10-27-77
	208.9	195.48	13.4	2+81.6		4" STUB W		C62431	6922			10-10-77

# 21163 7-27-88 - 6000 E. Mainsgate #100 - Repair.