



SERVICE RECORD CONSTRUCTION RECORD

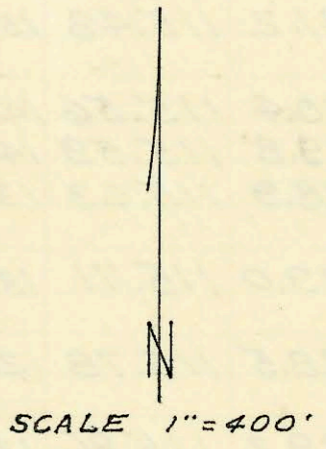

MAIN 5 SOUTHWEST INTERCEPTOR SEWER
 (PART I)
 BUILT BY: UTILITY CONT. INC.
 PROJ. NO DBKM 572018
 BOOKED 12-3-75 FROM G-4

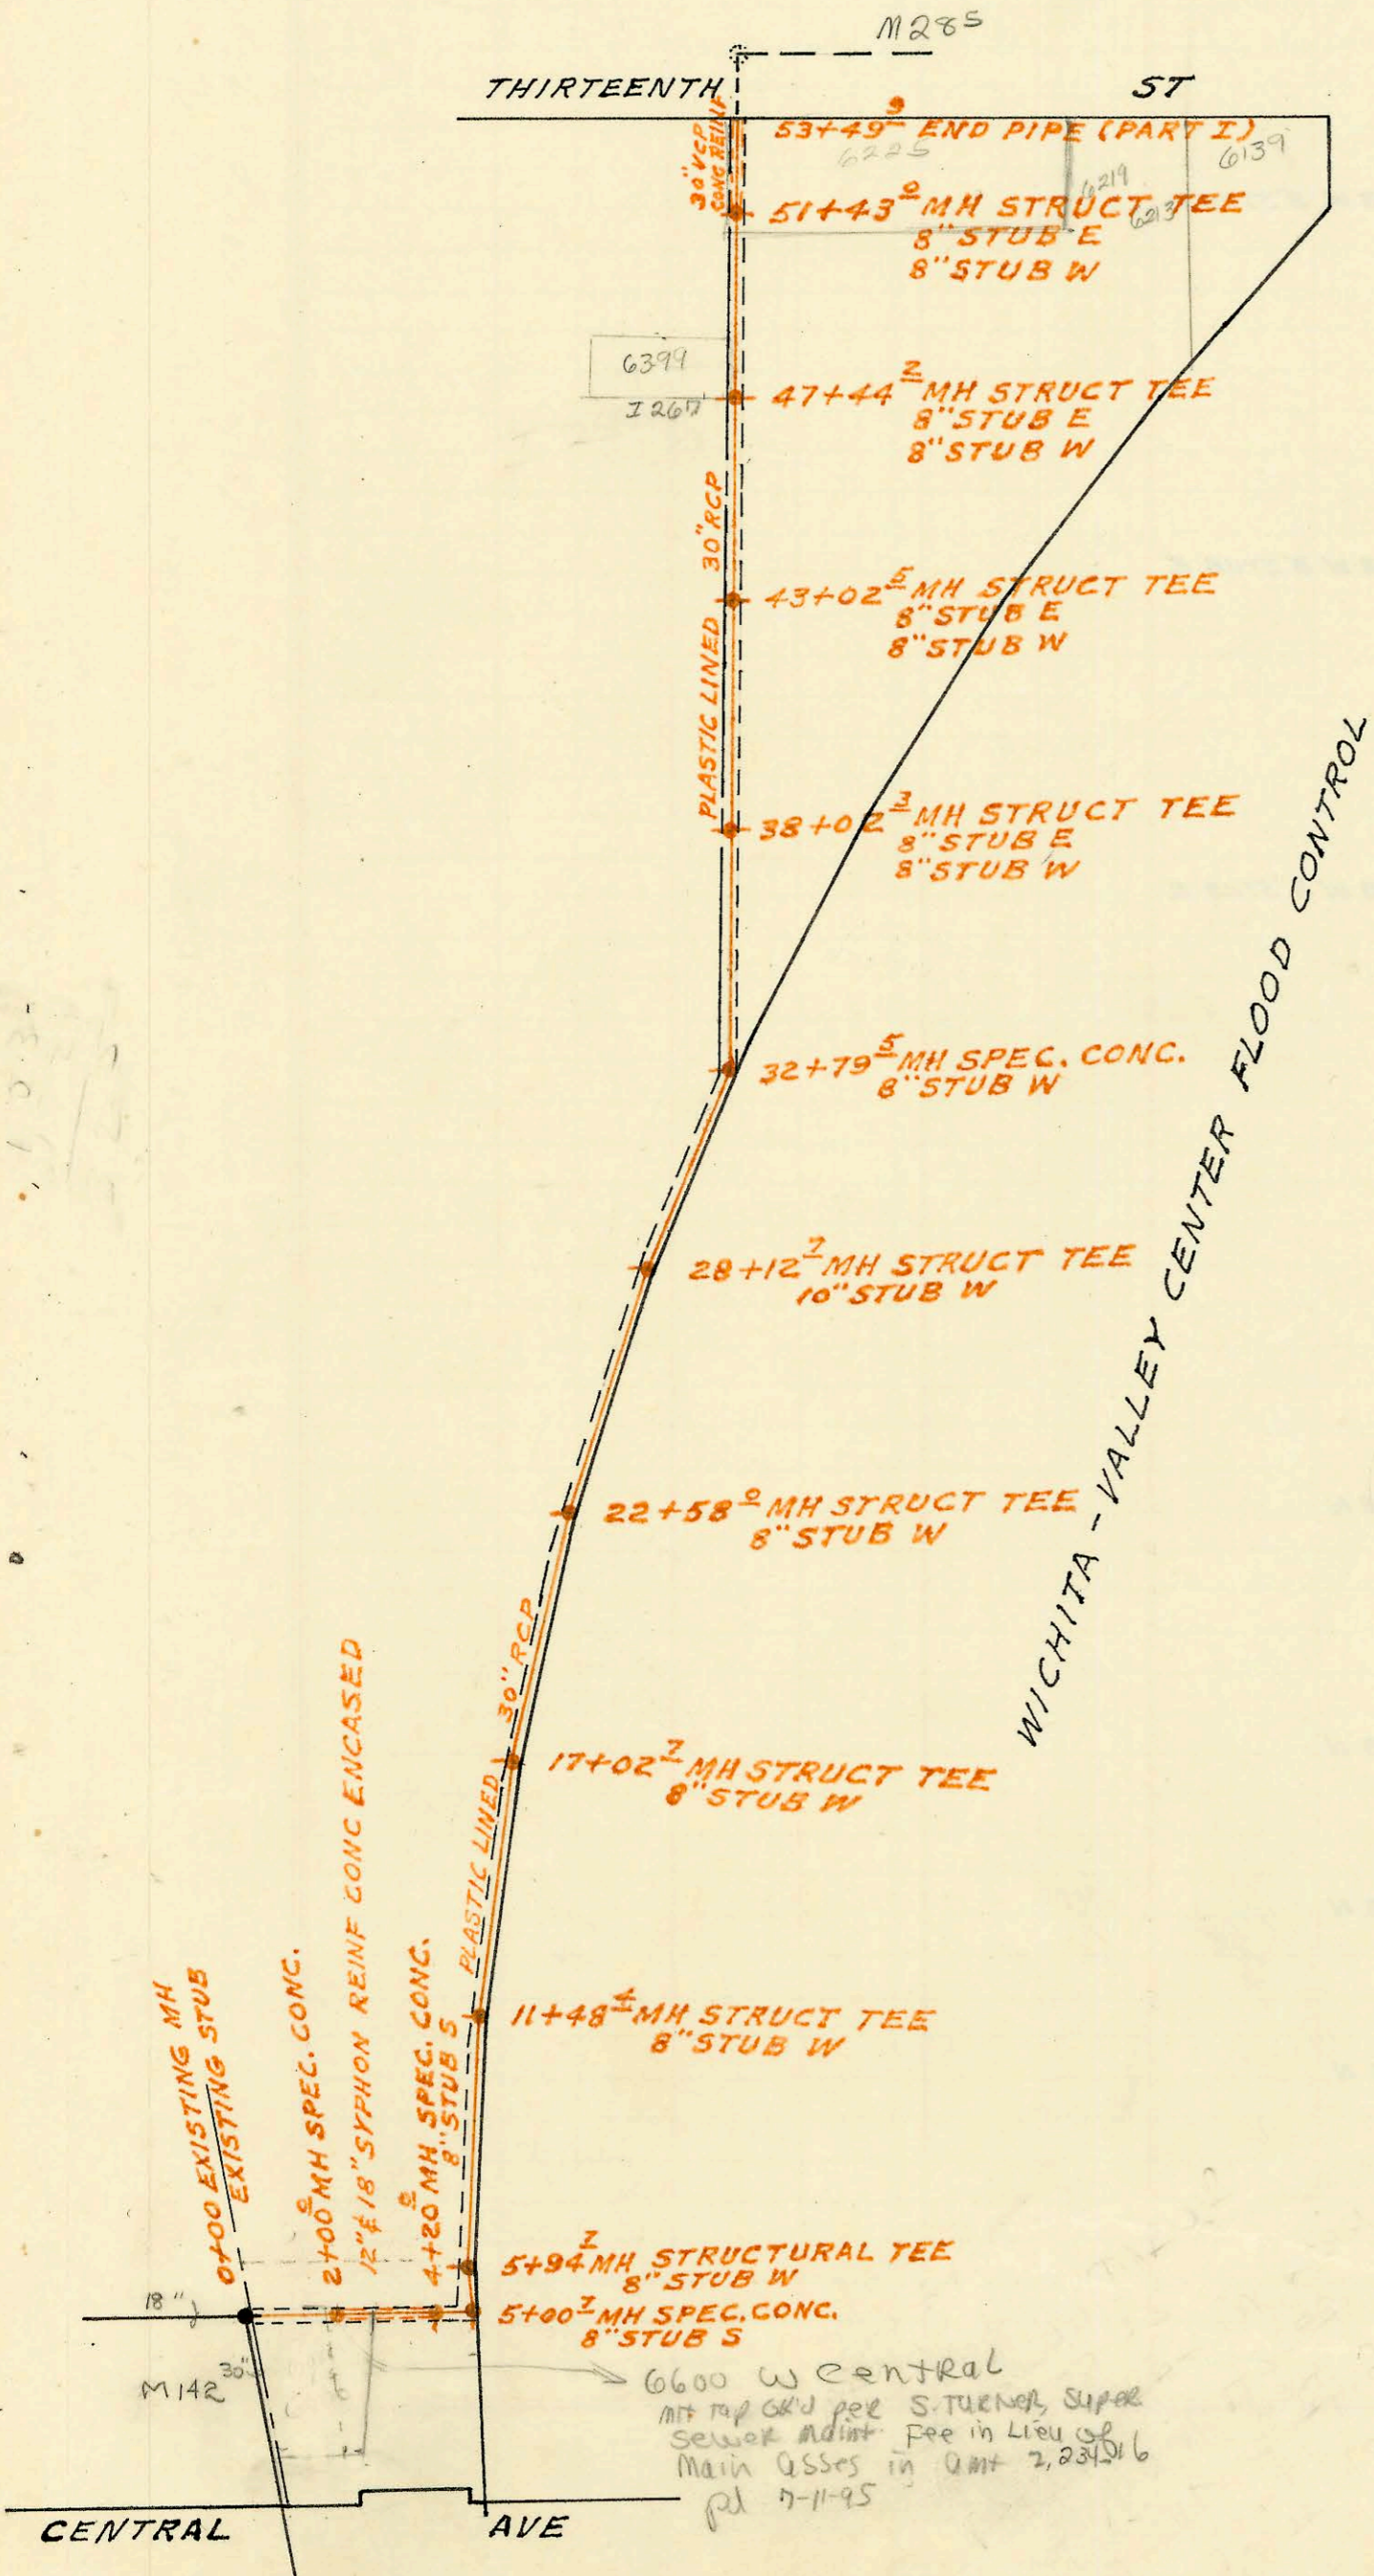