


SAN SEWER CROSSING 21ST
BUILT BY: UTILITY CONTR. INC
PROJ. NO DBKW 705057
BOOKED 3-25-76 FROM CG 18
TIES TO S END OF PIPE:
3" STL PIPE TEXACO PIPE LINE MARKER #77 39.0 E
FENCE SOUTH 66.2 E
FENCE E&W 5.0 N

SCALE 1"=400'

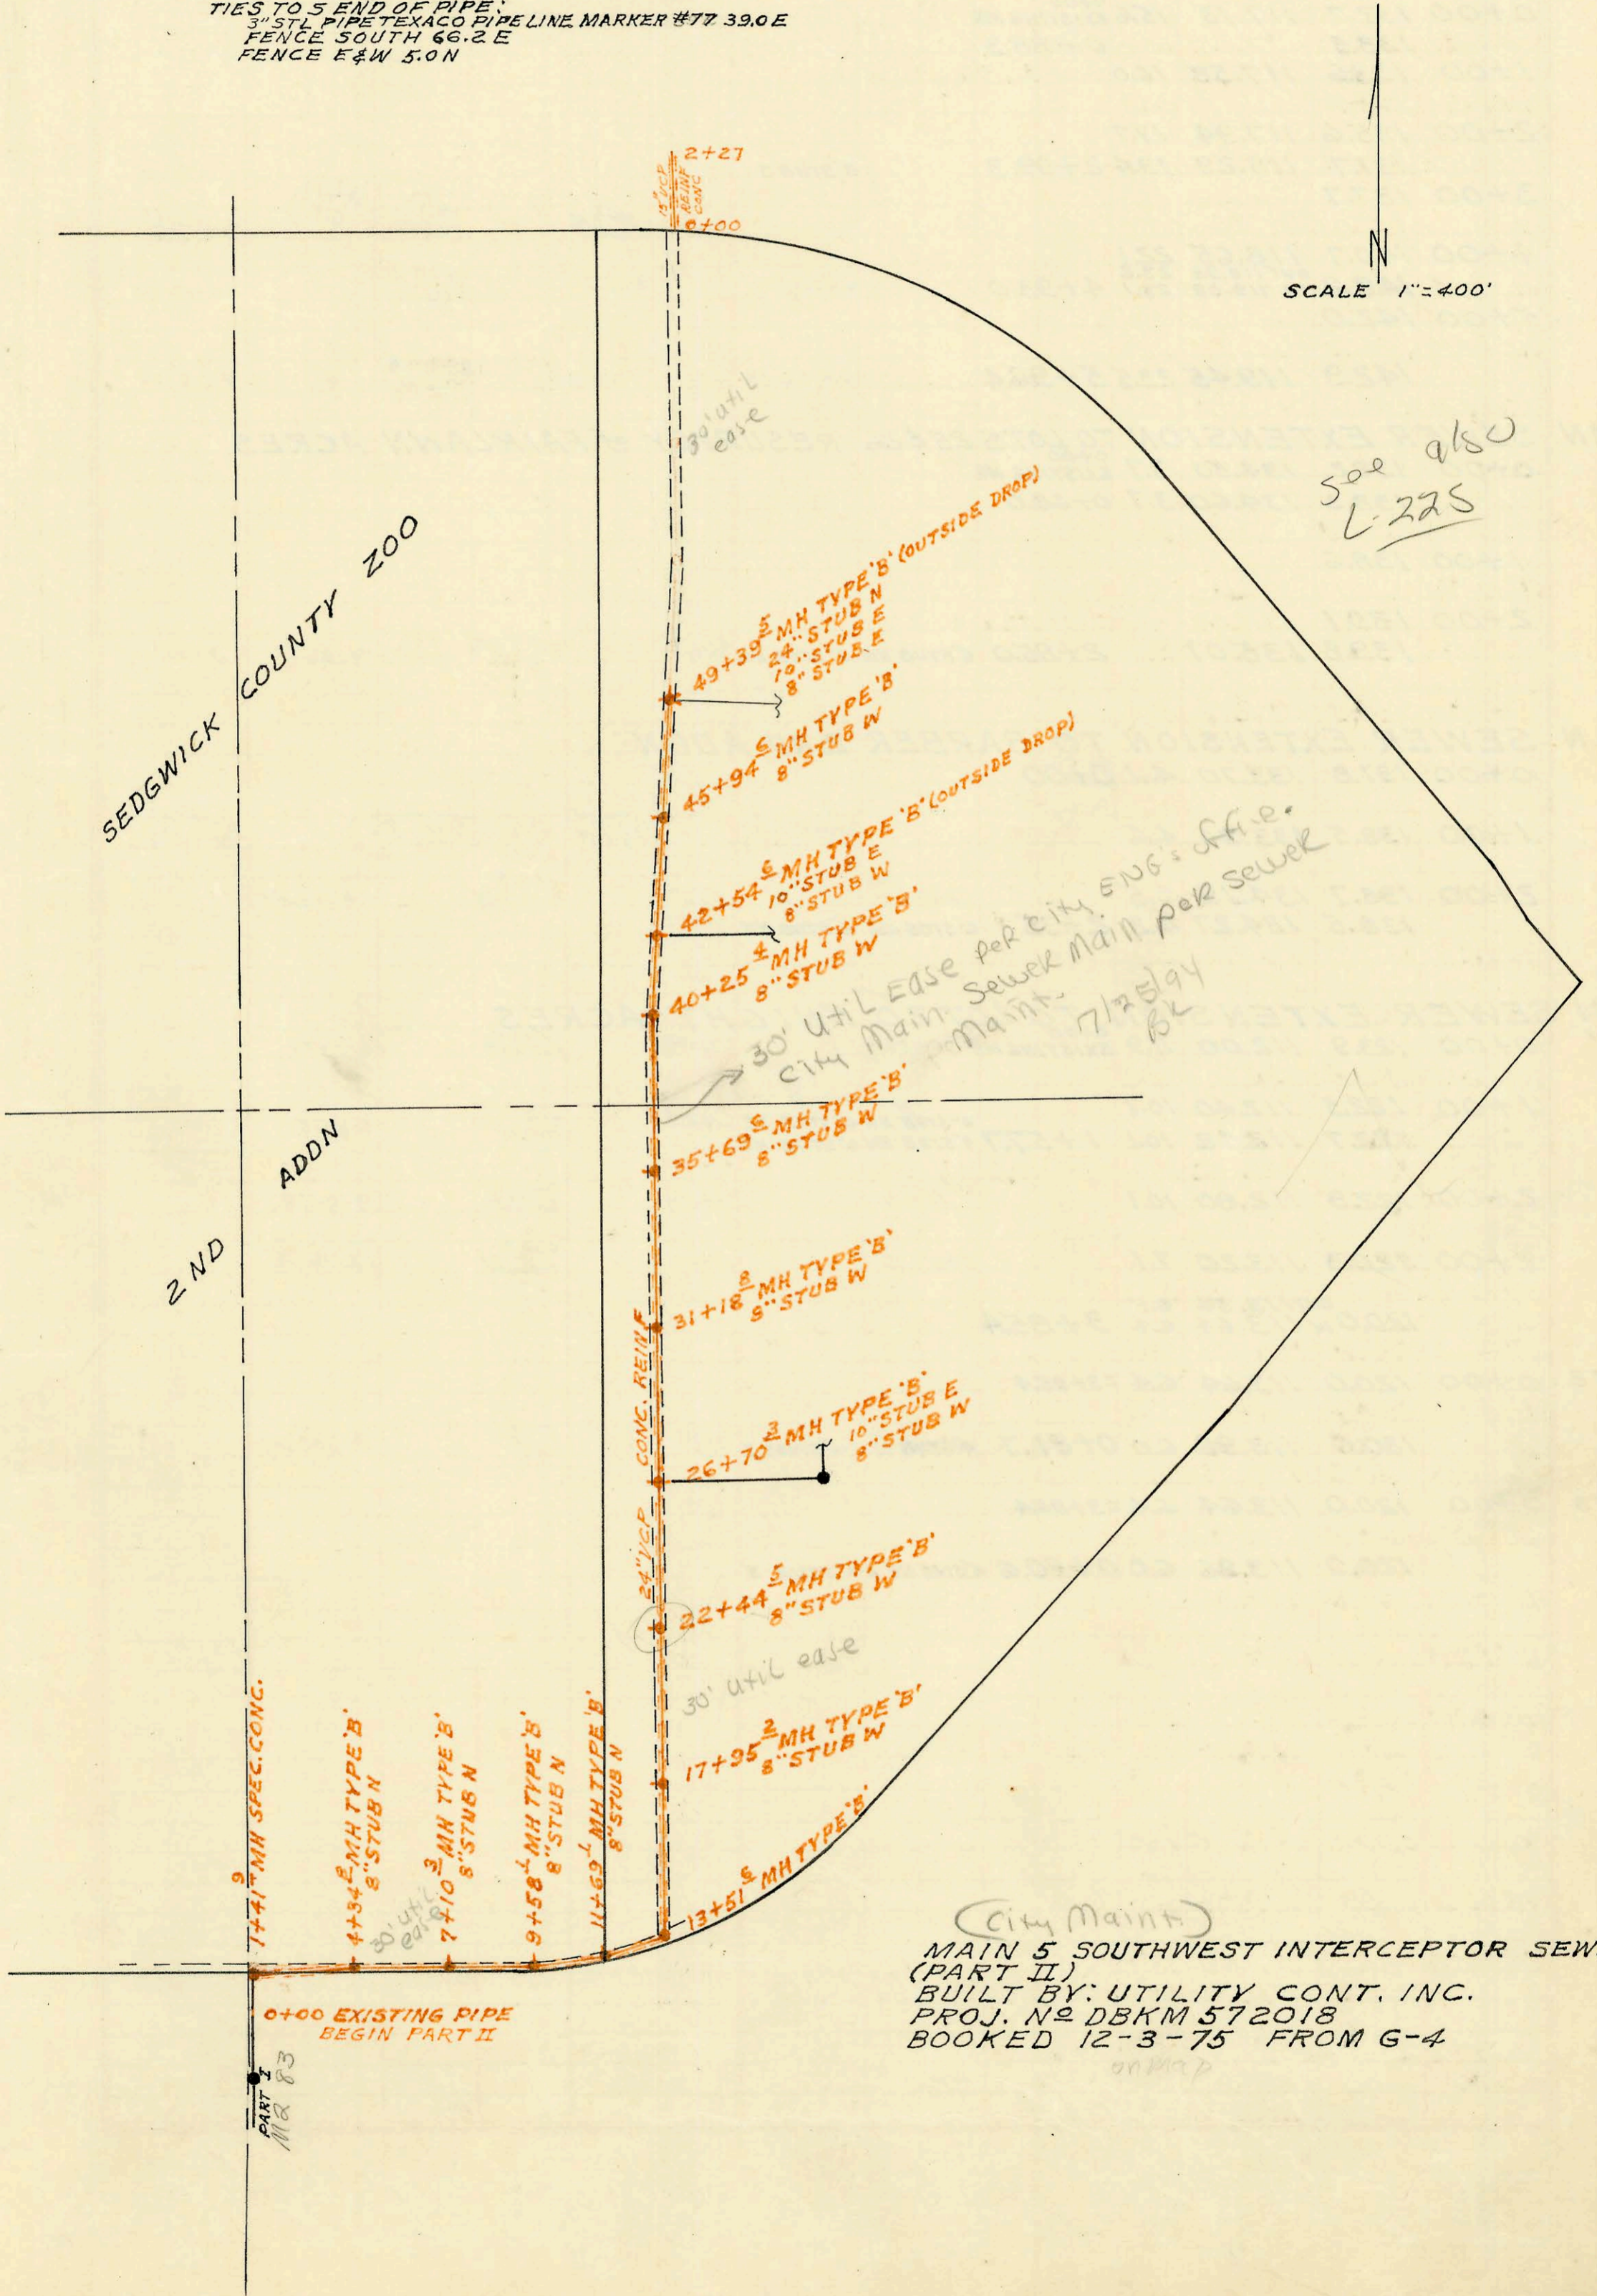

SEDGWICK COUNTY ZOO

2ND ADDN

See also
L-225

30' UTIL EASE PER CITY ENG: Aff.e.
CITY Maint. Sewer Main per sewer
7/25/94
BL

(City Maint)
MAIN 5 SOUTHWEST INTERCEPTOR SEWER
(PART II)
BUILT BY: UTILITY CONTR. INC.
PROJ. NO DBKM 572018
BOOKED 12-3-75 FROM G-4

0+00 EXISTING PIPE
BEGIN PART II

PART I
MA 83

