



LATERAL II MAIN 3 WESTLINK SEWER
 BUILT BY: UTILITY CONT. INC.
 PROJ. N° DBKL 574035
 BOOKED 2-17-76 FROM 9E

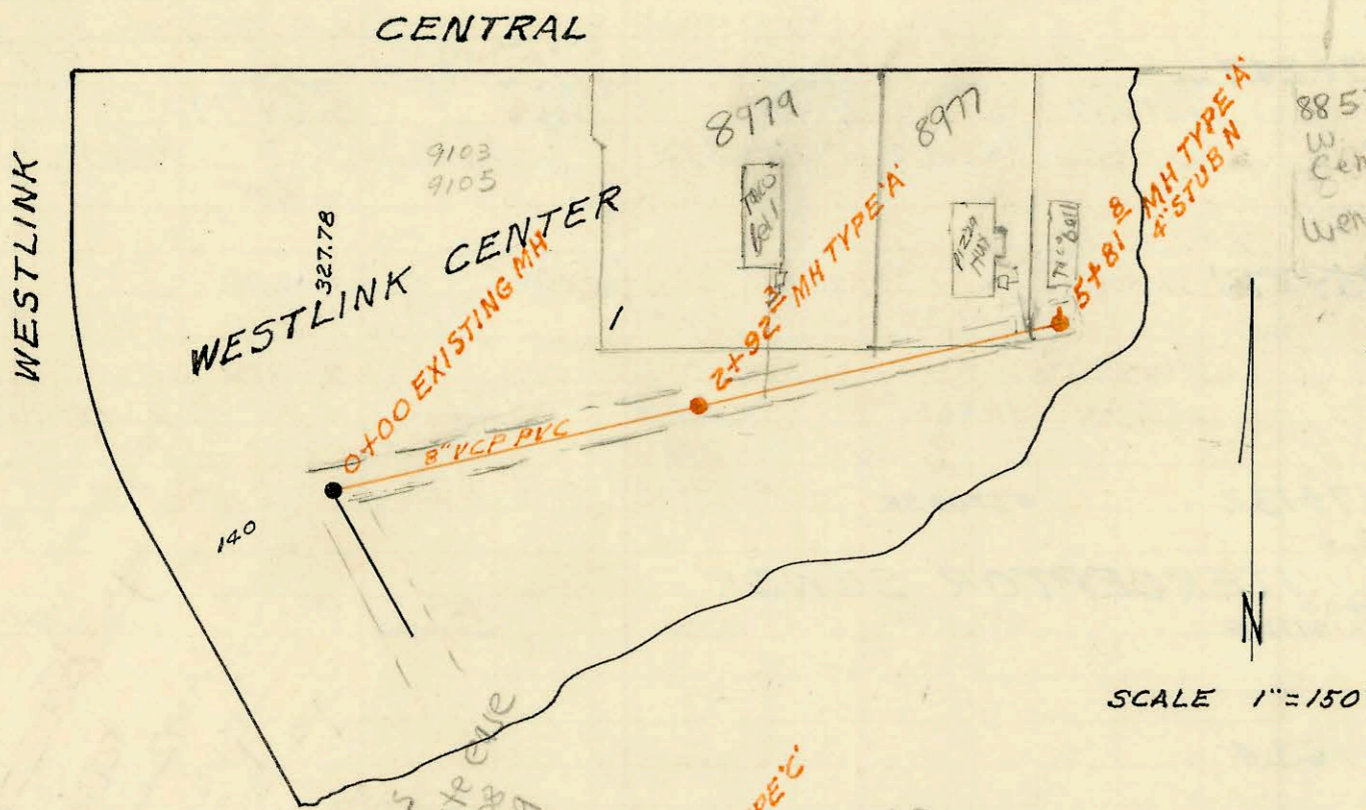

SANITARY SEWER EXTENSION TO
 WESTLINK CENTER LOT 1
 BUILT BY: MID STATES CONST. CO.
 PROJ. N° DBKW 705056
 BOOKED 2-19-76 FROM CLG 06

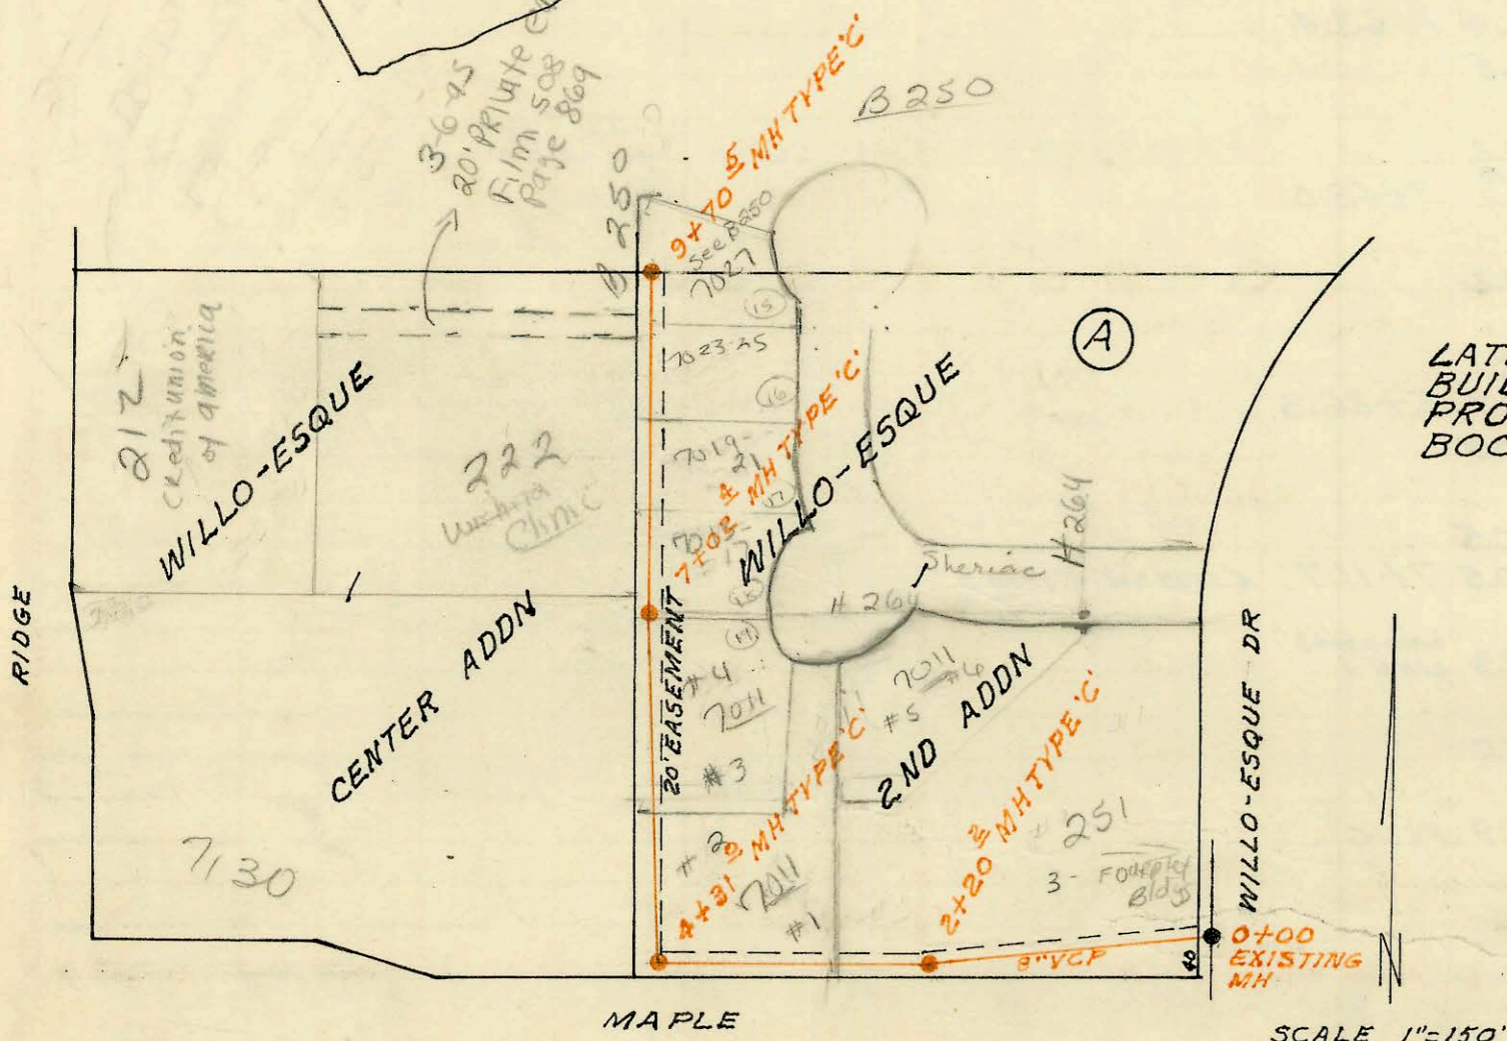

LATERAL I MAIN 6 SOUTHWEST INTERC
 BUILT BY: W.B. CARTER CONST. CO.
 PROJ. N° DBKL 573001
 BOOKED 2-25-76 FROM G4

CONSTRUCTION RECORD

SERVICE RECORD

STATION	ELEVATION		Depth	MANHOLE	4-INCH "Y" BRANCHES		No. of Permit		House Number		DATE OF PERMITS	
	Ground	Grade			North West	South East	North West	South East	North West	South East	North West	South East
LATERAL II MAIN 3 WESTLINK SEWER												
LINE 1 0+00	152.3	142.57	9.7	0+00								
1+00	152.7	143.47	9.2									
2+00	153.2	144.37	8.4		1+37.9		C57914		1617 Murray			9-28-76
	153.3	144.82	8.5	2+50.2		2+26.3	C57915		1623 Murray			9-28-76
3+00	153.2	145.20	8.0		cap	3+25.9	C53876		1629 Murray			2/23/76
4+00	153.3	145.97	7.3									
5+00	152.9	146.74	6.2			4+34.3	C58598		1635 Murray			11-10-76
	152.7	146.81	5.9	5+11.7			C58598		1639 Murray			10-20-76
LINE 2												
0+00	152.3	142.67	9.6	0+00 = 0+00 LINE 1								
1+00	153.1	143.07	10.0									
	153.2	143.11	10.1	1+12.3								
SANITARY SEWER EXT TO WESTLINK CENTER LOT 1												
0+00	143.5	135.56	7.9	0+00 EXISTING								
1+00	143.2	135.96	7.2		1+01		C70498		9103 W. Central			3-7-79
2+00	143.0	136.36	6.6									
	142.5	136.72	5.8	2+92.3					Jaco Bell 8979 Central - see below			
3+00	142.4	136.76	5.6		4" SCH 40 CITY Repair 5+15.8 Predco		2001-00573		8977 W Central (see below)			3-15-01
4+00	141.3	137.16	4.1		seal off 5+13.8		2001-00175 C53543		8977 W Central (see below)			1-25-01
	142.5	137.56	4.9				28171 C54569		8944 W Central (see below)			2-3-76
	143.0	137.88	5.1	5+81.8 4" STUB N			23499		8971 W Central			5-18-84
												7-1-76
												7-7-89
LATERAL I MAIN 6 SOUTHWEST INTERCEPTOR SEWER												
0+00	134.0	121.36	12.6	0+00 EXISTING								
1+00	135.3	121.96	13.3		tap 0+77.3		54126		251 S. #1			3-18-76
					tap 0+60.0		54127		Willa Lane			11-13-85
2+00	136.2	122.56	13.6									3-10-76
	136.4	122.67	13.7	2+20.2								
	136.4	123.18	13.2		2+59.3		C54128		251 N. #3			3-10-76
3+00	137.2	123.65	13.6									
4+00	137.5	124.25	13.3									
	138.2	124.44	13.8	4+31.0					7011 Sherice			3-25-86
	138.2	124.54	13.7									
5+00	138.7	124.95	13.8						7011 Sherice			3-25-86
									7011 Sherice			3-25-86
6+00	139.5	125.55	14.0									
7+00	140.0	126.15	13.8		6+91.0		15256		7130 Maple			12-9-85
	140.0	126.15	13.8	7+02.4	6+28.8	7+41.4	2001-00573 C53543		227 S. #4			5-12-88
									7015-17 Sherice			10-28-77
												1-9-89
8+00	141.0	126.75	14.3		4" SCH 35							
					tap 260' s. of a mt.		92 11834-7		7019-21 Sherice			7-7-92
9+00	142.8	127.35	15.5		4" PVC 40	9+24.5	955287		212 S. #1			
	144.0	127.78	16.2	9+70.5					7023-25 W Sherice		4-11-87	12-4-90

2104-00409 5/2/80 - 8979 W Central Singletary - 4" sch 40, 51' East mt. (tap) 4" Predco, shalins, (2) 45V, (1) 45H, (1) twin 40
 2001-00573 - 3/15/01 - 8977 W Central - McCullough - 4" sch 40 City Main Repair - Predco - 66' w of mt 5+81.8 - 1 grease trap -
 TWIN CO, 1V22, 5H22, 1V 45, 1 4" 4" - wye ties sewer + grease trap into service line to main (after trap)
 94-15701 7 9/29/84 8853 W Central (Wendy's) - 4" sch 40 PVC