



SCALE 1"=150'

LATERAL 10 MAIN 23 SAN SEWER N<sup>o</sup>22  
 BUILT BY: WOODSIDE CONST. CO.  
 PROJ. N<sup>o</sup> DBKL 575071  
 BOOKED 4-22-76 FROM SSJK#5

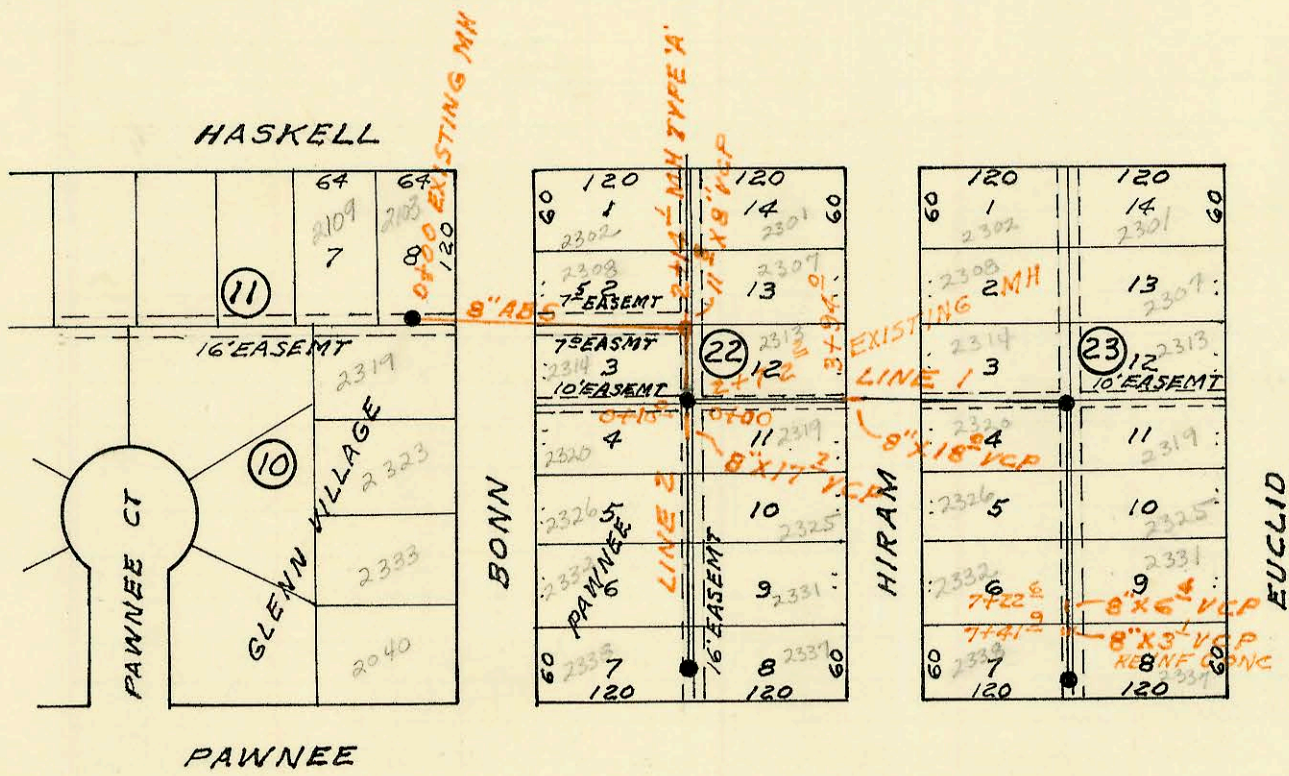

SCALE 1"=150'

RECONSTRUCTION OF PORTION  
 LATERAL 1 MAIN 3 SAN SEWER N<sup>o</sup>22  
 BUILT BY: MID STATES CONST. CO.  
 PROJ. N<sup>o</sup> DBKL 575022  
 BOOKED 4-27-76 FROM AR 81

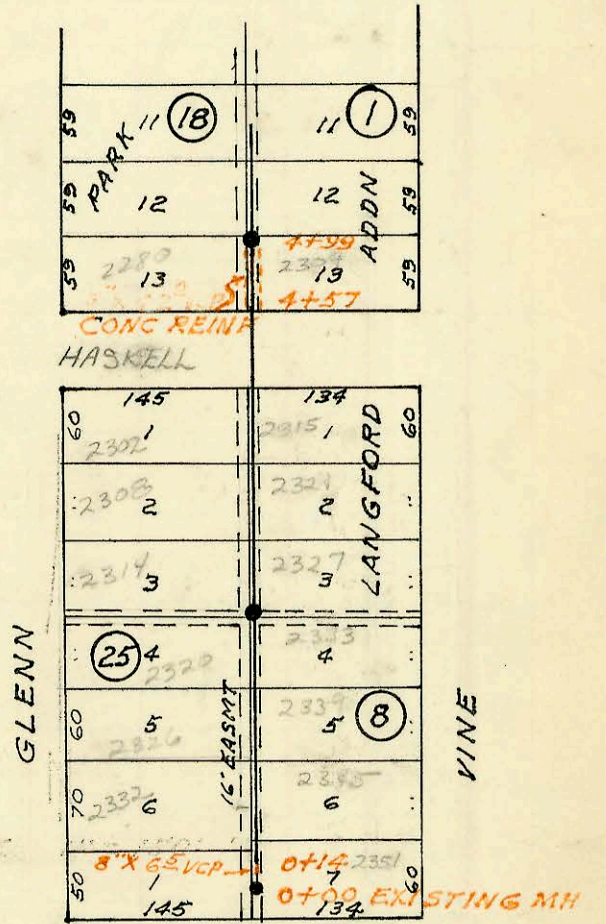

See H-52 for uye conn

CONSTRUCTION RECORD

SERVICE RECORD

STATION	ELEVATION		Depth	MANHOLE	4-INCH "Y" BRANCHES		No. of Permit		House Number		DATE OF PERMITS	
	Ground	Grade			North West	South East	North West	South East	North West	South East	North West	South East
LATERAL 10 MAIN 23 SAN SEWER N <sup>o</sup> 22												
0+00	100.4	91.47	8.9	EXISTING	0+23.8		C61014		3350 S. M. Comas			
1+00	100.5	91.87	8.6		1+52.8	0+84	C59724	C62591	3344 S. M. Comas	3345 S. Kessler	2-2-77	8-15-77
2+00	99.8	92.27	7.5		1+55.8	1+88	C59723	C64182	3338 S. M. Comas	3339 S. Kessler	2-2-77	11-23-77
		92.67	7.0	2+98.4	2+35.8	2+09.8	C59722	C60444	3332 S. M. Comas	3333 S. Kessler	2-2-77	3-21-77
	99.7				3+65.7	2+66.5	C59721	C62009	3320 S. M. Comas	3327 S. Kessler	2-2-77	7-13-77
					3+95.7		C61015		3314 S. M. Comas		2-2-77	
3+00	99.7	92.68	7.0		4+96.7	3+62.3	C59720	C63704	3308 S. M. Comas	3321 S. Kessler	5-3-77	11-7-77
4+00	100.1	93.07	7.0									
5+00	100.2	93.47	6.7		5+43.2	5+46.2	C58485	C56151	3302 S. M. Comas	3303 S. Kessler	11-4-76	6-25-76
	100.2	93.85	6.4	5+95.6								
6+00	100.2	93.87	6.3									
7+00	100.7	94.27	6.4		6+95.6	6+93.1	C57904	C57899	3250 S. M. Comas	3702 W. Kessler	11-2-76	9-28-76
					7+23.5	7+43.5	C5903	C58486	3244 S. M. Comas	3245 S. Kessler	9-28-76	11-4-76
8+00	100.8	94.67	6.1		7+85.0		C57902		3238 S. M. Comas		9-28-76	
	101.2	95.05	6.2	8+95.0	8+48.8	8+58	C57901	C57898	3233 S. M. Comas	3239 S. Kessler	9-28-76	9-28-76
						8+67		C58855	3226 S. McLennan	3233 S. Kessler		11-29-76
9+00	101.2	95.07	6.1		9+48.7		C57900				9-28-76	
10+00	101.5	95.47	6.0		10+07	10+01.6	C57127	C56146	3220 S. McLennan	3227 S. Kessler	8-9-76	6-25-76
					10+75.1	10+66.7	C56150	C56145	3214 S. M. Comas	3233 S. Kessler	6-25-76	6-25-76
11+00	101.4	95.87	5.5		11+32.0		C56149		3208 S. McLennan		6-25-76	
	101.7	96.19	5.5	11+81.0	4" STUB NE 4" STUB NW	11+45.8	C56148	C56144	3202 S. M. Comas	3209 S. Kessler	6-25-76	6-25-76
								C57899	3201 W. Kessler	31st. S.	9-28-76	
RECONSTRUCTION of PORTION of LATERAL 1 MAIN 3 SAN SEWER N <sup>o</sup> 22												
LINE 1 0+00	100.7	91.03	9.7									
1+00	100.6	91.21	9.4									
2+00	101.1	91.39	9.7									
	100.7	91.42	9.3	2+14.1								
2+72.2	101.0	91.62	9.4									
3+49.0	101.6	91.91	9.7									
4+12.0	100.0	91.95	8.1									
7+22.6	101.0	92.71	8.3									
7+29.0	101.0	92.72	8.3		7+29 W							
7+41.9	101.0	92.74	8.3									
7+45.0	101.0	92.75	8.3									
LINE 2 0+00	101.0	92.36	8.6									
0+10	101.0	92.38	8.6									
0+27.7	101.0	92.42	8.6									
LINE 3 0+00	101.6	94.30	7.3									
0+14	101.7	94.27	7.4			0+14 E						
0+20.5	101.7	94.25	7.5									
4+57.0	102.1	94.46	7.6									
4+99.0	102.1	94.55	7.6									

C63021 - 3326 S. McLennan - 9-12-77 (2+67.3)