
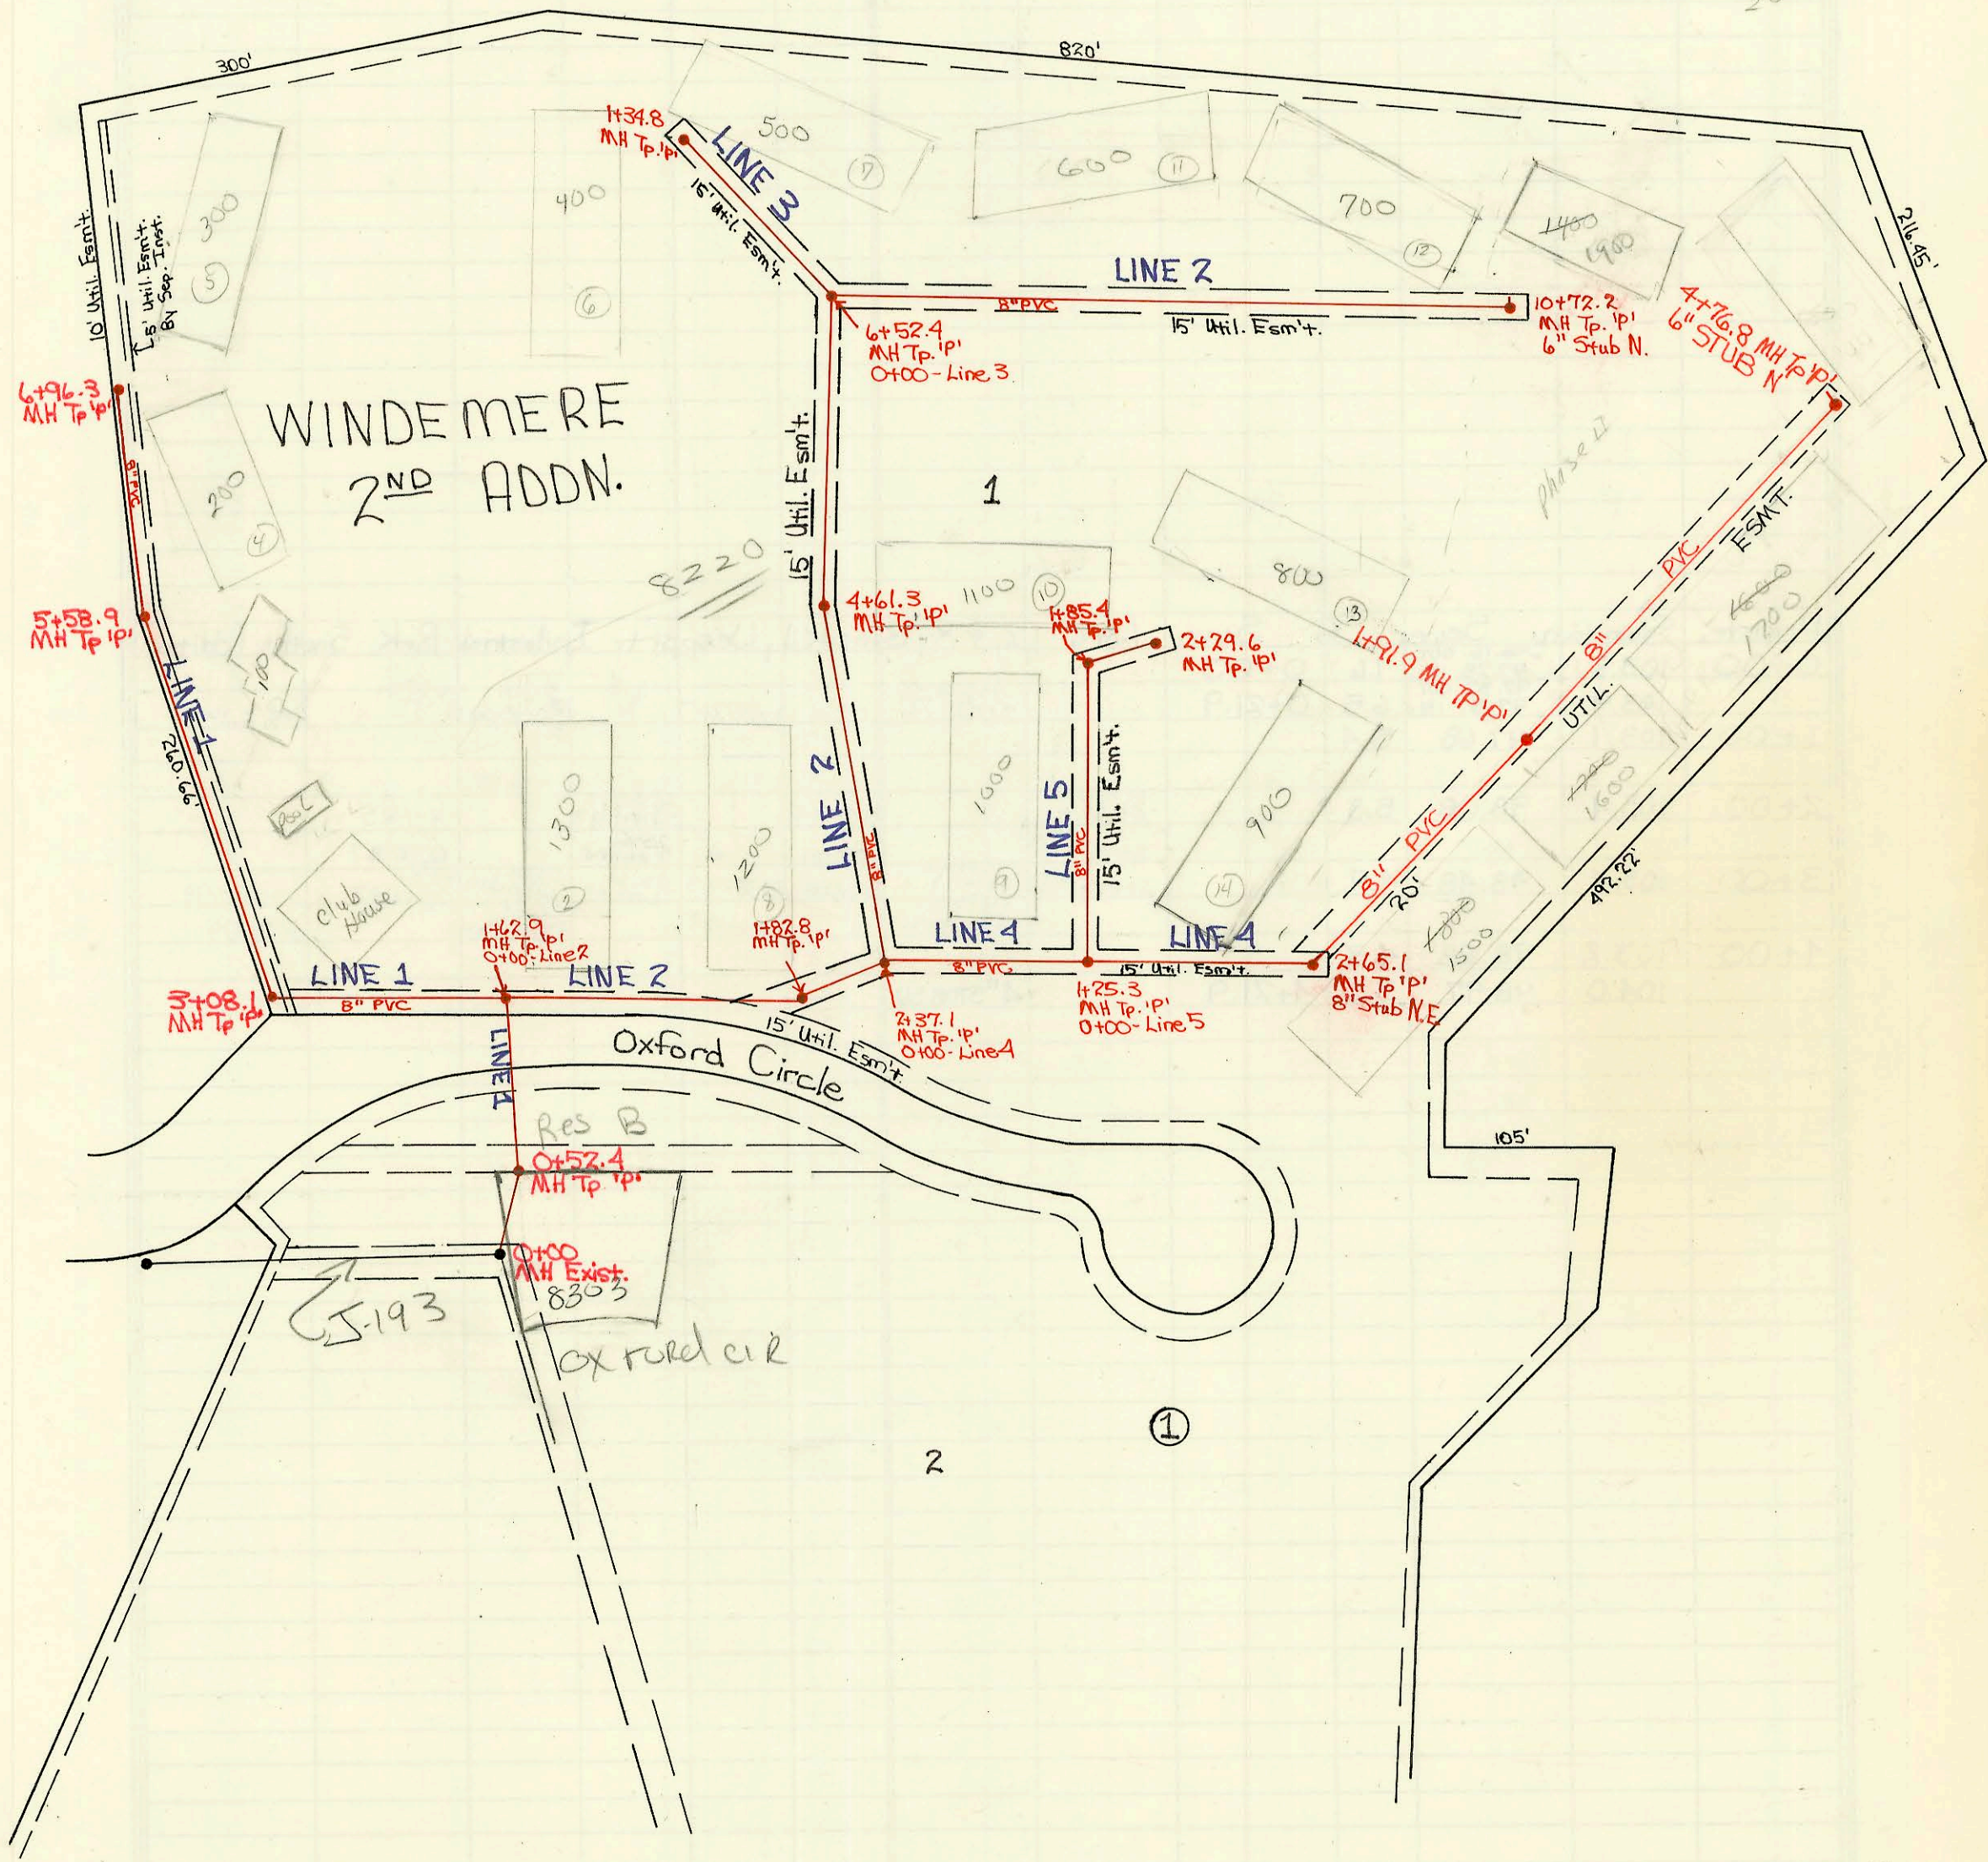


PRIVATE SANITARY SEWER TO SERVE LOT 1, BLK. 1, WINDEMERE 2ND ADDITION  
 PRIVATE PROJECT NO. 270 PPS (607861)  
 BUILT BY L.A. KNEBLER  
 BOOKED 11-4-91 FROM AS BUILTS

PRIVATE SANITARY SEWER EXTENSION TO SERVE PART OF  
 LOT 1, BLOCK 1, WINDEMERE SECOND ADDITION  
 PRIV. PROJ. NO. 426 PPS (607861)  
 BUILT BY W. B. CARTER CONSTRUCTION CO.  
 BOOKED 2-1-96 FROM AS BUILTS

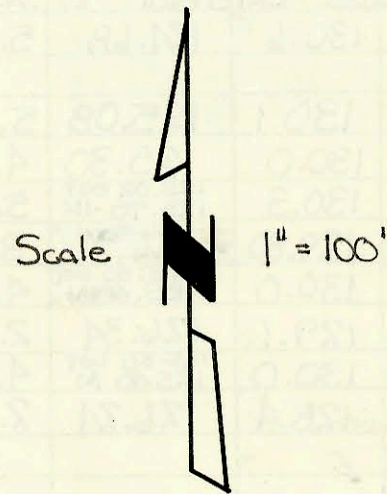

7604 105

CONSTRUCTION RECORD						SERVICE RECORD						
STATION	ELEVATION		Depth	MANHOLE	4-INCH "Y" BRANCHES		No. of Permit		House Number		DATE OF PERMITS	
	Ground	Grade			North West	South East	North West	South East	North West	South East	North West	South East
Private Sanitary Sewer to Serve Lot 1, Block 1, Windmere 2nd Addition								2053		8220 E Oxford		5-8-83
LINE 1	0+00	204.95	194.73	10.2	0+00							
		206.02	195.00	11.2	0+52.4							
	1+00	206.40	195.20	11.2								
		208.14	195.47 OUT 195.67 IN	12.6	1+67.9							
	2+00	207.20	195.80	11.4								
	3+00	207.00	196.14	10.9								
		206.94	196.17 OUT 196.36 IN	10.8	3+08.1	4" SDR 35 3+54.1 TAP		91-21943-7	8220 E Oxford Cr. Bldg 200			5-8-91
	4+00	207.10	196.73	10.4								
						4" SDR 35 Shallow 4+67.9 TAP		91-21945-7	8220 E Oxford Cr. Bldg 100			5-8-91
	5+00	207.90	197.13	10.8								
		208.31	197.37	10.9	5+58.9							
	6+00	208.70	197.53	11.2								
		210.54	197.91	12.6	6+96.3	6" SDR 35 6+116.9 TAP SDR 35 6" to 10" H. Stub		91-21946-7 91-21947-7	8220 E Oxford Cr. Bldg 200 8220 E Oxford Cr. Bldg 200			5-8-91 5-8-91
LINE 2	0+00	208.14	195.47 OUT 195.78 IN	12.7	0+00							
	1+00	208.00	196.33	11.7		6" SDR 1+49.3 TAP		91-21877-7	8220 E Oxford Cr. Bldg 200			5-8-91
		208.81	196.79	12.0	1+82.8							
	2+00	208.00	196.86	11.1		6" SDR 2+19.9 TAP		91-21878-7	8220 E Oxford Cr. Bldg 1300			5-8-91
		208.41	197.00 OUT 197.20 IN	11.4	2+37.1							
	3+00	208.50	197.45	11.0								
	4+00	208.70	197.85	10.9								
		210.32	198.09	12.2	4+61.3							
	5+00	209.30	198.24	11.0								
	6+00	210.40	198.62	11.8								
		212.38	198.92 OUT 198.99 IN	13.5	6+52.4							
	7+00	211.00	199.16	11.8								
	8+00	210.00	199.52	10.5		6" SDR 7+71.2 TAP		91-21900-7	8220 E Oxford Bldg #600			5-8-91
	9+00	208.90	199.89	9.0								
	10+00					6" SDR Shallow 10+14.2 TAP		91-21920-7 91-21922-7	8220 E Oxford Bldg #700			5-8-91
LINE 3	0+00	207.60	200.51	7.1	10+72.2	6" Stub N.		91-21923-7	8220 E Oxford Bldg #800			12-7-95
		217.38	198.82 OUT 198.99 IN	13.6	0+00							
	1+00	212.00	199.39	12.6								
		213.31	199.53	13.8	1+34.8	6" SDR Shallow 6" MHTAP-West		91-21878-7	8220 E Oxford Cr. Bldg 400			5-8-91
LINE 4	0+00	208.41	197.00 OUT 197.20 IN	11.4	0+00	6" SDR Shallow 6" MHTAP-NE		91-21869-7	8220 E Oxford Cr. Bldg 500			5-8-91
	1+00	207.00	197.69	9.3								
		207.79	197.82	10.0	1+25.3							
	2+00	207.30	198.13	9.2								
		209.79	198.40	11.4	2+65.1	8" Stub NE						
LINE 5	0+00	207.79	197.82 OUT 197.83 IN	10.0	0+00	6" SDR Shallow 0+10.0 TAP		91-21875-7	8220 E Oxford Cr. Bldg #1000			5-8-91
	1+00	208.40	198.28	10.1								
		209.56	198.66 OUT 198.86 IN	10.9	1+85.4							
	2+00	209.10	198.90	10.2		SDR 35 1+99.0 TAP		91-21876-7	8220 E Oxford Cr. Bldg #1100			
		209.38	199.39	10.0	2+29.6	6" SDR Shallow 6" MHTAP-NE TAP		91-21873-7	8220 E Oxford Cr. Bldg #900			5-8-91
Private Sanitary Sewer Extension To Serve Part of Lot 1, Block 1, Windmere Second Addition												
	0+00	209.00	198.30 out	10.7	0+00							
		209.00	199.07 in	9.9								
	1+00	209.40	199.37	10.0								
		208.48	199.65	8.8	1+91.8							
	2+00	207.50	199.67	7.8								
	3+00	207.00	199.97	7.0								
	4+00	206.00	200.27	5.7								
		206.21	200.50	5.7	4+76.8	6" N 200.70						