


PRIVATE SANITARY SEWER TO NEW LIFE ADDITION
 PRIVATE PROJECT NO. 273 PPS (607861)
 BUILT BY NOWAK CONSTRUCTION CO.
 BOOKED 12-20-91 FROM AS BUILTS


SCALE: 1" = 100'

PRIVATE SANITARY SEWER TO SERVE PART
 LOT 1, STAR LUMBER 5TH ADDITION
 PRIVATE PROJECT NO. 302 PPS (607861)
 BUILT BY DONDLINGER AND SONS CO.
 BOOKED 1-9-92 FROM AS BUILTS

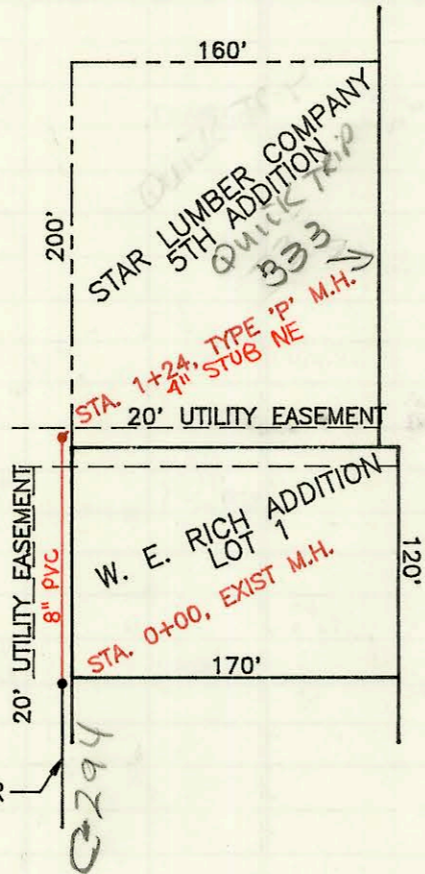

SCALE: 1" = 100'

PRIVATE SANITARY SEWER EXTENSION TO SERVE TOWNE PARC ADDITION, PHASE 2
 PRIVATE PROJECT NO. 291 PPS (607861)
 BUILT BY W. B. CARTER CONSTRUCTION CO.
 BOOKED 1-17-92 FROM AS BUILTS

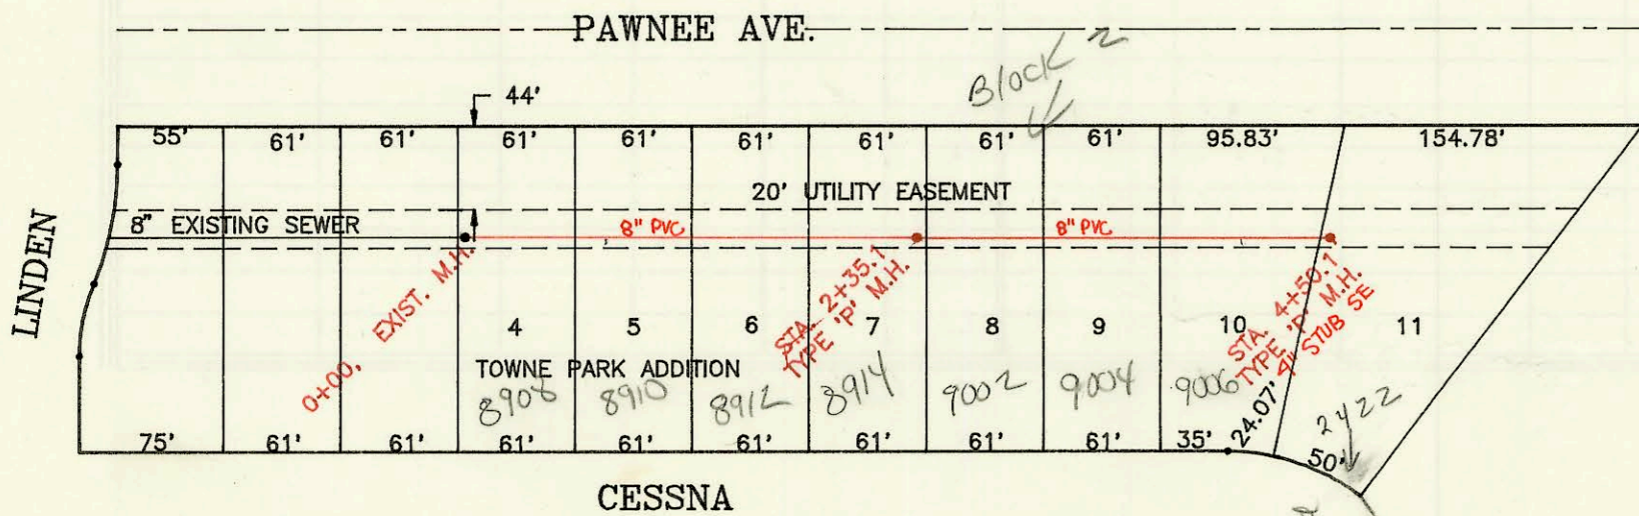

SCALE: 1" = 100'

CONSTRUCTION RECORD							SERVICE RECORD					
STATION	ELEVATION		Depth	MANHOLE	4-INCH "Y" BRANCHES		No. of Permit		House Number		DATE OF PERMITS	
	Ground	Grade			North West	South East	North West	South East	North West	South East	North West	South East
Private Sanitary Sewer To New Life Addition												
0+00	164.3	147.33 OUT 146.33 IN	22.0	0+00								
	165.6	147.41 OUT 134.31 IN	18.2	0+30		6" Stub S.		26841		5015 E 29th U		1-3-91
Private Sanitary Sewer To Serve Part of lot 1, Star Lumber 5th Addition												
0+00	118.33	109.83 OUT 110.47 IN	8.5	0+00								
1+00	117.9	111.49	6.4				97-23447			325 West #10		12-4-97
	118.48	111.73	6.8	1+24	4" Stub NE		97-35847			333 S.W. EST		10-22-91
Private Sanitary Sewer Extension To Serve Towne Park Addition, Phase 2												
0+00	200.05	187.90 OUT 186.98 IN	15.2				91-31186-7			8908 Cessna		8/28/91
0+17	200.1						95			8910 Cessna		4-10-92
0+77	200.2						91-38790-7					12-10-91
1+00	200.3	187.86	12.4							8912 Cessna		1-31-92
2+00	200.5	187.75	12.8				92-1710-7			8914 Cessna		3-6-92
	200.66	189.06 OUT 189.16 IN	11.6	2+35.1		4" 50A 35 2+78.1 tap	92-3205-7			9002 Cessna		1-31-92
3+00	200.0	189.46	10.5			4" 50A 35 4+50.1 Tap	92-1708-7			9004 Cessna		1-31-92
						4" 50A 35 3+60.6 Tap	91-34568-7			9006 Cessna		10-7-91
4+00	199.0	189.91	9.1									
	198.51	190.14	8.4	4+50.1	4" Stub SE		98-61847			2472 Gateway		4-16-98