




PRIVATE SANITARY SEWER TO SERVE
 PHILLIPS 66 CENTRE, TYLER ADDITION
 PRIVATE PROJECT No. 288 PPS (607861)
 BUILT BY L.A. KNEBLER CONSTRUCTION CO.
 BOOKED 2-6-92 FROM AS BUILTS

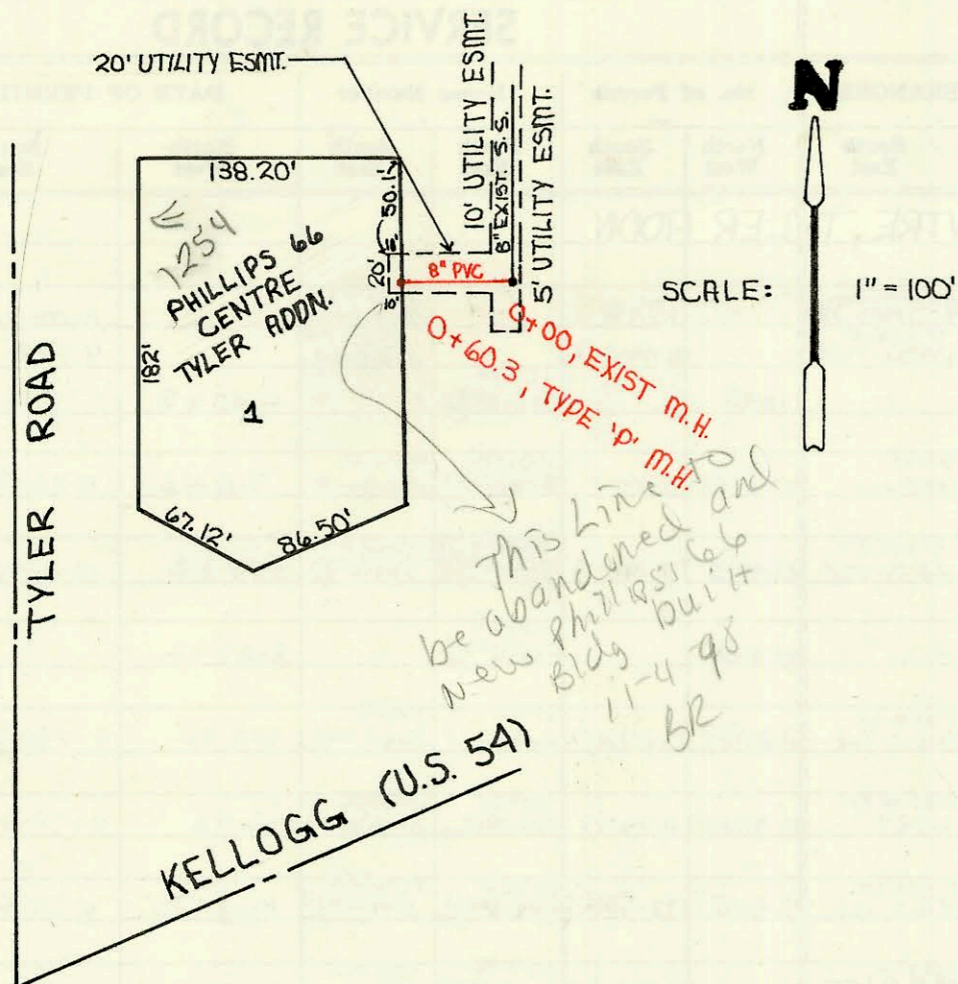


PRIVATE SANITARY SEWER TO SERVE
 MESS ADDITION
 PRIVATE PROJECT No. 318 PPS (607861)
 BUILT BY DONDLINGER AND SONS
 BOOKED 2-7-92 FROM AS BUILTS

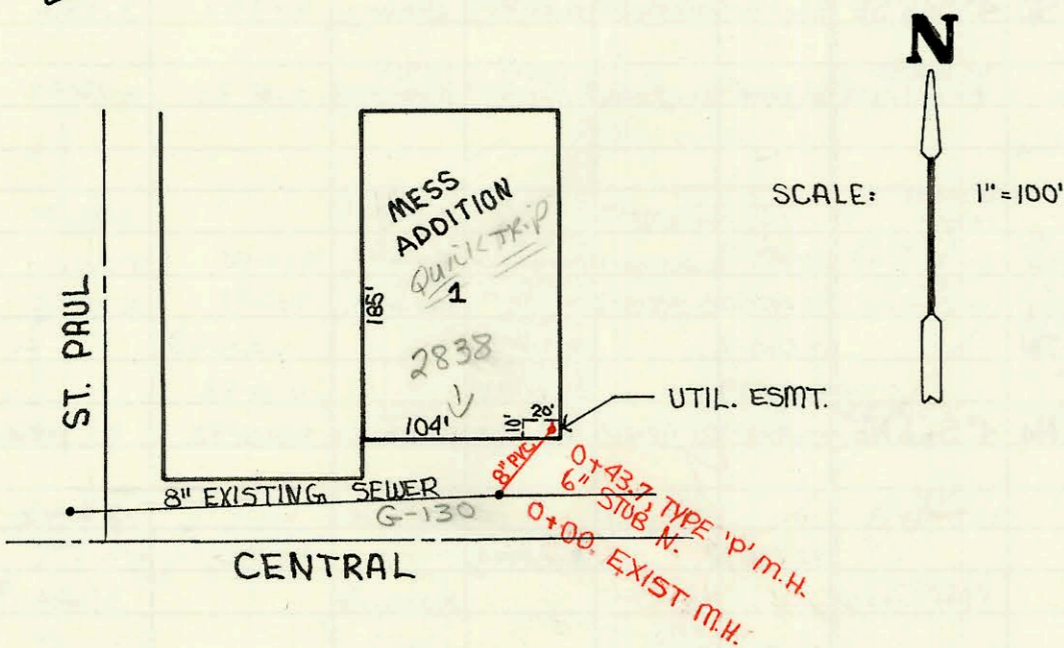

PRIVATE SANITARY SEWER TO SERVE A PART
 OF MYERS NURSERY
 PRIVATE PROJECT NO. 316 PPS (607861)
 BUILT BY W. B. CONSTRUCTION CO.
 BOOKED 2-10-92 FROM AS BUILTS

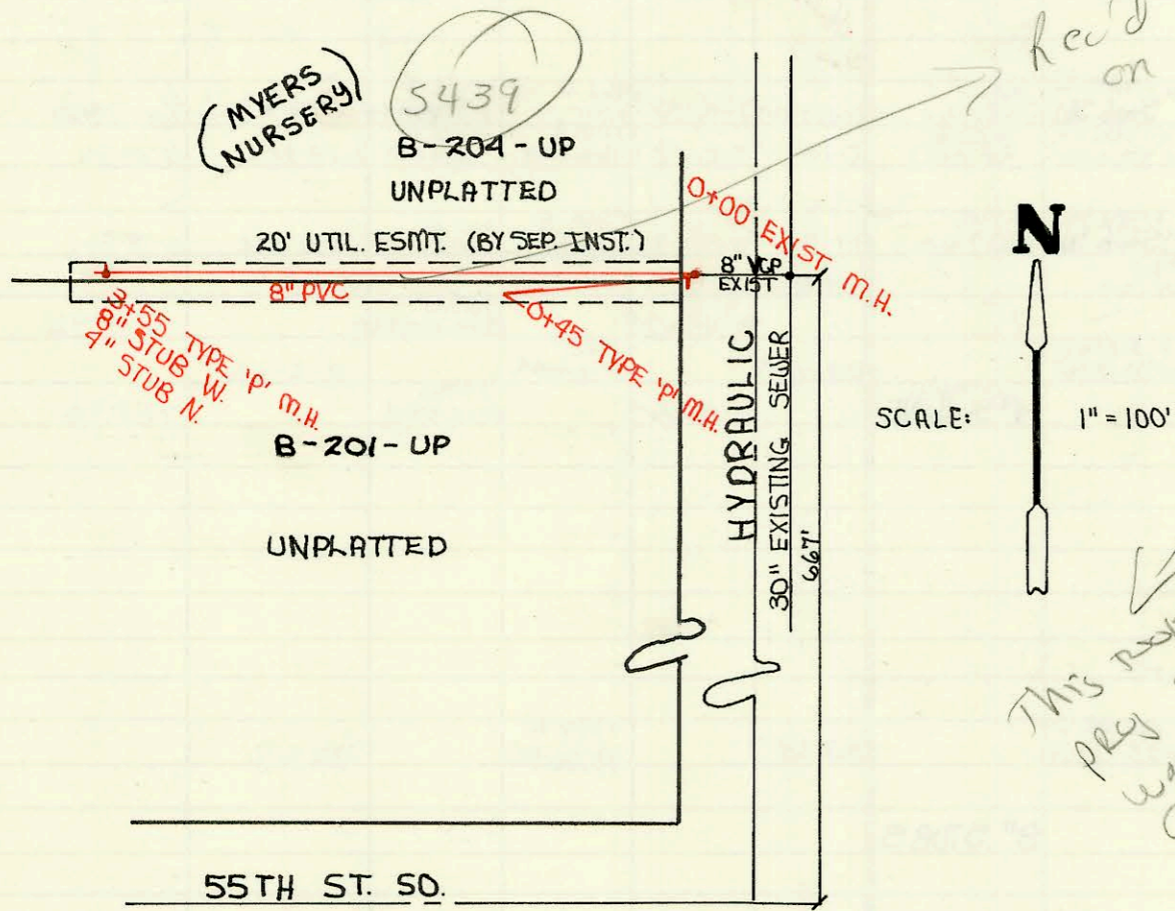

LATERAL 98, WESTLINK SEWER
 PROJECT NO. 468-82143 (740886)
 BUILT BY NOWAK CONSTRUCTION
 BOOKED 2-26-92 PER PLAN

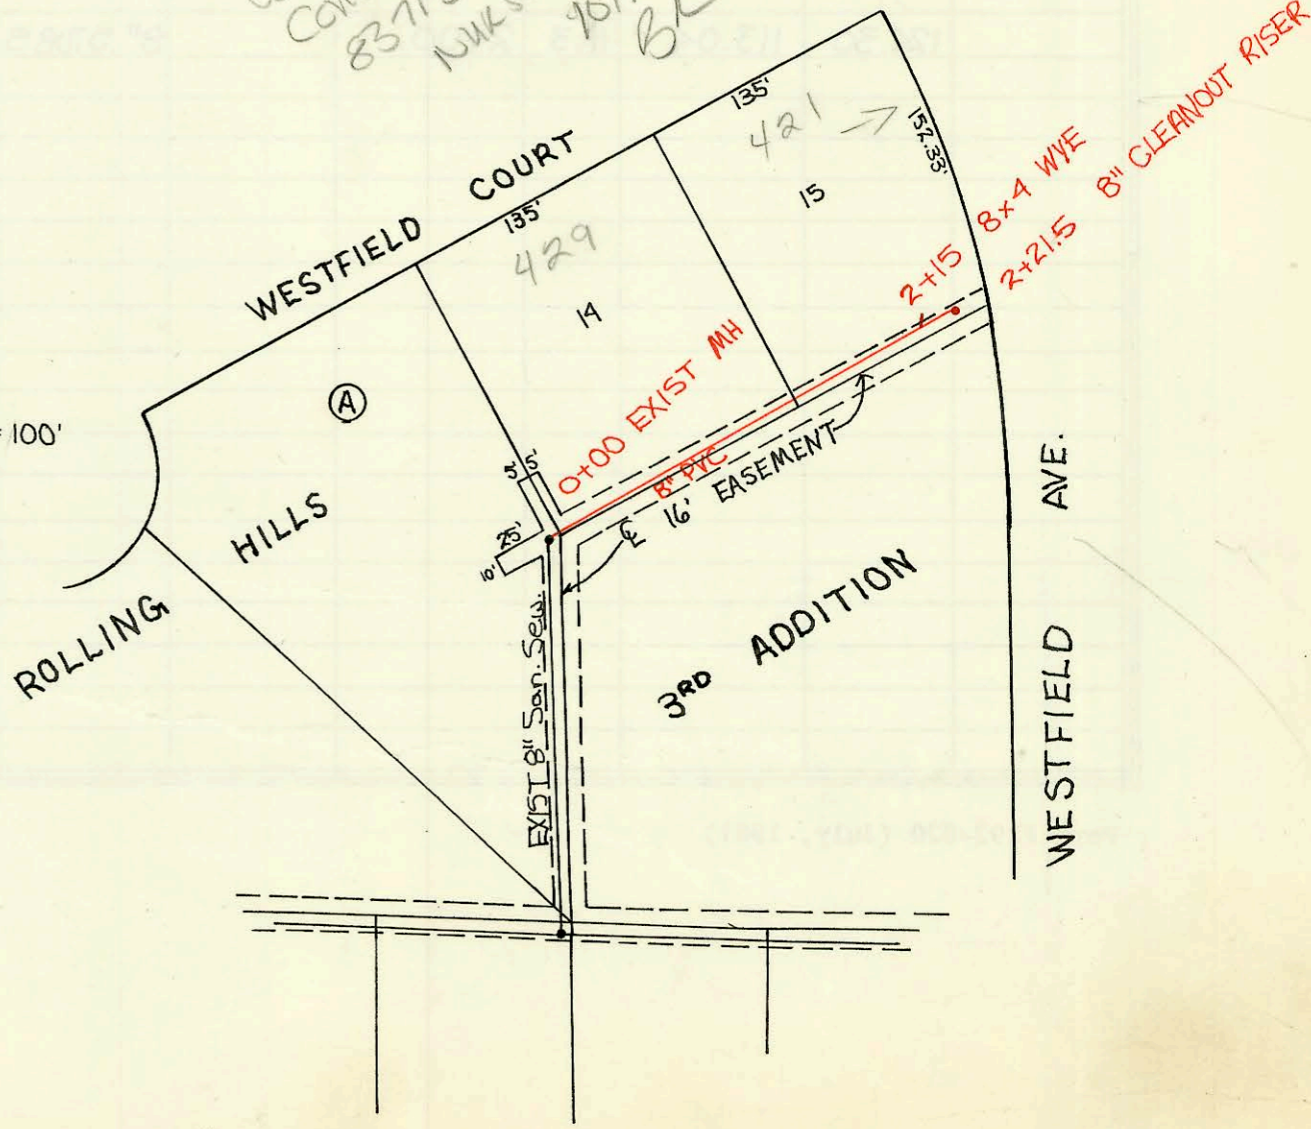

CONSTRUCTION RECORD						SERVICE RECORD						
STATION	ELEVATION		Depth	MANHOLE	4-INCH "Y" BRANCHES		No. of Permit		House Number		DATE OF PERMITS	
	Ground	Grade			North West	South East	North West	South East	North West	South East	North West	South East
Private Sanitary Sewer To Serve Phillips 66 Centre, Tyler Addition												
0+00	142.01	135.81 136.16	6.2	0+00								
	140.97	136.52	4.5	0+60.3	4" SDR35 with connection		99-5531-7 9227137		(254 Phillips) Tyler 570		3-30-99 5-17-91	
Private Sanitary Sewer To Serve Mess Addition												
0+00	117.2	115.79 114.10	3.4	0+00								
	119.0	114.79	4.7	0+43.7	6" Stab N		1928		2888 W Central		1-14-92	
Private Sanitary Sewer To Serve A Part Of Myers Nursery												
0+00	79.20	69.77 64.74	18.4	0+00								
	77.50	64.92 66.00	12.6	0+45								
1+00	77.50	66.22	11.3									
2+00	79.50	66.62	12.9									
3+00	80.0	67.02	13.0									
	80.0	67.24	12.8	3+55	8" STOB W 4" STOB N	4" PVC 4" D	71-384947		5439 Hydeauin		12-5-91	
LATERAL 98 WESTLINK SEWER												
0+00	143.42	139.17 137.17	6.3	0+00								
					4" ABS 40 0.71.0 TAP		72963-7		424 Westfield		1-22-92	
1+00	144.30	137.82	6.5									
2+00	144.40	138.15	6.3									
2+15	144.80	138.57	6.2	2+21.5 C.O.	4" Sch 40 PVC Wye 3" W of C.H. TAP		921806-1		421 Westfield		2-4-92	