


COWSKIN INTERCEPTOR SEWER
FORCE MAIN (PART A)
468-81838 (600783)
Built By Ut. Contr.
Booked 2-92 from Plan

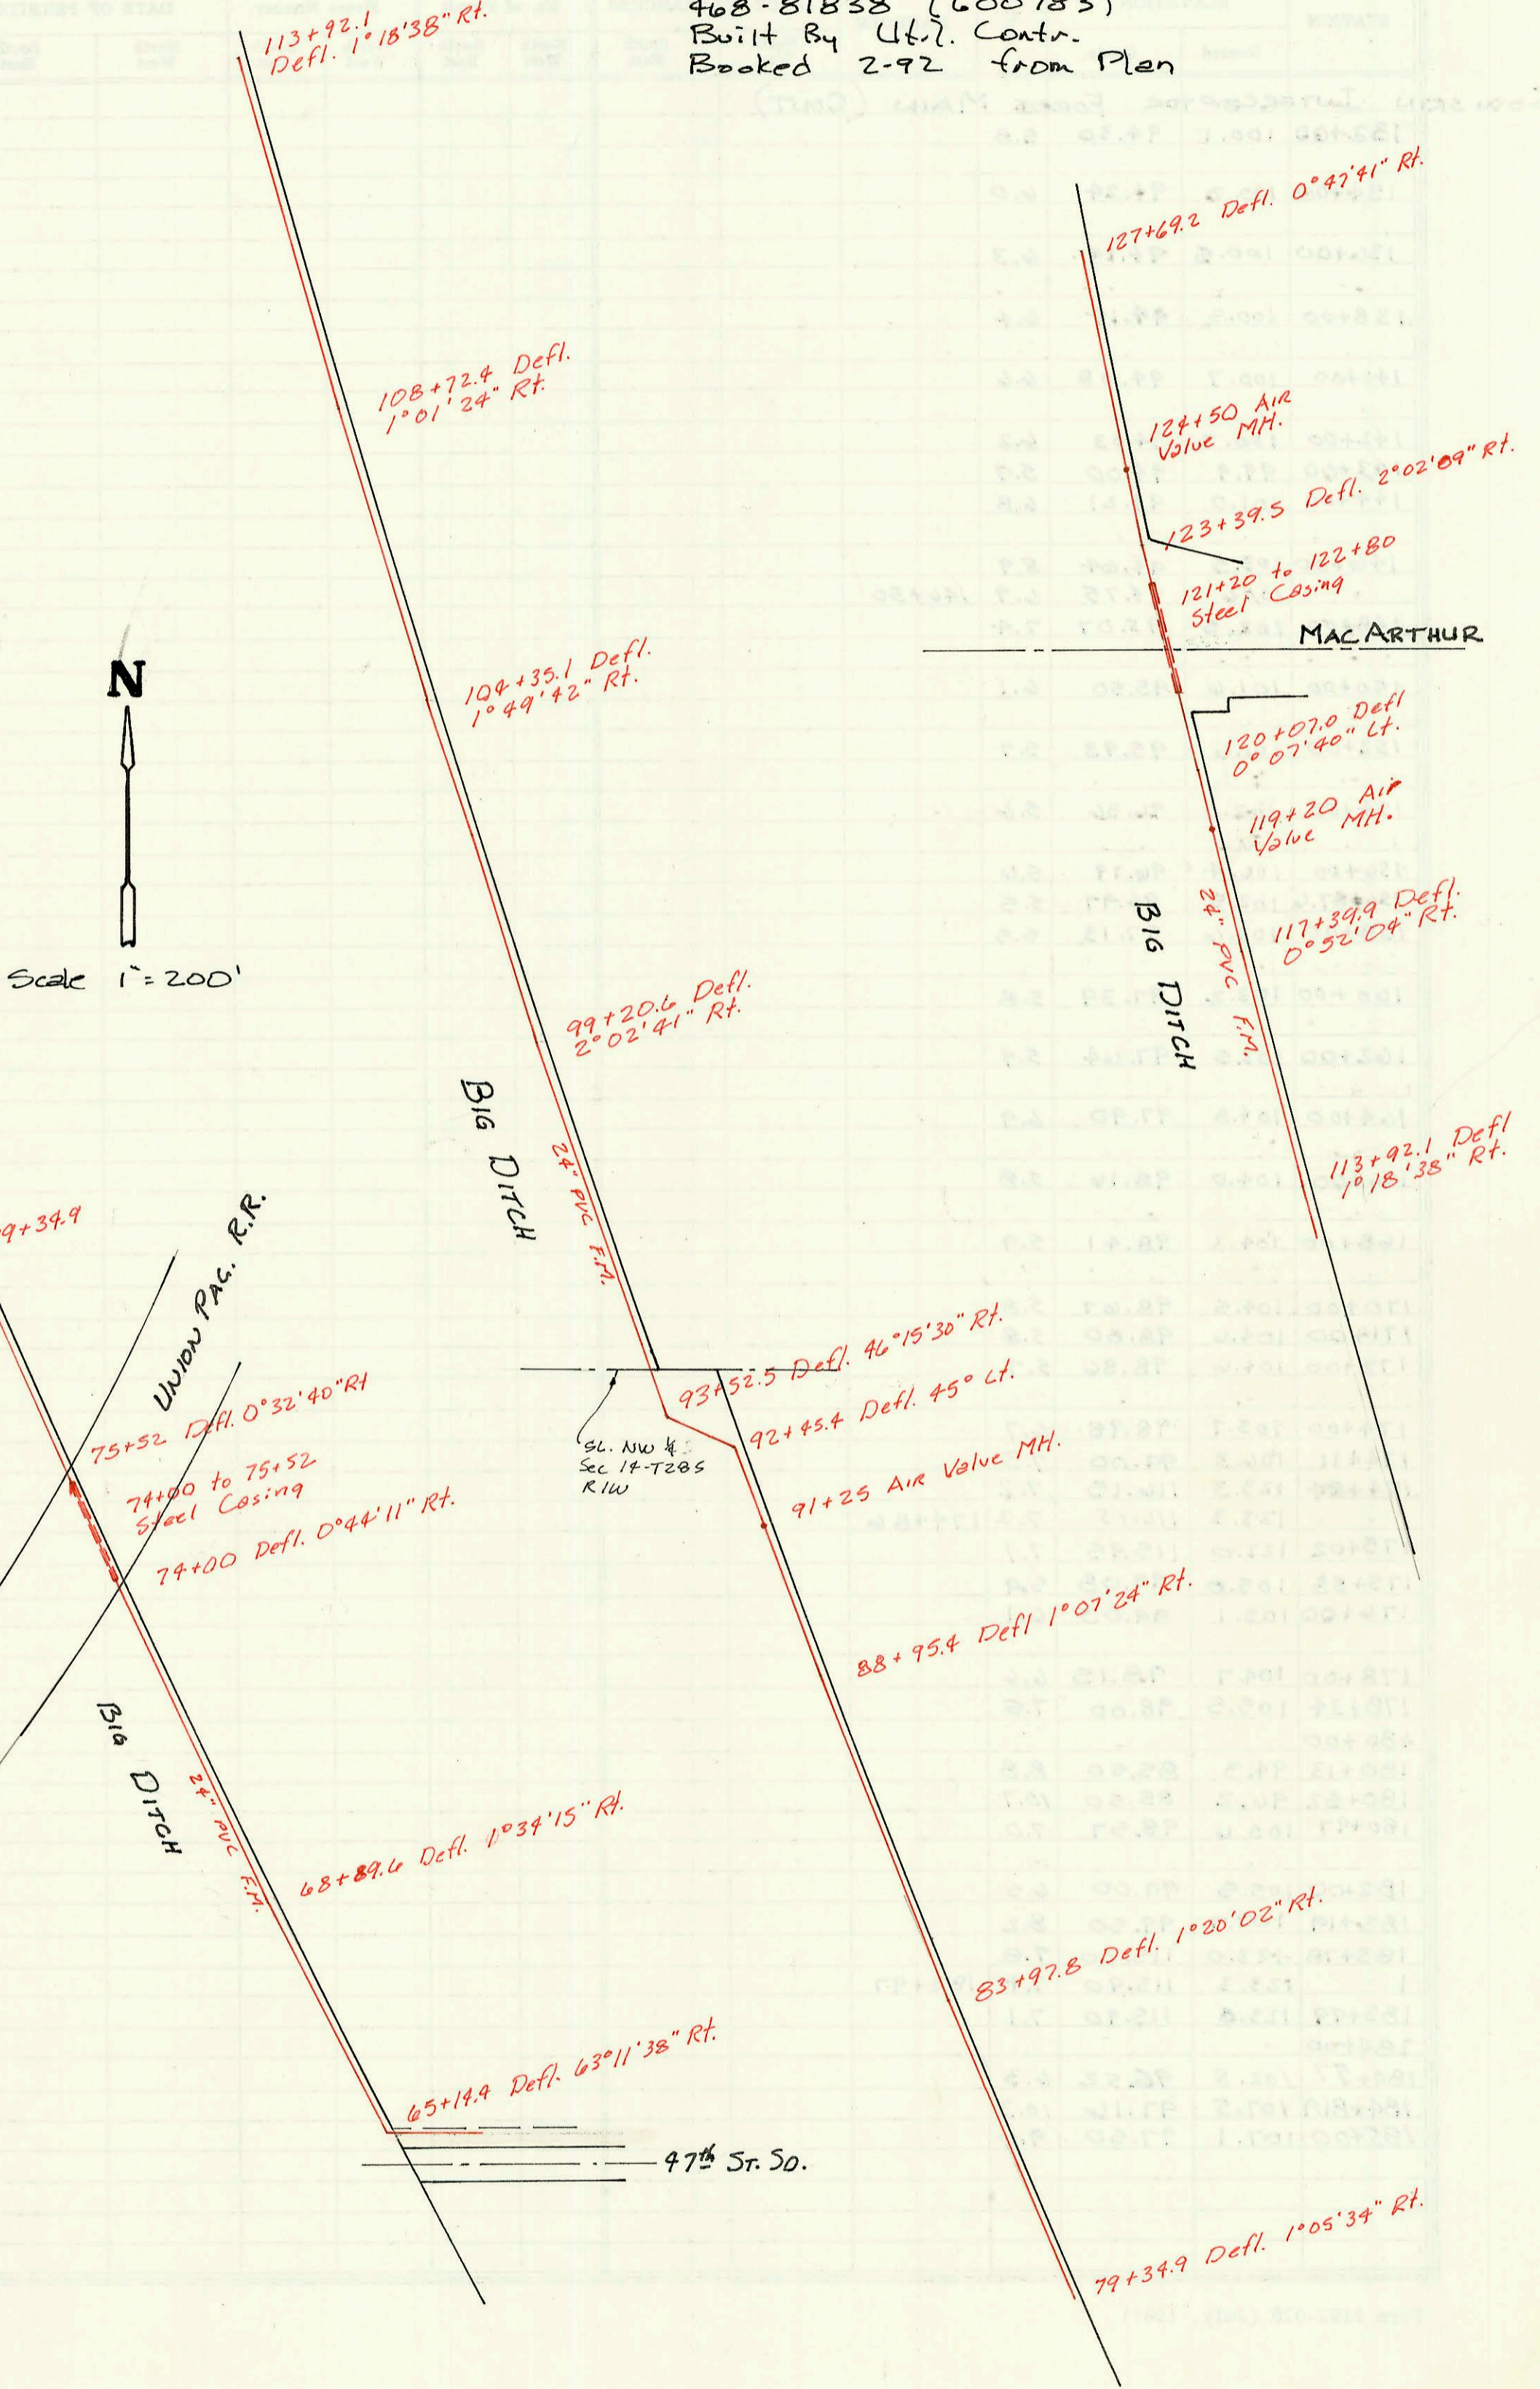

Scale 1" = 200'

COWSKIN

CONSTRUCTION RECORD						SERVICE RECORD						
STATION	ELEVATION		Depth	MANHOLE	4-INCH "Y" BRANCHES		No. of Permit		House Number		DATE OF PERMITS	
	Ground	Grade			North West	South East	North West	South East	North West	South East	North West	South East
	INTERCEPTOR	FORCE MAIN	(CONT)									
70+00	99.1	91.50	7.6									
72+00	100.4	91.75	8.7									
74+00	100.7	92.00	8.7									
75+52	101.5	93.00	8.5									
	101.1	93.00	8.1	75+75.0								
76+00	100.5	92.99	7.5									
78+00	100.3	92.88	7.4									
80+00	100.2	92.77	7.4									
82+00	99.1	92.66	6.4									
84+00	98.5	92.56	5.9									
85+00	98.5	92.50	6.0									
86+00	98.5	92.40	6.1									
88+00	97.6	92.20	5.4									
90+00	97.5	92.00	5.5									
	97.9	91.47	6.4	91+25								
92+00	97.5	91.15	6.4									
93+52.5	97.3	90.50	6.8									
94+00	96.9	90.48	6.4									
96+00	96.4	90.39	6.0									
98+00	96.1	90.30	5.8									
100+00	96.3	90.22	6.1									
102+00	95.7	90.13	5.6									
104+00	96.1	90.04	6.1									
105+00	95.0	90.00	5.0									
106+00	98.5	90.50	8.0									
108+00	97.2	91.50	5.7									
110+00	98.2	92.50	5.7									
112+00	98.6	93.50	5.1									
112+18.1	98.6	93.52	5.1									
113+92.1	99.4	93.76	5.6									
114+00	99.4	93.77	5.6									
116+00	99.8	94.05	5.8									
118+00	99.9	94.32	5.6									
	100.6	94.39	6.2	119+20								
119+30	100.2	94.50	5.7									
121+20	101.3	83.00	18.3									
122+80	98.3	84.00	14.3									
124+00	100.2	91.88	8.3									
124+40	101.0	94.50	6.5									
	100.8	94.50	6.3	124+50								
126+00	100.5	94.46	6.0									
128+00	100.0	94.41	5.6									
130+00	100.0	94.35	5.7									