


COWSKIN INTERCEPTOR SEWER
 FORCE MAIN (Part B)
 468-81944 (607739)
 Built By W.B. CARTER CONST.
 BOOKED 2-92 from Plan

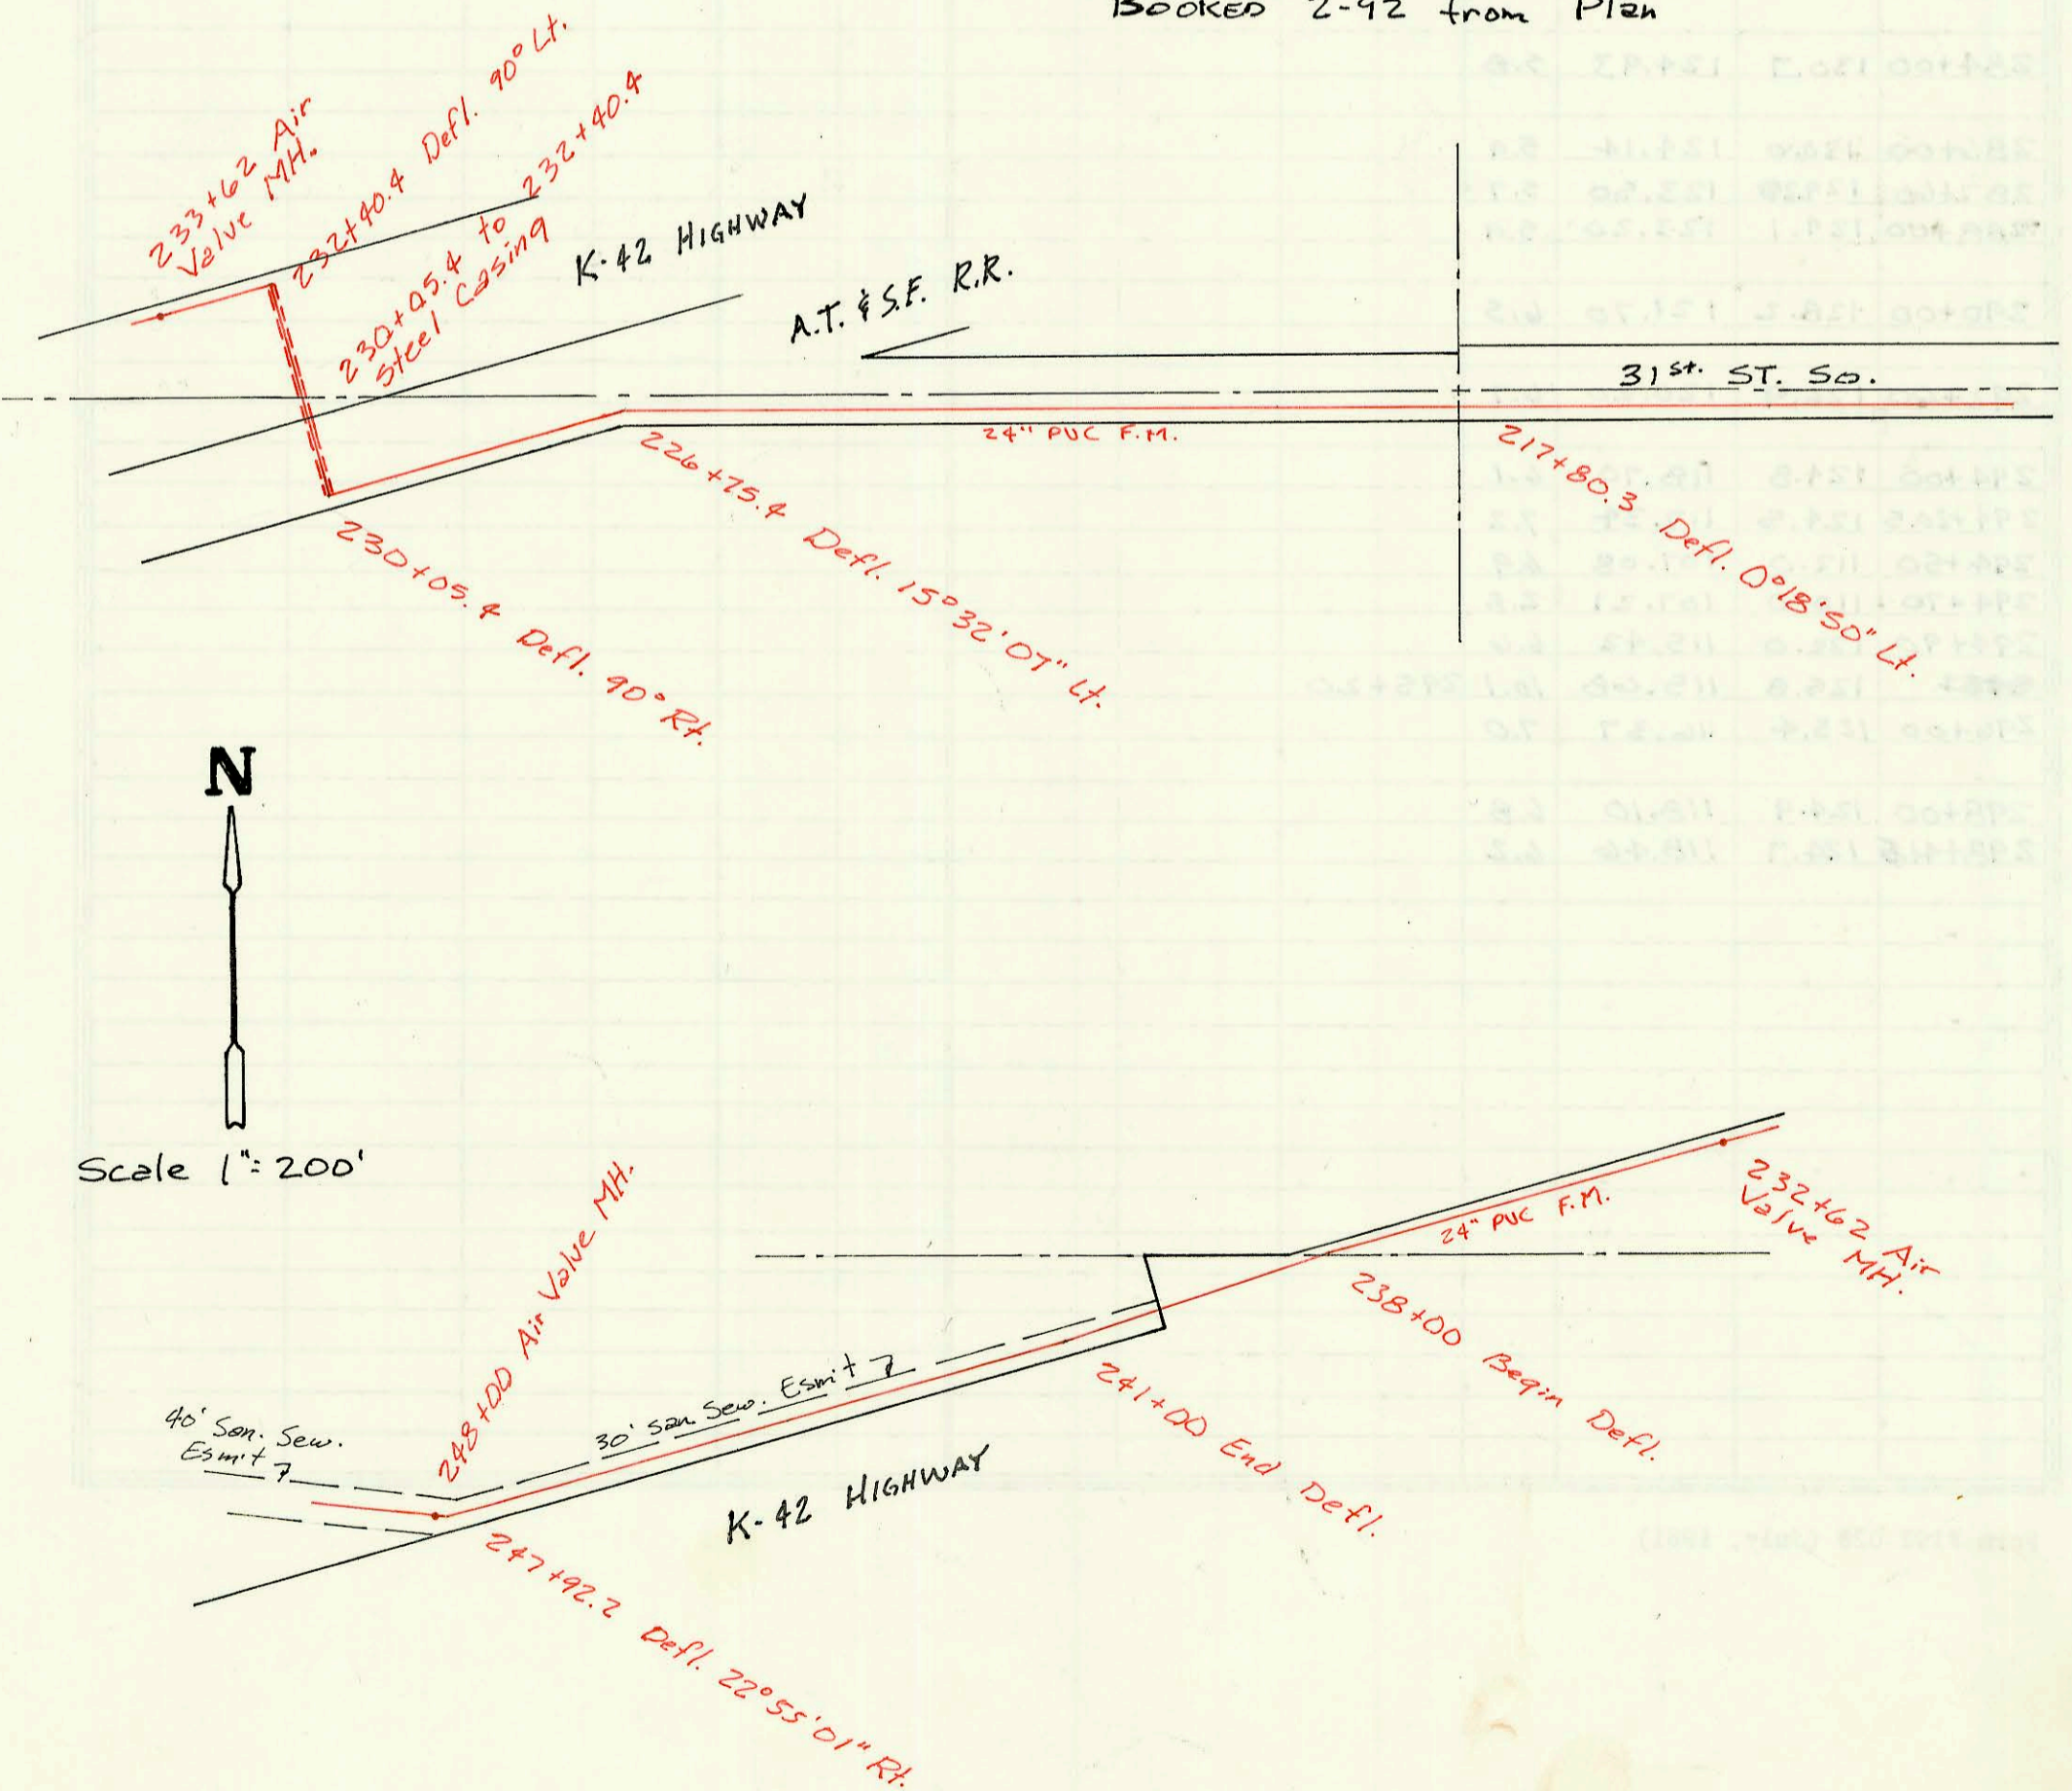

Scale 1" = 200'

CONSTRUCTION RECORD						SERVICE RECORD						
STATION	ELEVATION		Depth	MANHOLE	4-INCH "Y" BRANCHES		No. of Permit		House Number		DATE OF PERMITS	
	Ground	Grade			North West	South East	North West	South East	North West	South East	North West	South East
COWSKIN INTERCEPTOR FORCE MAIN (CONT.)												
186+00	106.2	98.17	8.0									
188+00	107.5	99.50	8.0									
190+00	109.5	101.07	8.4									
	108.2	101.50	6.7	190+55								
190+91.9	109.7	94.70	15.0									
192+00	106.5	96.68	9.8									
194+00	107.5	100.35	7.2									
	109.2	102.00	7.2	194+90								
196+00	108.0	102.23	5.8									
198+00	108.4	102.65	5.8									
200+00	108.7	103.08	5.6									
202+00	108.7	103.50	5.2									
204+00	110.5	104.25	6.3									
206+00	111.1	105.02	6.1									
208+00	112.0	106.33	5.7									
210+00	113.2	107.67	5.5									
212+00	115.2	109.00	6.2									
214+00	115.6	109.17	6.4									
216+00	115.5	109.33	6.2									
218+00	116.2	109.50	6.7									
220+00	116.9	111.00	5.9									
222+00	118.6	112.50	6.1									
224+00	120.3	114.00	6.3									
226+00	121.4	115.50	5.9									
228+00	124.7	116.43	8.3	228+00								
230+00	123.8	115.50	8.3									
232+00												
232+40+	126.5	116.00	10.5									
	126.0	119.00	7.0	233+62								
234+00	125.7	118.98	6.7									
236+00	125.4	118.85	6.6									
238+00	124.0	118.73	5.3									
240+00	125.0	118.61	6.4									
242+00	124.7	118.49	6.2									
244+00	124.3	118.37	5.9									
246+00	125.0	118.24	6.8									
248+00	125.4	118.12	7.3									