


PRIVATE SANITARY SEWER TO SERVE WILLIAMS NATURAL GAS  
PRIVATE PROJECT NO. 313 PPS (607861)  
BUILT BY W. B. CARTER CONSTRUCTION CO.  
BOOKED 3-18-92 FROM AS BUILTS



add chg  
TO 4000  
5. Seneca

4040 S  
Seneca

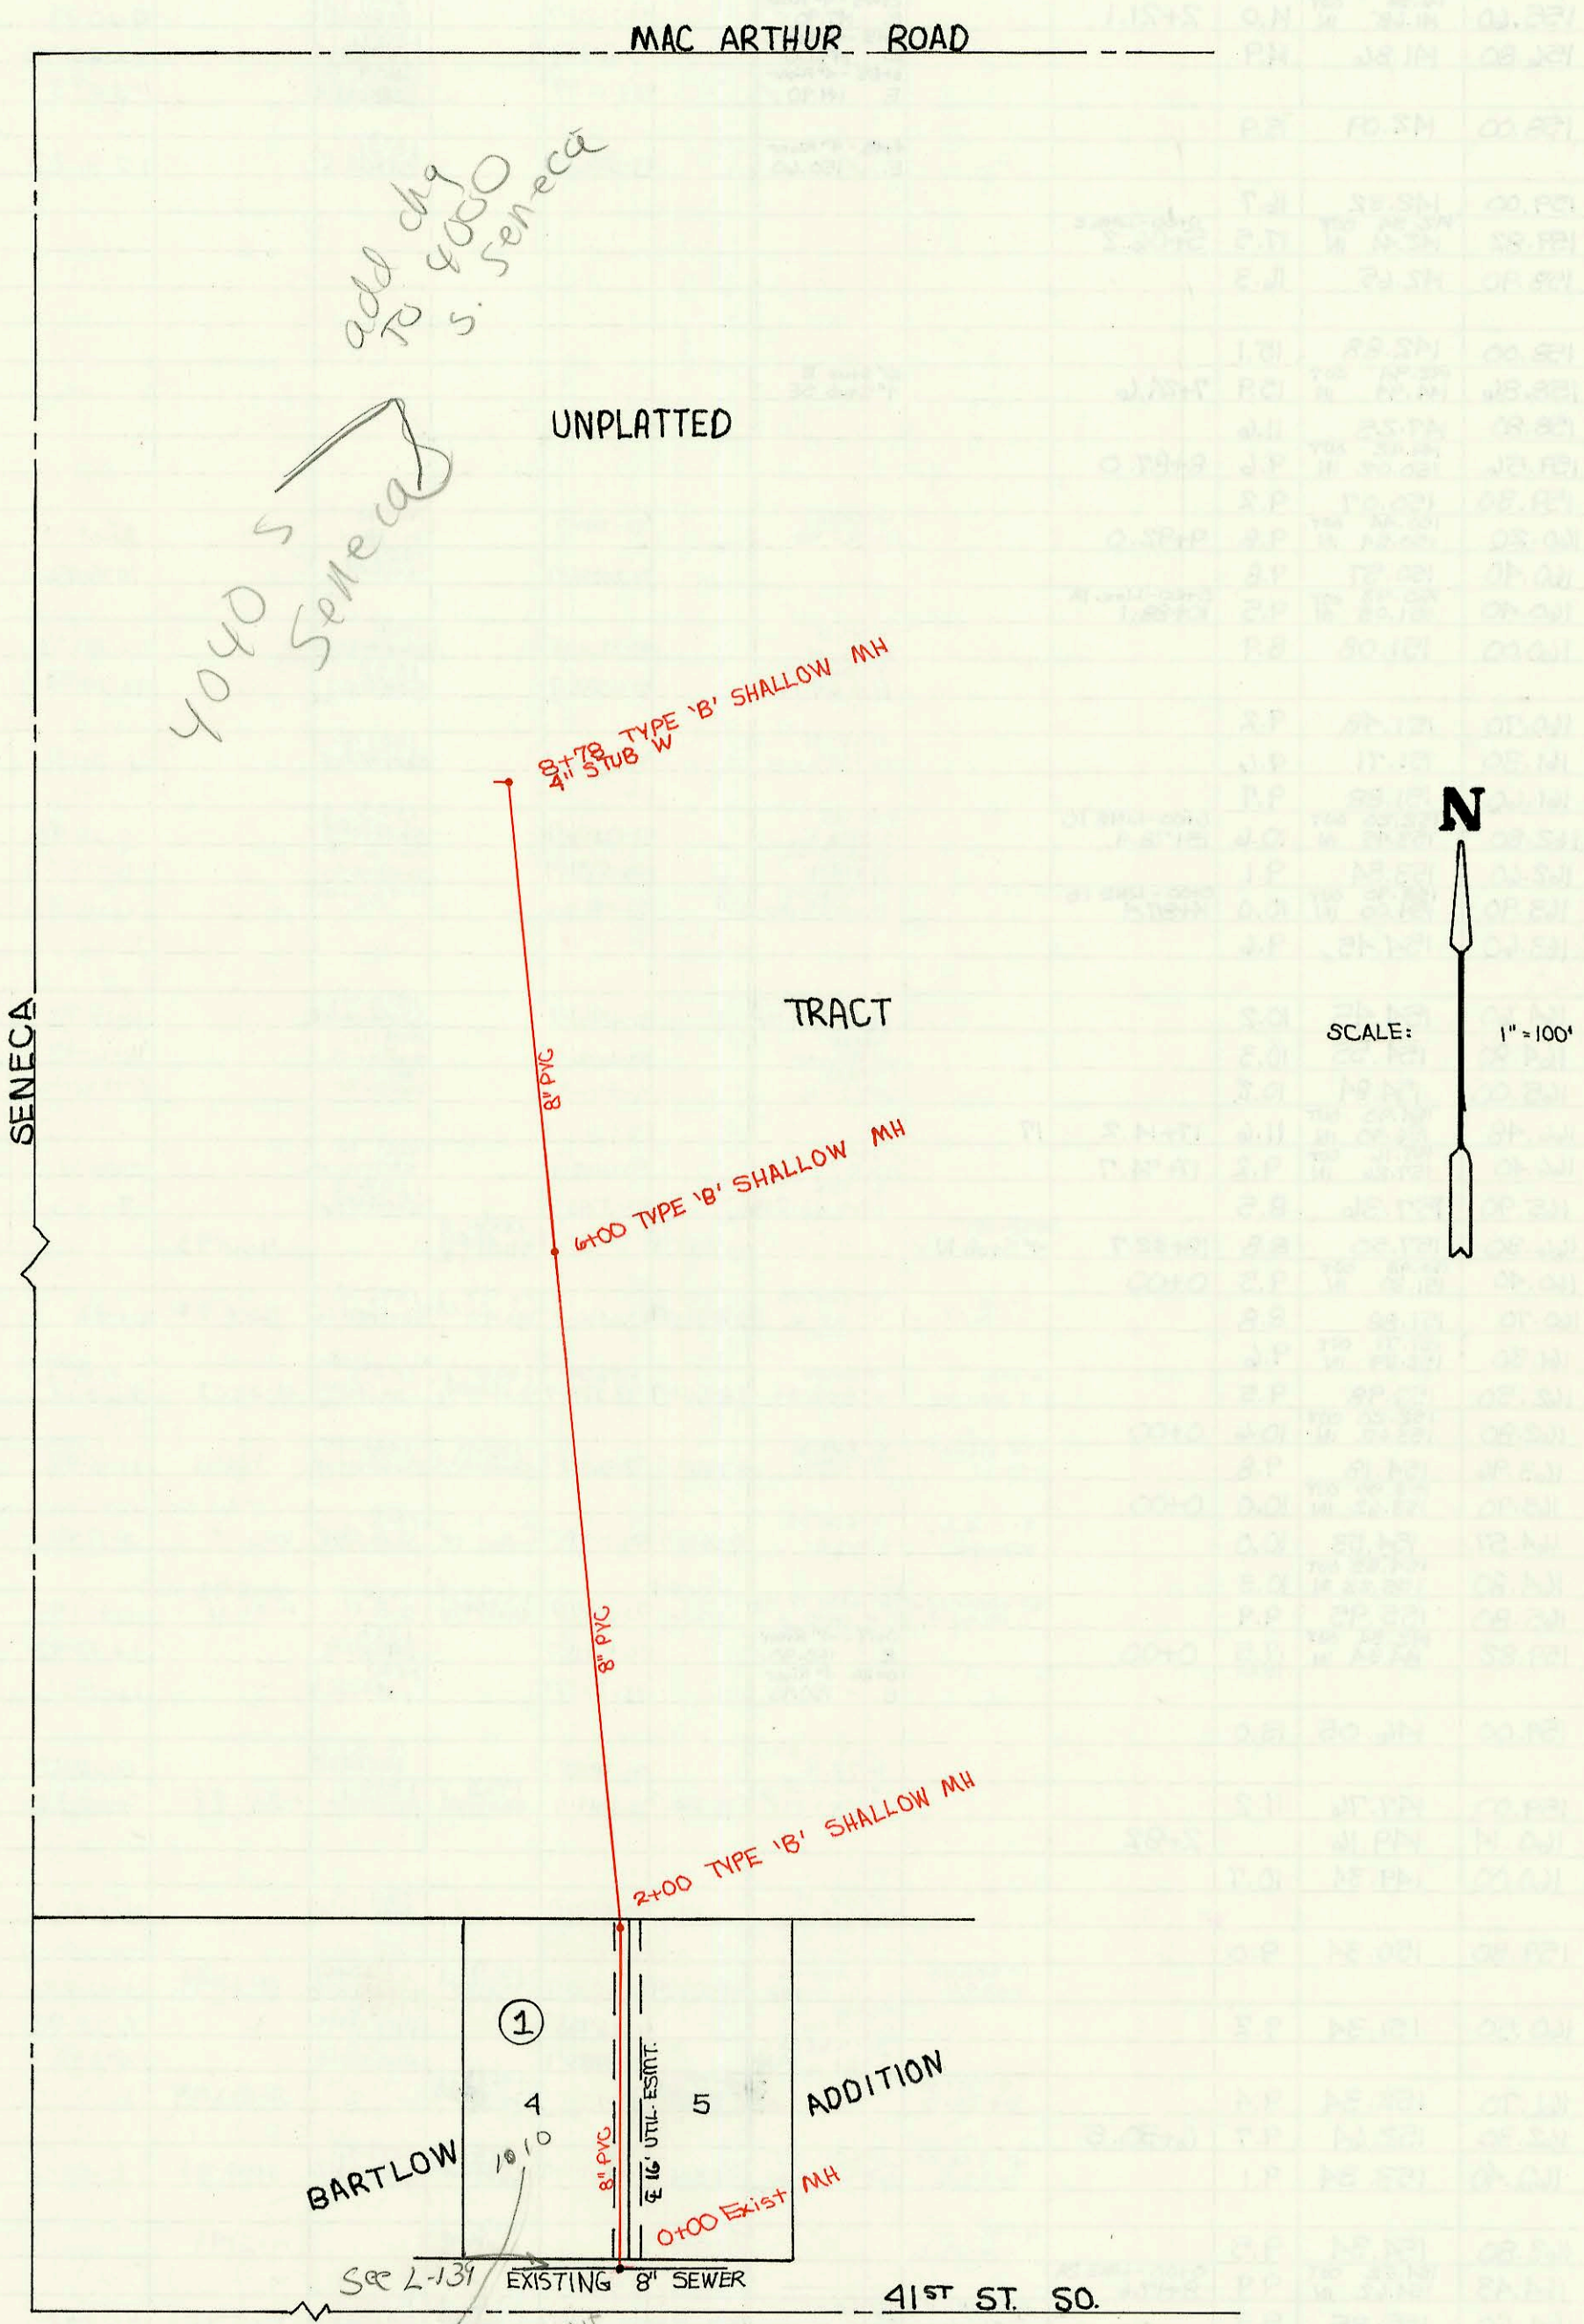

New Bldg permit  
to be made &  
add some more  
restrooms.

