



PRIVATE SANITARY SEWER TO SERVE BOEING PROPERTY ALONG MACARTHUR
PRIVATE PROJ. NO. 278 PPS (607861)
BUILT BY W. B. CARTER CONST. CO.
BOOKED 3-20-92 FROM AS BUILTS

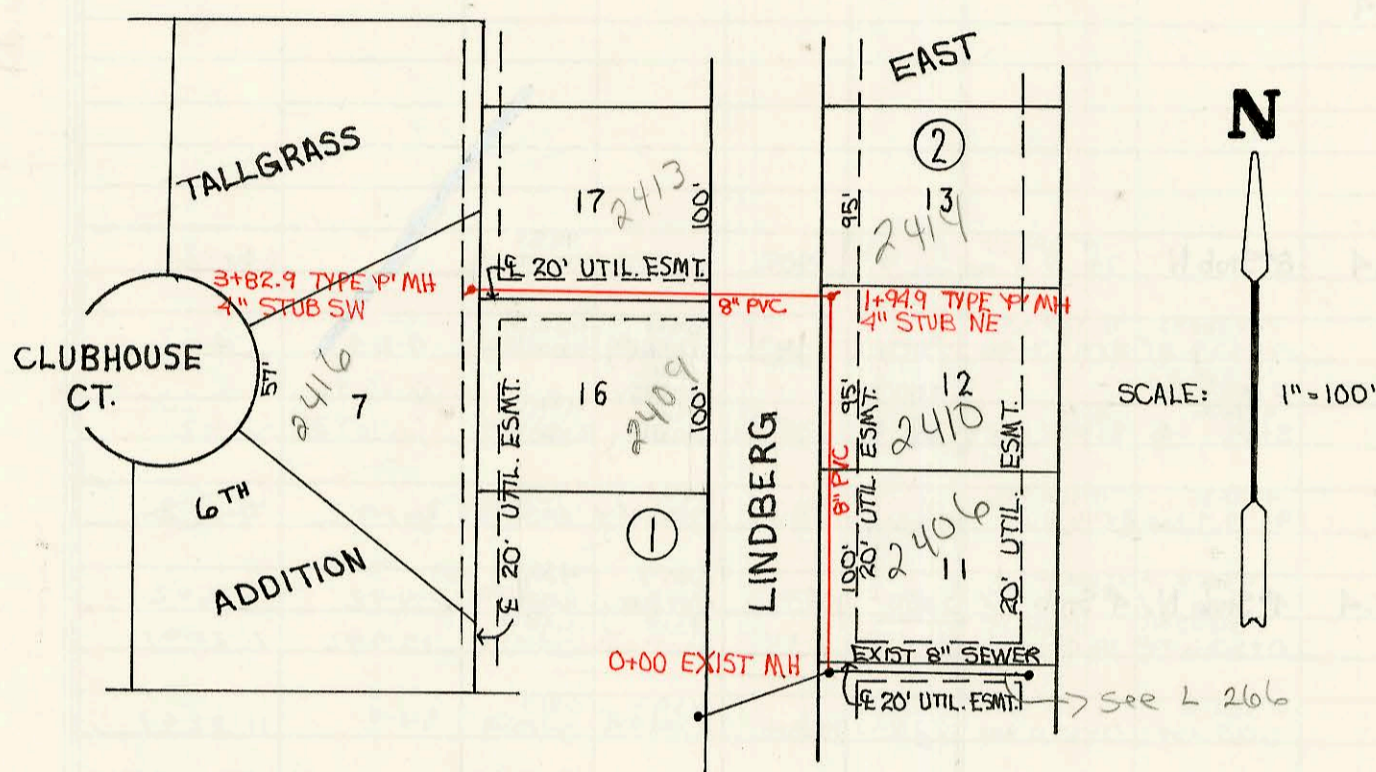

LATERAL 24, MAIN 24, W15
PROJ. NO. 468-82145 (740951)
BUILT BY MEIS CONST. CO.
BOOKED 3-24-92 PER PLAN

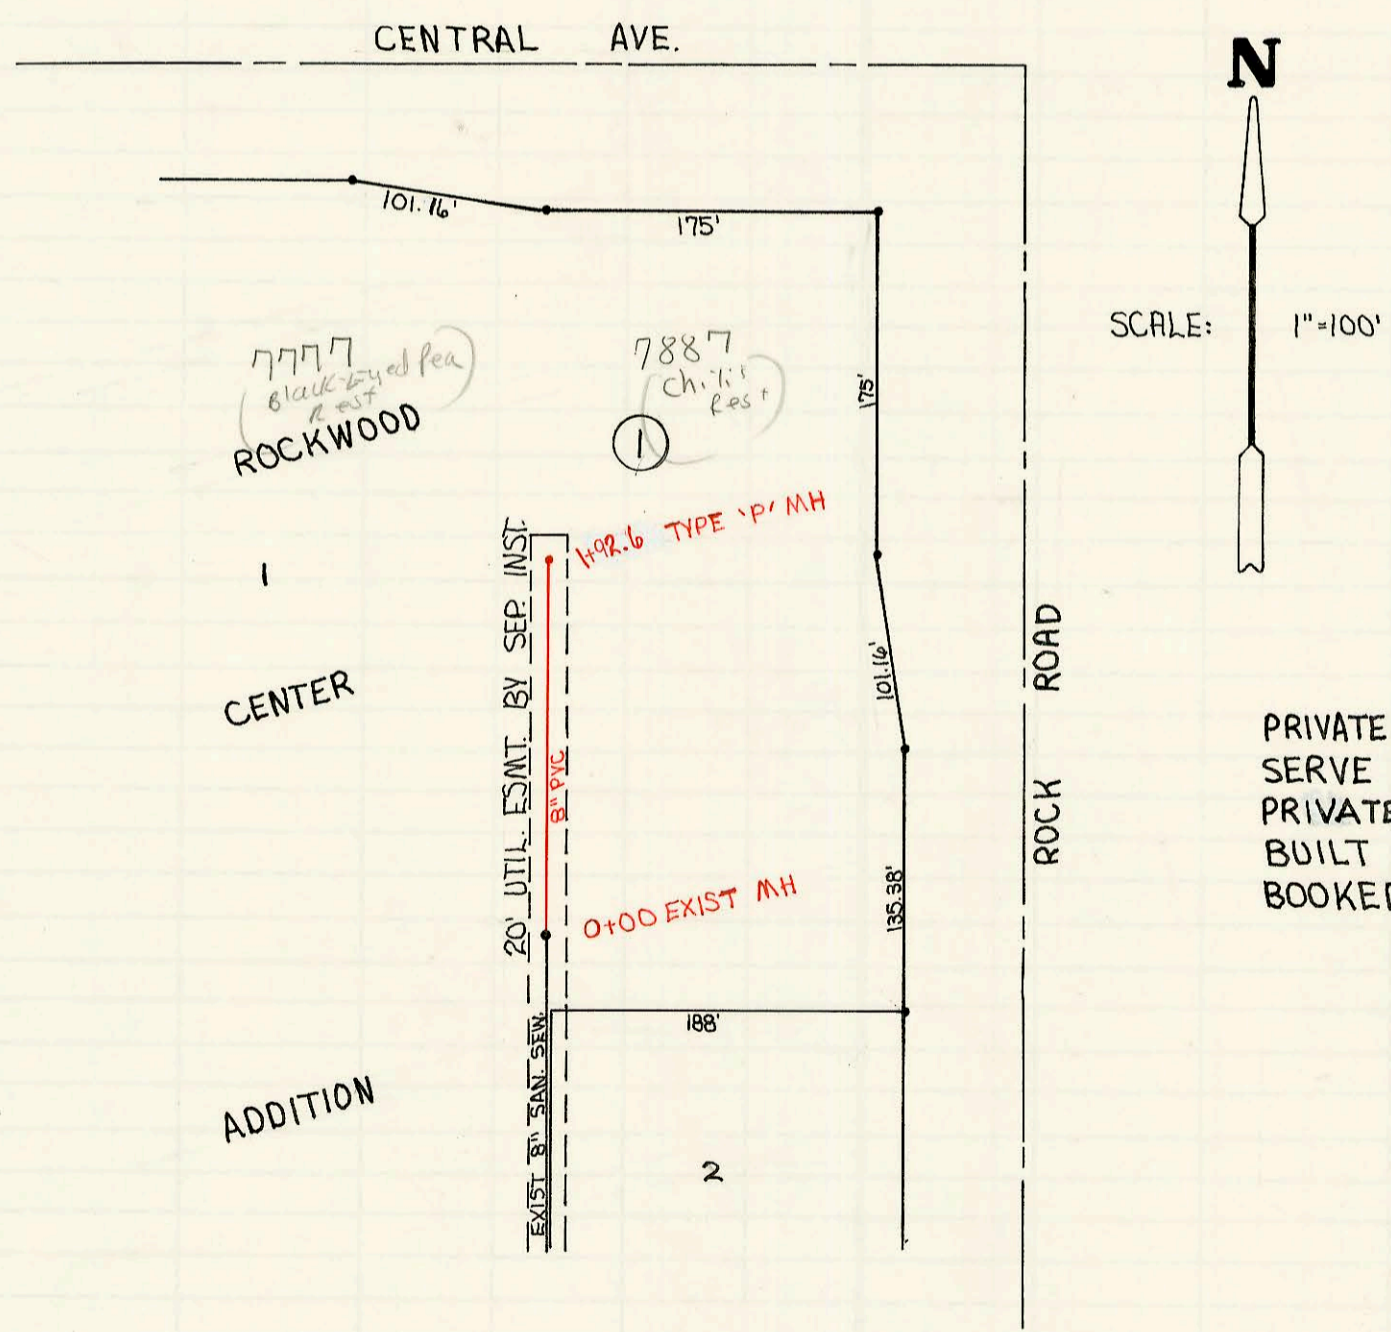

PRIVATE SANITARY SEWER EXTENSION TO SERVE ROCKWOOD CENTER, PHASE I
PRIVATE PROJ. NO. 289 (607861)
BUILT BY W. B. CARTER CONST. CO.
BOOKED 3-26-92 FROM AS BUILTS

CONSTRUCTION RECORD						SERVICE RECORD						
STATION	ELEVATION		Depth	MANHOLE	4-INCH "Y" BRANCHES		No. of Permit		House Number		DATE OF PERMITS	
	Ground	Grade			North West	South East	North West	South East	North West	South East	North West	South East
Private Sanitary Sewer To Serve Boeing Property Along MacArthur												
0+00	84.05	77.63 OUT 77.85 IN	6.4	0+00								
1+00	84.40	78.23	6.2									
2+00	85.20	78.62	6.6									
3+00	85.00	79.00	6.0									
4+00	85.44	79.19 OUT 79.35 IN	6.3	3+50								
4+00	84.70	79.55	5.2									
5+00	85.90	79.96	5.9									
	86.00	80.05	6.0	5+23.4		4" Stub SE	17204		2550 MacArthur		3-5-91	
Lateral 24, Main 24, WIS												
0+00	203.96	194.09 OUT 194.19 IN	9.9	0+00								
1+00	203.90	194.49	9.4			4" SCH 40 D+66.0 4" SCH 40 1+56.0 tap	94-26467		2406 Lindberg		10-8-93	
	203.80	194.77 OUT 194.87 IN	9.0	1+94.9	4" SCH 40 4" Stub NE		93-3667		2410 Lindberg		12-30-92	
2+00	203.50	194.89	8.6			4" SCH 40 3+16.3 tap N/E	93-17667		2414 Lindberg		1-28-93	
3+00	204.60	195.19	9.4			4" SCH 40 3+32.3 tap N/E	93-17687	93-159567	2413 Lindberg	2409 Lindberg	7-1-93	6-14-93
	207.20	195.44	11.8	3+82.9		4" SCH 40 4" Stub SW	92-43205		2416 Lindberg		11-20-92	
Private Sanitary Sewer Extension To Serve Rockwood Center, Phase 1												
0+00	161.61	156.54 OUT 156.61 IN	5.1	0+00								
1+00	165.90	157.62	8.3			4" SCH 40 6" Stub W/W	1245	1250	1777 Central	1787 Central	10-19-91	10-19-91
	165.19	157.35	7.8	1+92.6		4" SCH 40 6" Stub E						