


Bob Smith
 Son Corp
 263-4557 church
 Temp comm into sewer
 Bldg sewer for const treated
 MUST TRAP & SO when
 removed 9/18/96
 UNPLATTED

UNPLATTED

TRACT

Bishop's House
 7000 E 45th U

PRIVATE SANITARY SEWER EXTENSION TO SERVE
 THE CHURCH OF THE RESURRECTION
 PRIVATE PROJECT NO. 321 PPS (607861)
 BUILT BY NOWAK CONSTRUCTION CO.
 BOOKED 4-29-92 FROM AS BUILTS

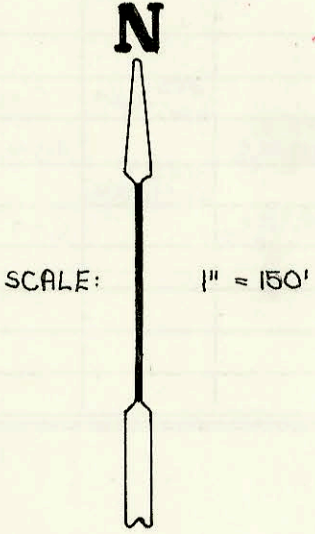

CONSTRUCTION RECORD						SERVICE RECORD						
STATION	ELEVATION		Depth	MANHOLE	4-INCH "Y" BRANCHES		No. of Permit		House Number		DATE OF PERMITS	
	Ground	Grade			North West	South East	North West	South East	North West	South East	North West	South East
Private Sanitary Sewer Extension To Serve The Church Of The Resurrection												
0+00	204.42	191.02 191.12 ^{ODT} IN	13.4	0+00								
1+00	205.00	191.62	13.4									
	205.00	191.93 ^{ODT} 192.13 IN	13.1	1+59.1	12" Stub NW							
2+00	205.90	192.51	13.4									
3+00	207.00	193.44	13.6									
	207.75	194.20 ^{ODT} 194.90 IN	13.6	3+81.2								
4+00	209.00	195.18	13.8									
5+00	211.00	196.66	14.3									
6+00	212.30	198.15	14.2									
7+00	213.30	199.64	13.7									
	213.30	200.60 ^{ODT} 200.60 IN	12.7	7+63.9								
8+00	214.00	201.05	13.0									
9+00	215.40	202.29	13.1									
10+00	217.50	203.54	14.0									
11+00	222.6	204.79	17.8									
	223.19	205.40 ^{ODT} 205.09 IN	17.8	11+48.9								
12+00	224.00	205.65	18.4									
13+00	222.80	206.76	16.0									
14+00	220.00	207.88	12.1									
15+00	218.30	208.99	9.3									
	218.92	209.37 ^{ODT} 209.40 IN	9.6	15+33.9								
16+00	220.80	210.41	10.4									
17+00	222.30	211.95	10.4									
18+00	223.80	213.49	10.3									
	225.59	214.79 ^{ODT} 214.84 IN	10.8	18+83.9								
19+00	226.10	215.07	11.0									
20+00	227.50	216.53	11.0									
21+00	229.90	217.99	11.9									
	230.54	218.49 ^{ODT} 218.52 IN	12.1	21+33.9								
22+00	232.30	218.86	13.4									
23+00	234.10	219.37	14.7									
	235.12	219.82 ^{ODT} 219.87 IN	15.3	23+86.6								
24+00	235.00	219.92	15.1									
					6" SDR-35 4" Fall M.H. Stub		2371		4910 Church Woodlawn		4-15-92	
25+00	232.50	220.36	12.1									
	231.07	220.52	10.6	25+36.6	4" SDR-35 4" Stub NE		(See below) 2370		4910 - 2 mod. ltr Woodlawn Bldg		4-15-92	