



12/12/95

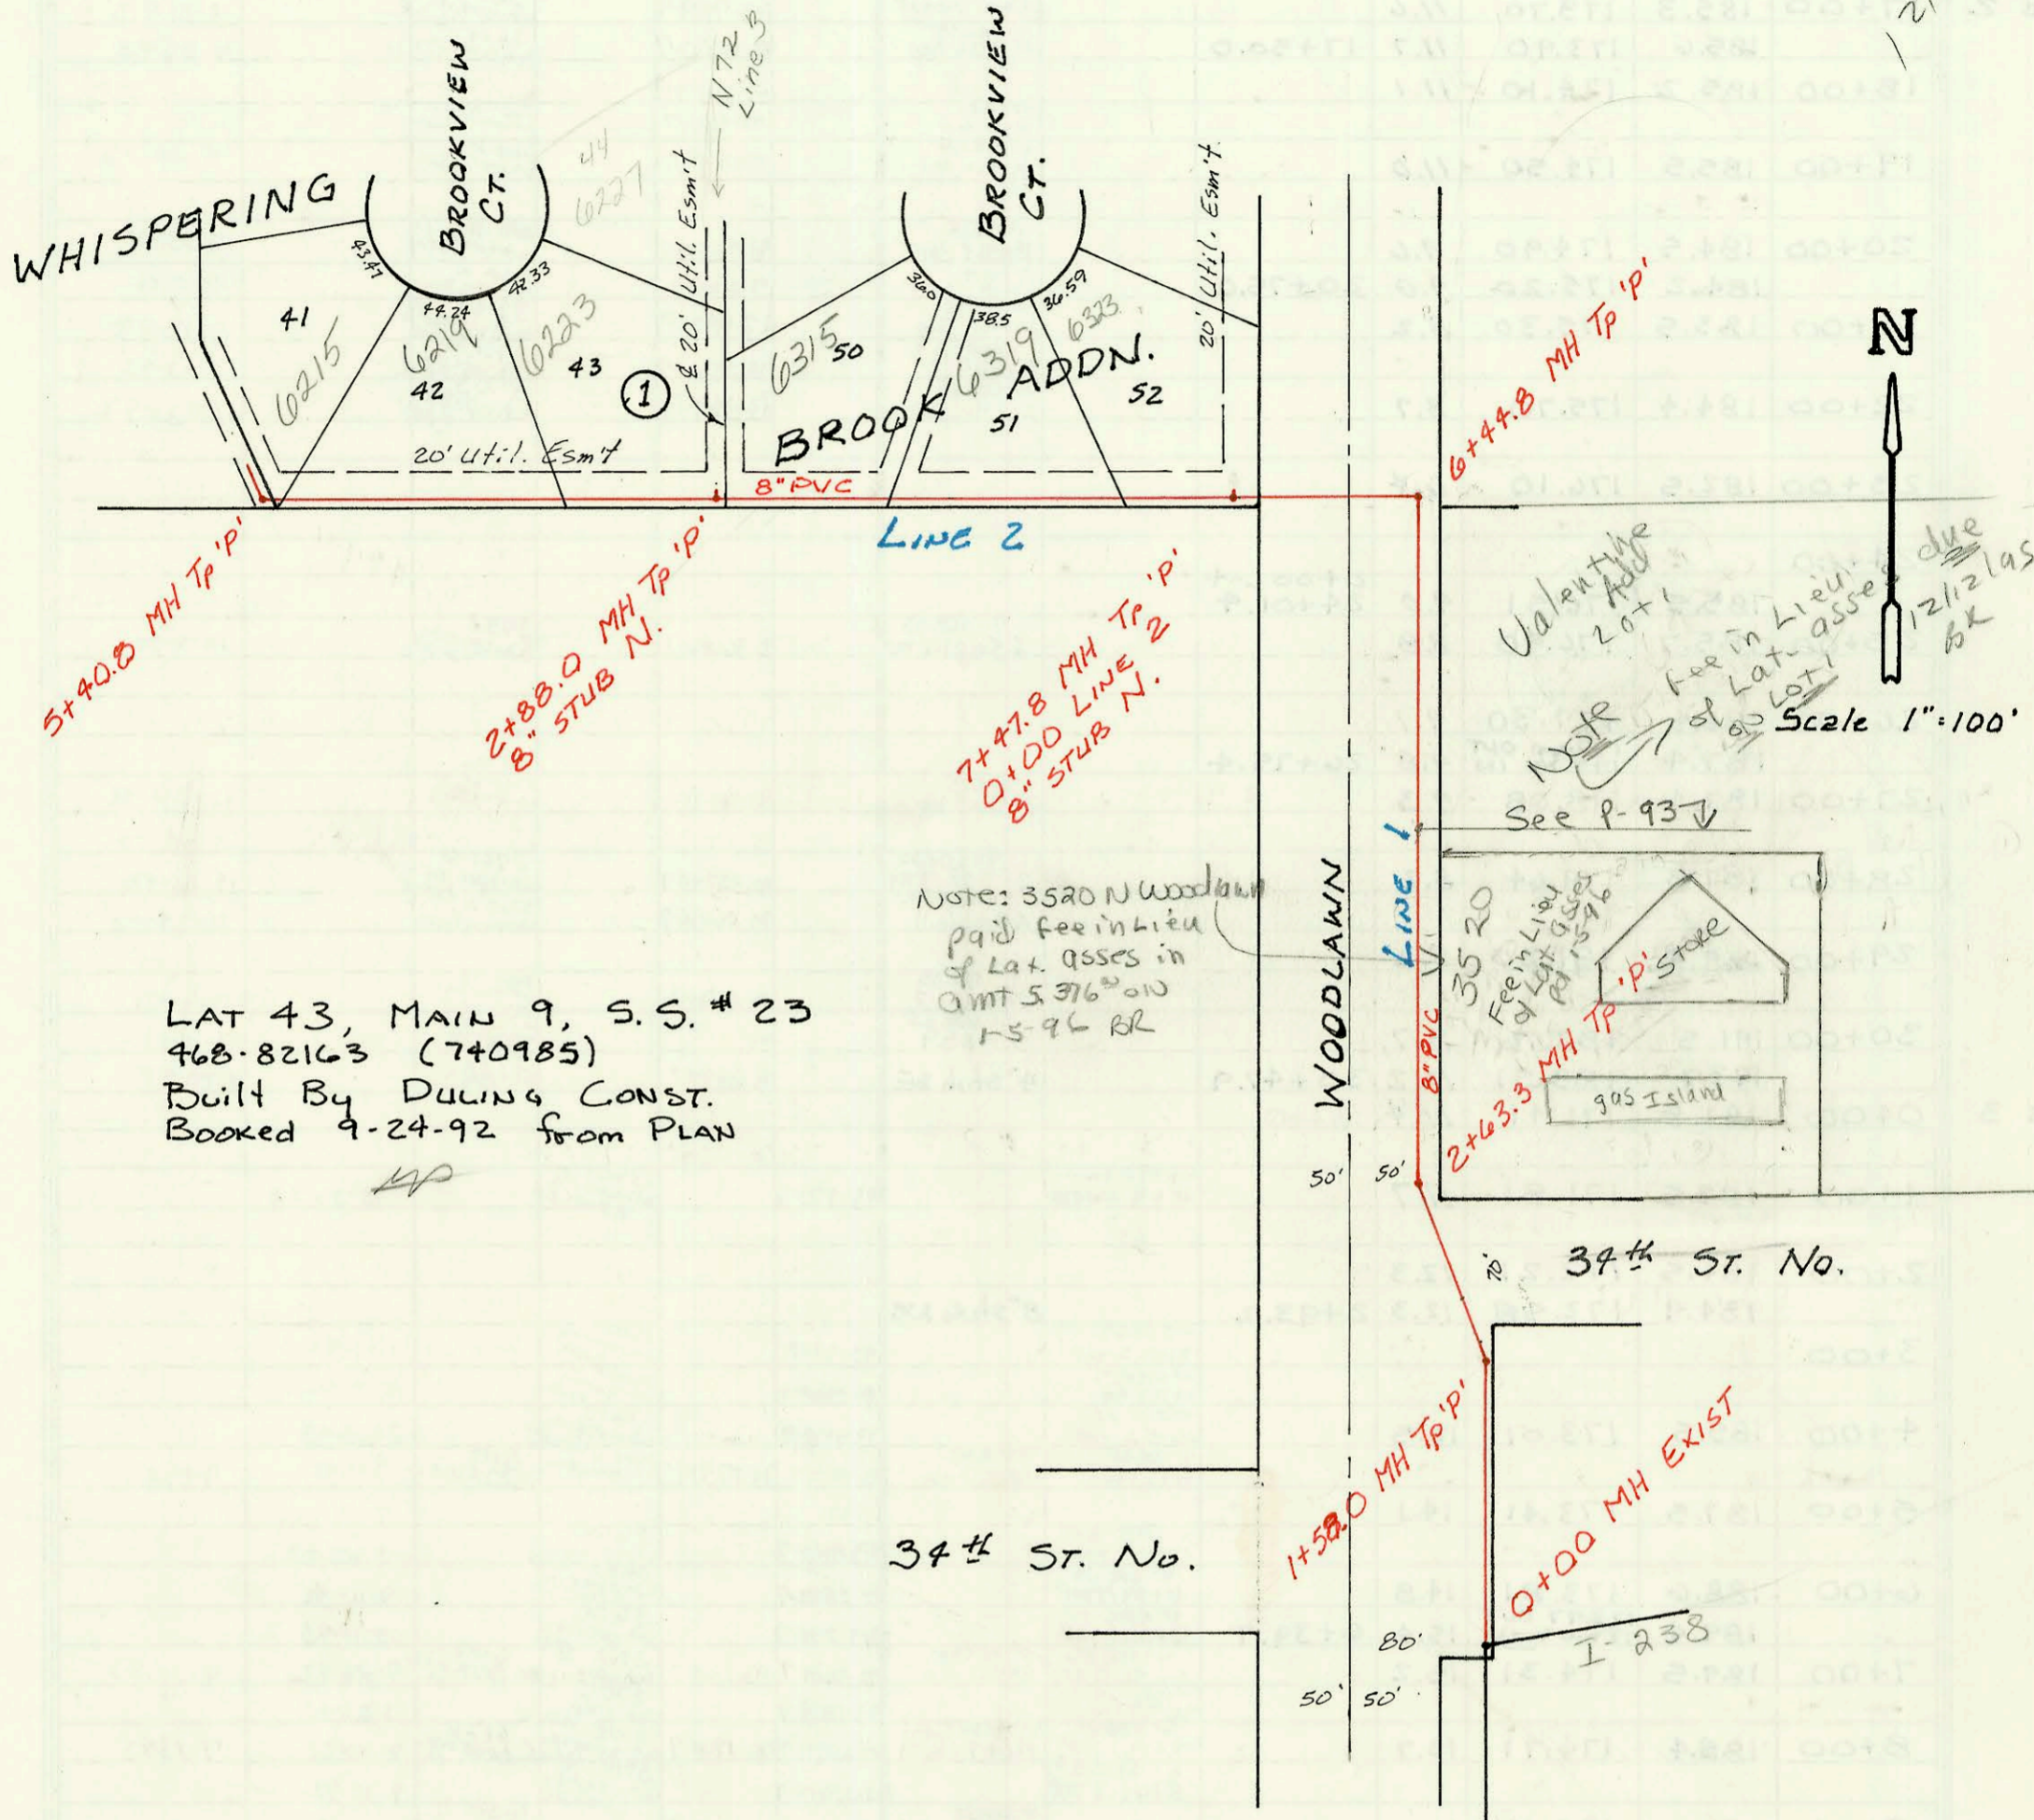

LAT 43, MAIN 9, S.S. # 23
 468-82163 (740985)
 Built By DULING CONST.
 Booked 9-24-92 from PLAN

NOTE: 3520 N Woodlawn
 paid fee in lieu
 of Lat. asses in
 QMT 5376 010
 1-5-96 BR

Valentine
 Add
 Note Fee in Lieu
 of Lat. asses
 due
 12/12/95
 BK
 Scale 1"=100'

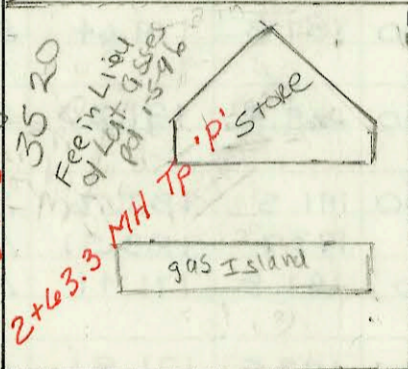

CONSTRUCTION RECORD						SERVICE RECORD						
STATION	ELEVATION		Depth	MANHOLE	4-INCH "Y" BRANCHES		No. of Permit		House Number		DATE OF PERMITS	
	Ground	Grade			North West	South East	North West	South East	North West	South East	North West	South East
LAT 43, MAIN 9, S.S. # 23												
LINE 1 0+00	170.87	153.82	17.1	0+00								
1+00	161.3	157.47	3.8									
	173.98	159.58 OUT 162.30 IN	14.4 10.7	1+58.0								
2+00	173.8	163.97	9.8									
	174.86	164.98 OUT 165.06 IN	9.9	2+63.3								
3+00	170.5	165.16	5.3									
4+00	173.9	165.43	8.5									
5+00	175.5	165.70	9.8									
6+00	177.4	165.97	11.7									
	179.37	166.09 OUT 166.10 IN	13.3	6+44.8								
7+00	179.5	166.31	13.2									
	178.50	166.50	12.0	7+47.8	8" stub N							
LINE 2 0+00	178.50	166.50	12.0	0+00								
1+00	178.5	166.90	11.6									
2+00	178.5	167.30	11.2									
	178.1	167.65	10.5	2+88.0	8" stub N							
3+00												
4+00	177.6	168.10	9.5									
5+00	177.5	168.50	9.0									
	177.8	168.66 OUT 168.76 IN	9.1	5+40.8								
6+00	177.8	169.00	8.8									
7+00	177.5	169.40	8.1									
	179.2	169.49 OUT 169.59 IN	9.7	7+22.7	8" stub N							
8+00	179.0	169.90	9.1									
9+00	179.2	170.30	8.9									
	180.6	170.56 OUT 170.66 IN	10.0	9+65.1								
10+00	181.0	170.80	10.2									
11+00	182.4	171.20	11.2									
	182.8	171.31	11.5	11+26.8								
12+00	183.5	171.60	11.9									
13+00	183.5	172.00	11.5									
14+00	183.3	172.40	10.9									
	183.5	172.49 OUT 172.59 IN	11.1	14+21.5								
15+00	184.1	172.40	11.2									
16+00	185.0	173.30	11.7									
(CONT ON N-39)												

93-17575-7 7-1-93 6119 E Brookview-tap 4" SDR35 127' w of a MHT (this does not appear to be a good MHT)

UNRECORDED
UNRECORDED