



N

SCALE: 1" = 100'

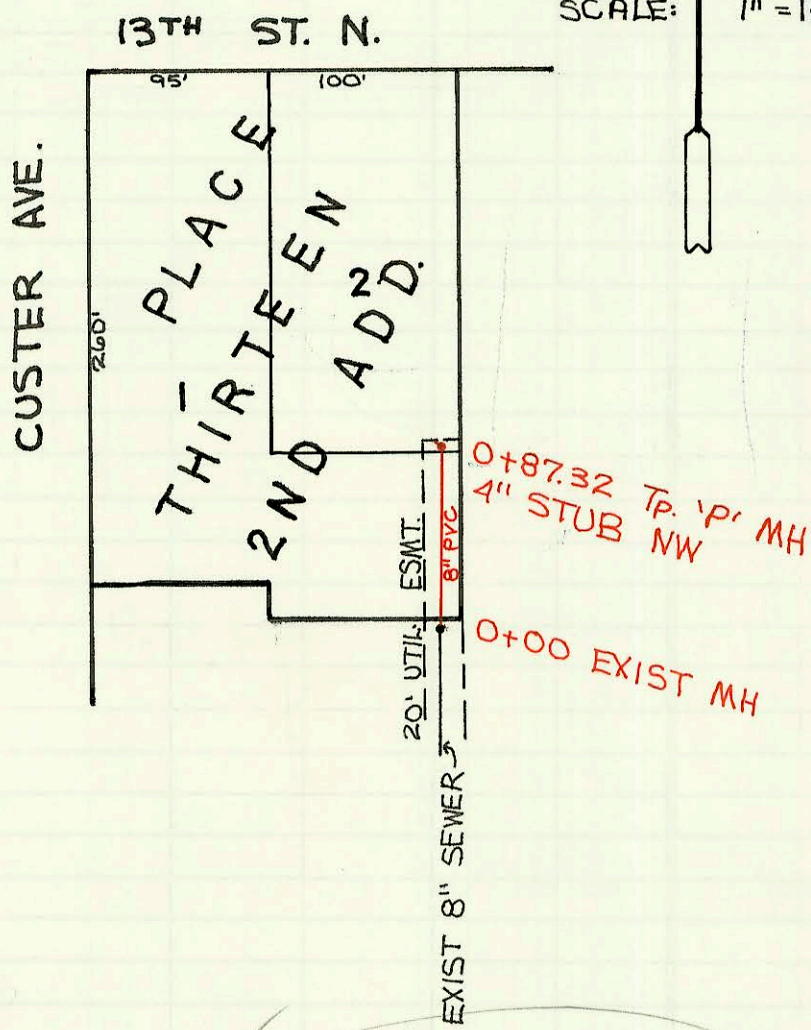

PRIVATE SANITARY SEWER TO SERVE
PLACE THIRTEEN 2ND ADDITION
PRIVATE PROJECT NO. 360PPS (607861)
BUILT BY W. B. CARTER CONSTRUCTION CO.
BOOKED 1-29-93 FROM AS BUILTS

CAMBRIDGE ESTATES

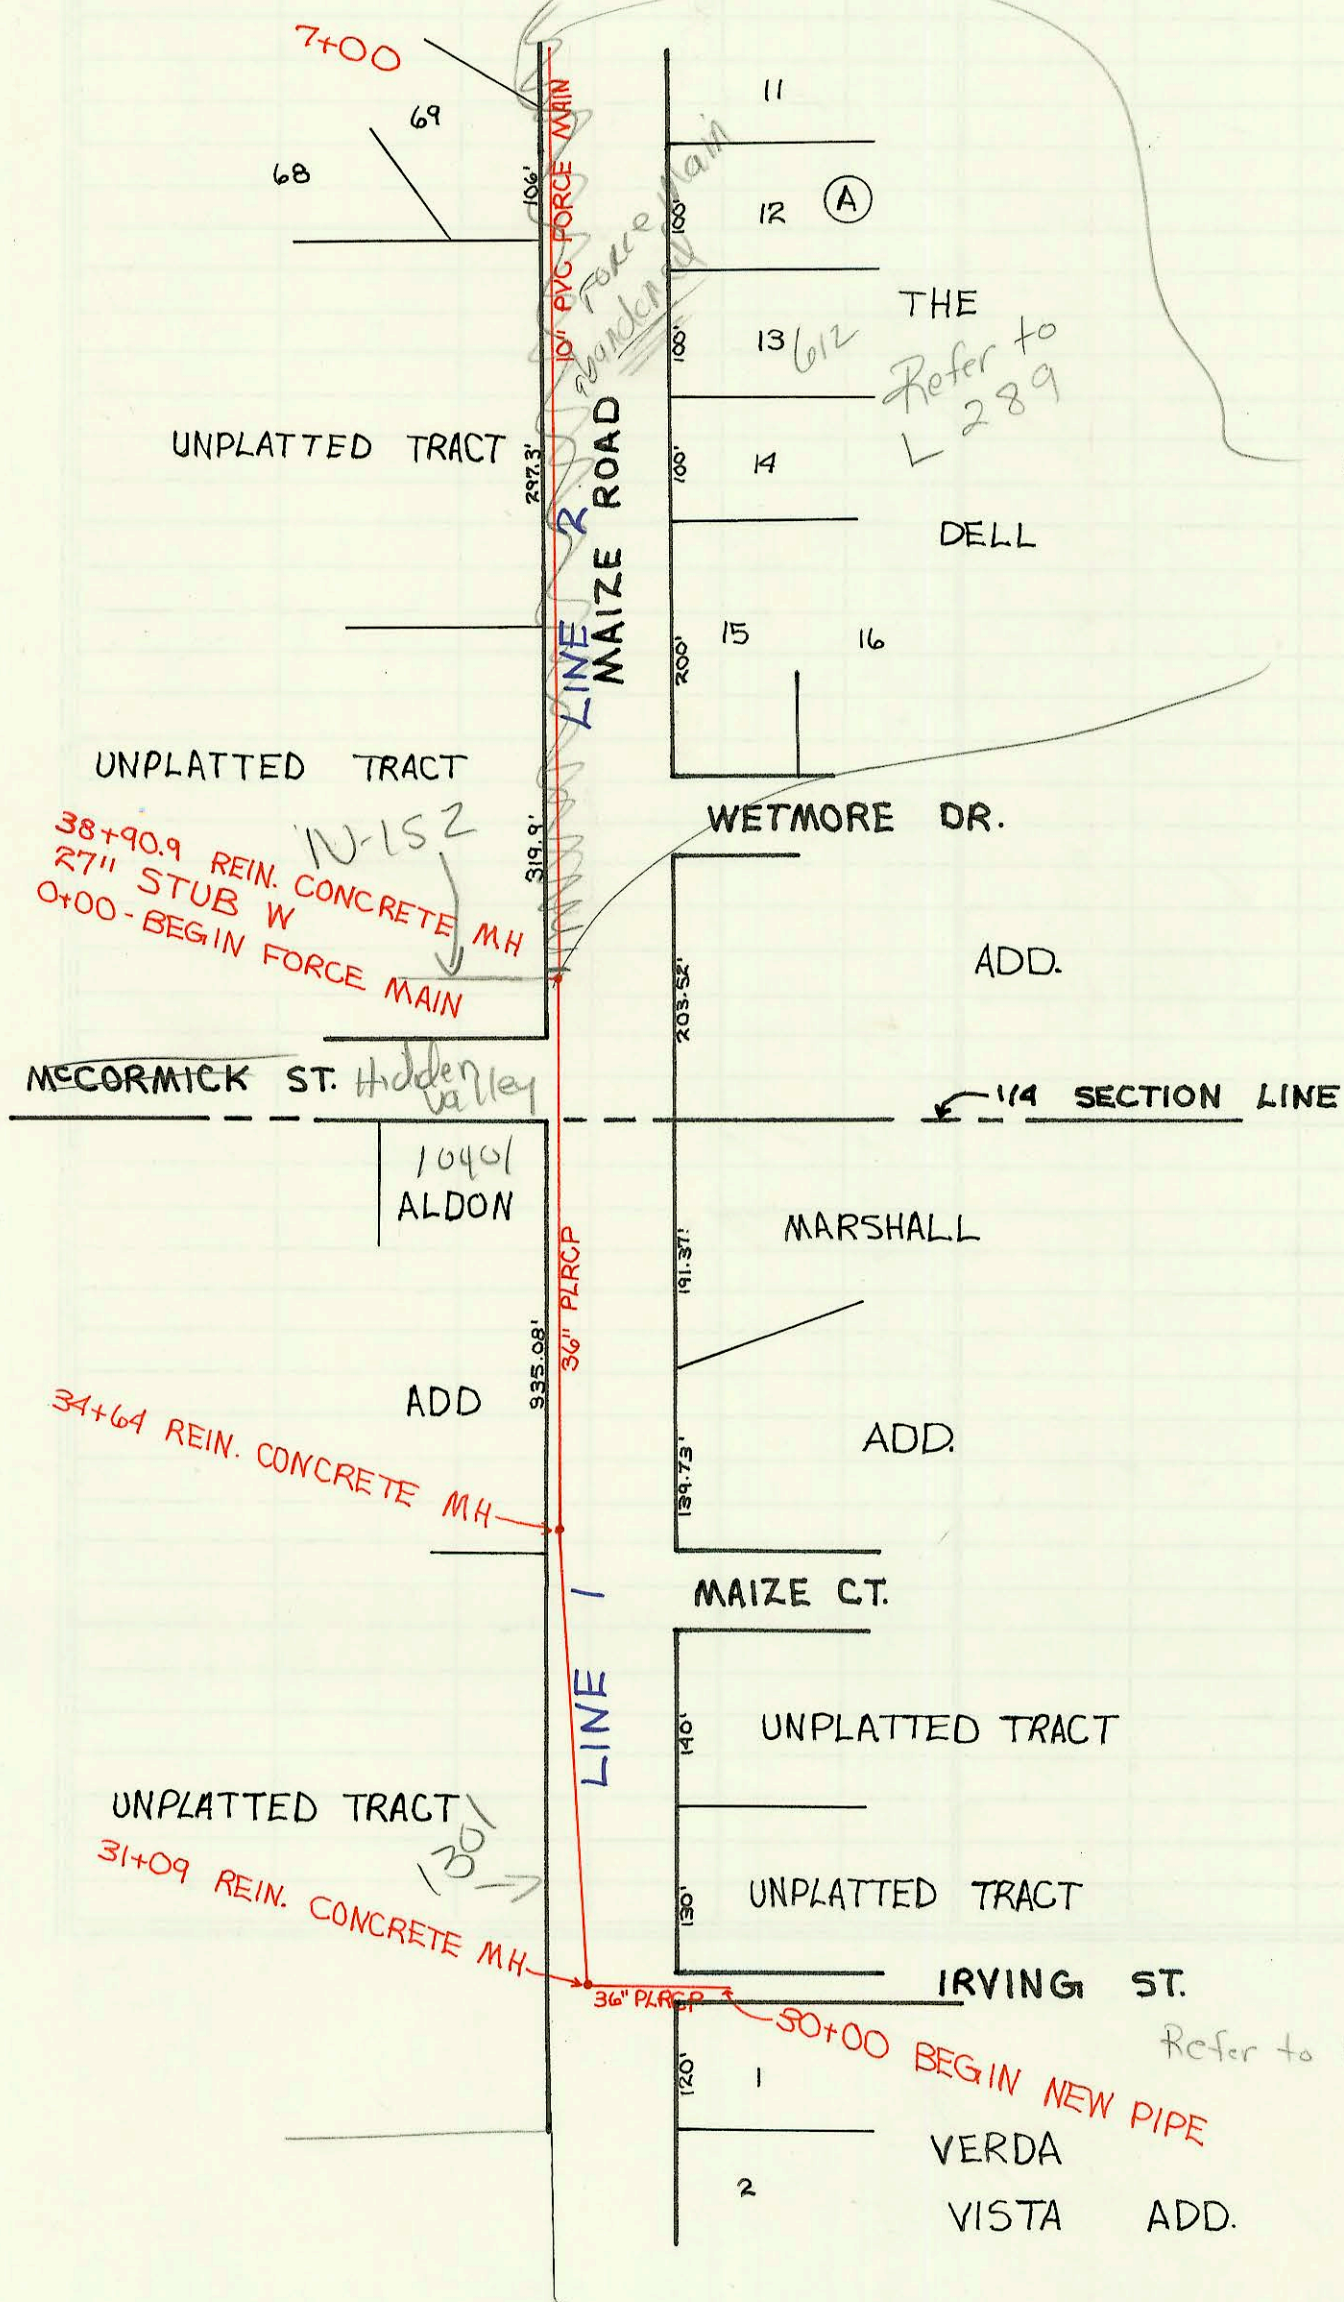

PHASE I
MAIN 1, COWSKIN INTERCEPTOR SEWER
PROJ. NO. 468-82001 (725028)
BUILT BY WILDCAT CONSTRUCTION CO.
BOOKED 2-5-93 FROM AS BUILTS

*10" Force Main
inactive per
Bill Perkins
5/9/02
BSR*

*Not shown
in AR 1110*

N

SCALE: 1" = 150'

CONSTRUCTION RECORD						SERVICE RECORD						
STATION	ELEVATION		Depth	MANHOLE	4-INCH "Y" BRANCHES		No. of Permit		House Number		DATE OF PERMITS	
	Ground	Grade			North West	South East	North West	South East	North West	South East	North West	South East
Private Sanitary Sewer To Serve Place Thirteen 2nd Add.												
0+00	126.26	116.38 OUT 116.99 IN	10.0	0+00								
	127.45	117.80	9.7	0+86.32	4" Stub NW							
Main 1, Cowskin Interceptor Sewer - Phase 1												
LINE 1 30+00	136.40	107.21	29.2									
31+00	137.00	107.29	29.7									
	137.70	107.30	30.4	31+09								
32+00	135.40	107.37	28.0									
33+00	132.00	107.45	24.6									
34+00	130.50	107.53	23.0									
	127.90	107.59	20.3	34+64								
35+00	118.50	107.62	10.9									
36+00	124.00	107.70	16.3									
37+00	126.10	107.78	18.3									
LINE 2 38+00	127.60	107.86	19.7									
0+00	127.70	107.93 OUT 121.50 IN	19.8	38+90.9	27" Stub W							
1+00	127.00	122.43	4.6									
2+00	126.60	123.35	3.3									
3+00	129.80	126.46	3.3									
4+00	133.00	129.57	3.4									
5+00	136.10	131.93	4.2									
6+00	137.60	132.07	5.5									
7+00	137.20	132.20	5.0									