
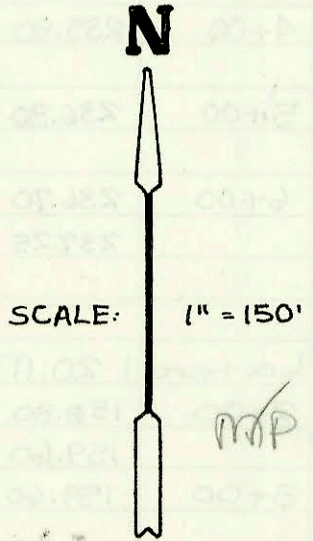


LATERAL 8, MAIN 1, COWSKIN INTERCEPTOR SEWER  
PROJ. NO. 468-82103 (741058)  
BUILT BY UTILITY CONTRACTORS CO.  
BOOKED 7-15-93 AS PER PLAN

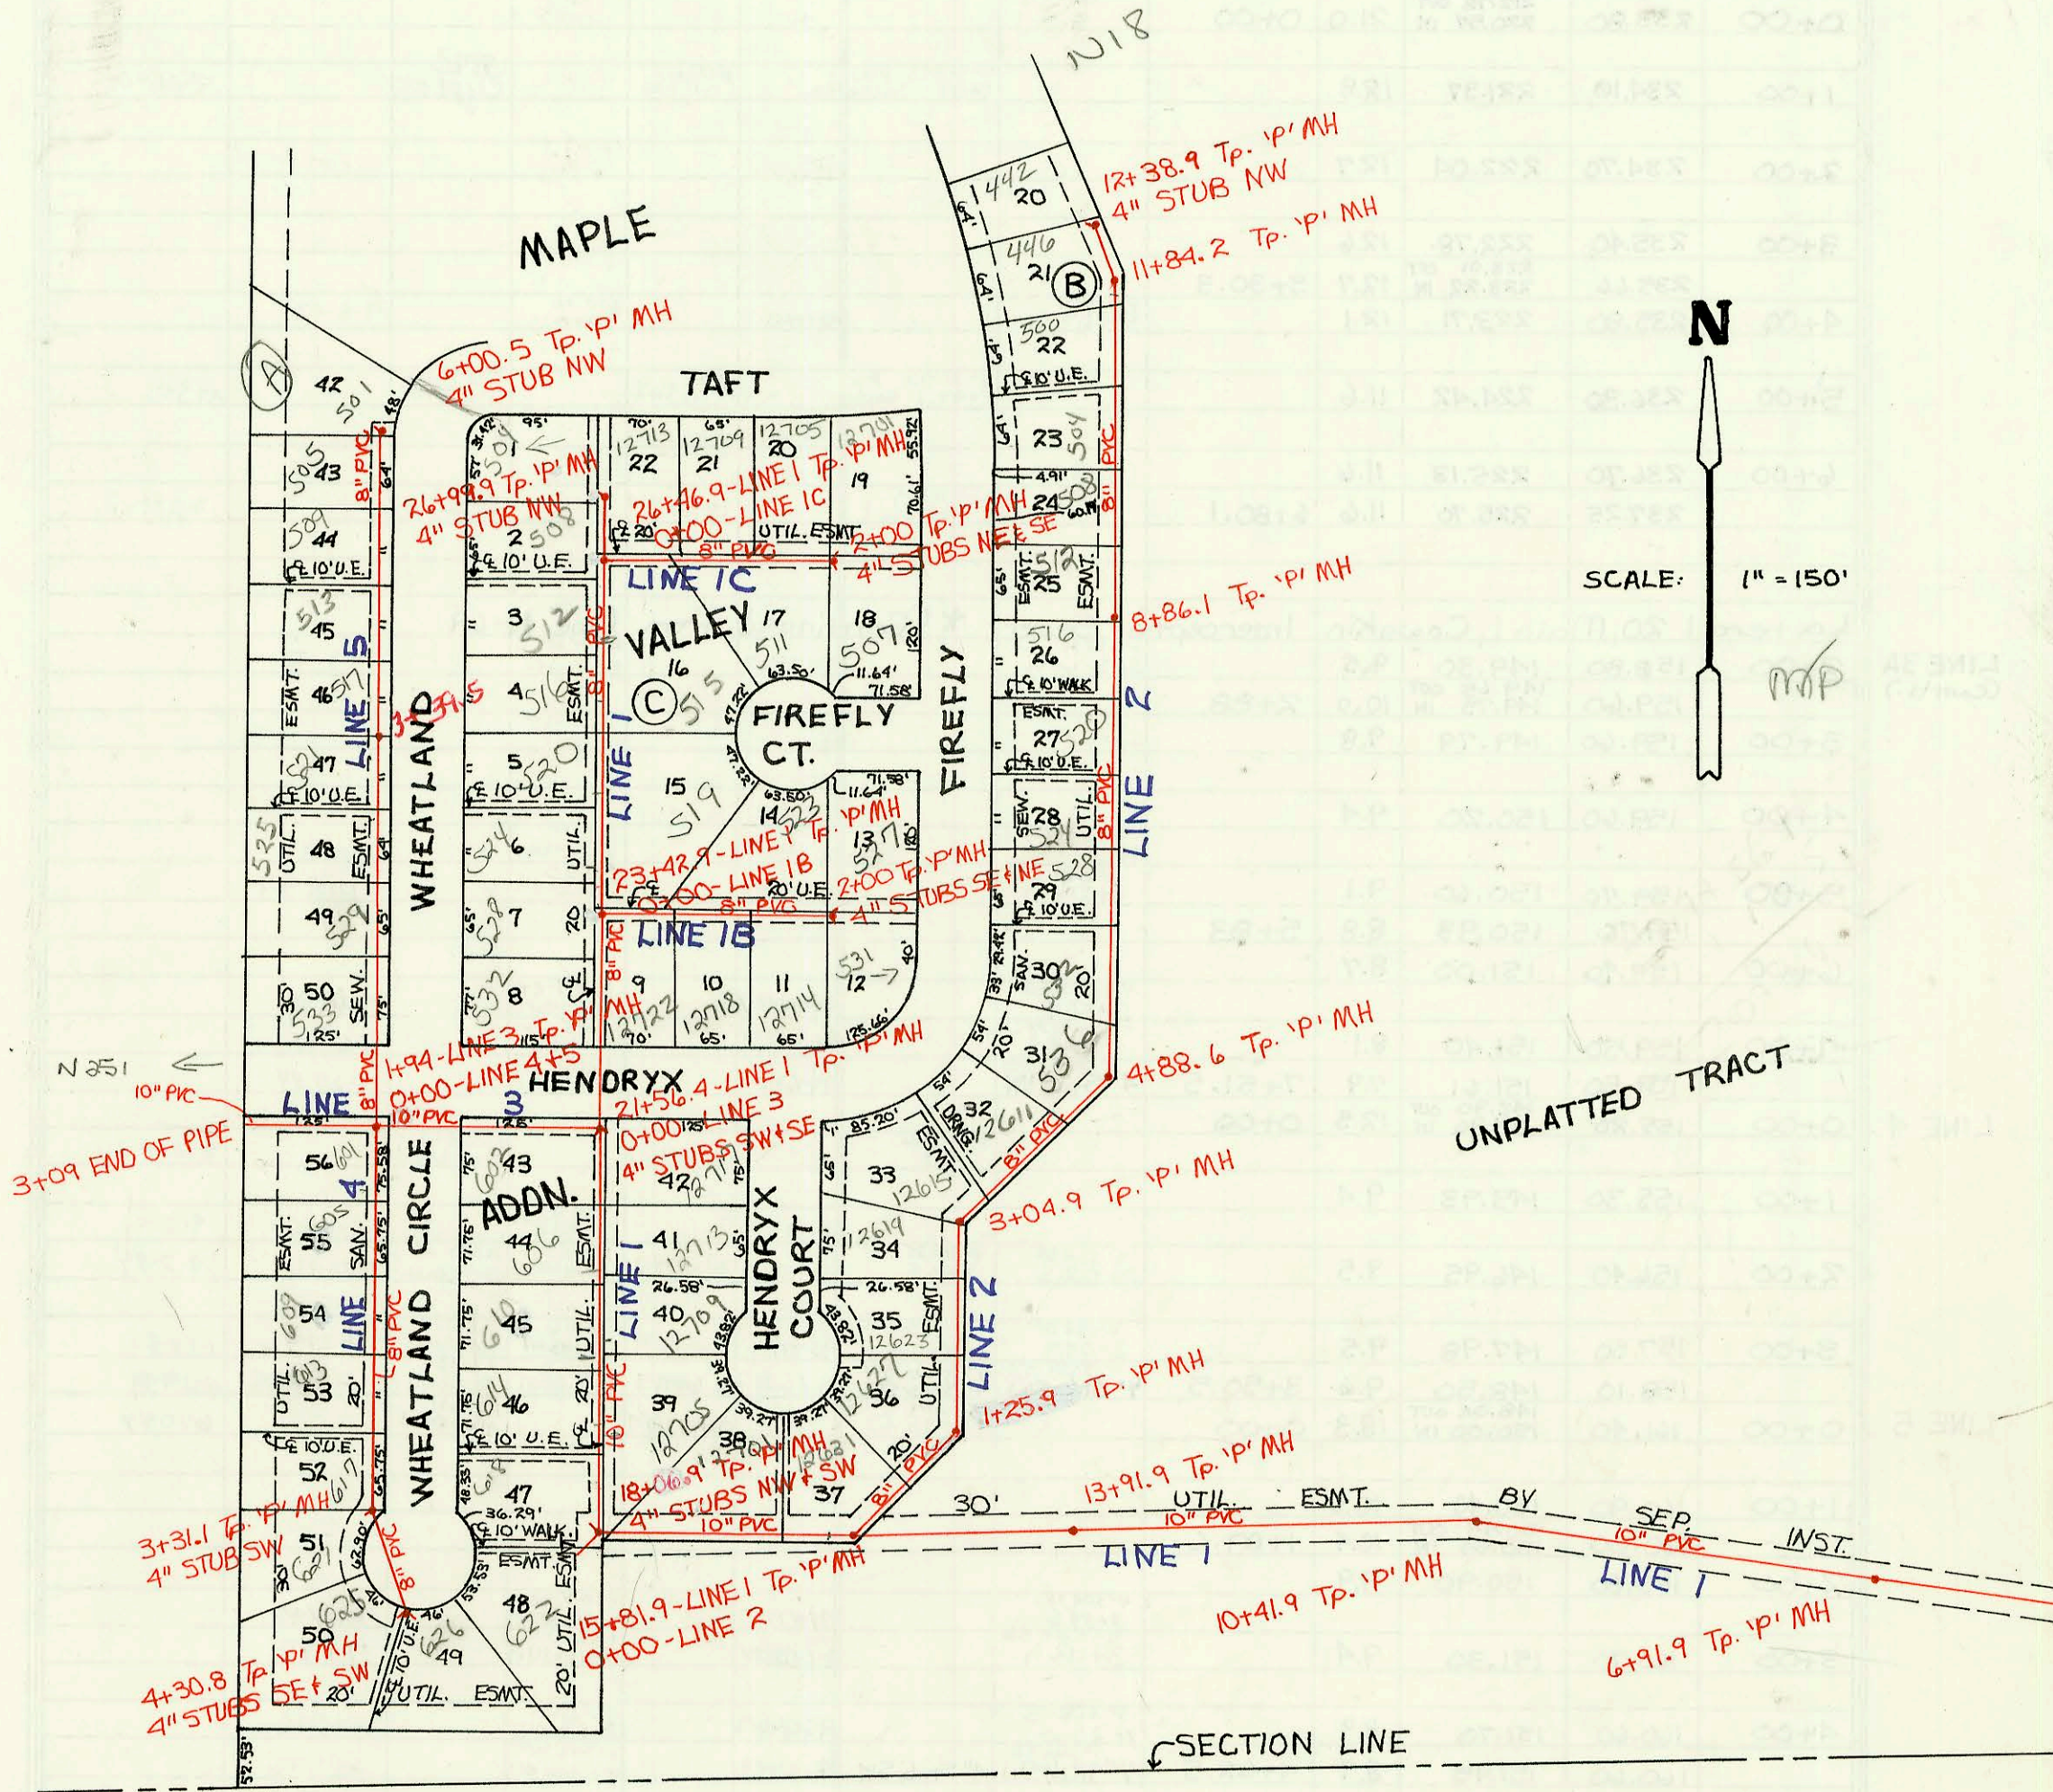

UNPLATTED TRACT

21<sup>ST</sup> ST. NORTH

LATERAL 30, DISTRICT E, S.S.#12  
PROJ. NO. 468-82284 (741454)  
BUILT BY W. B. CARTER CONST. CO.  
BOOKED 7-21-93 AS PER PLAN

