


LATERAL 31, MAIN 15, S.W.I.
PROJ. NO. 468-82274 (741405)
BUILT BY DULING CONST. CO.
BOOKED 7-22-93 AS PER PLAN



SCALE: 1" = 100'
MVP

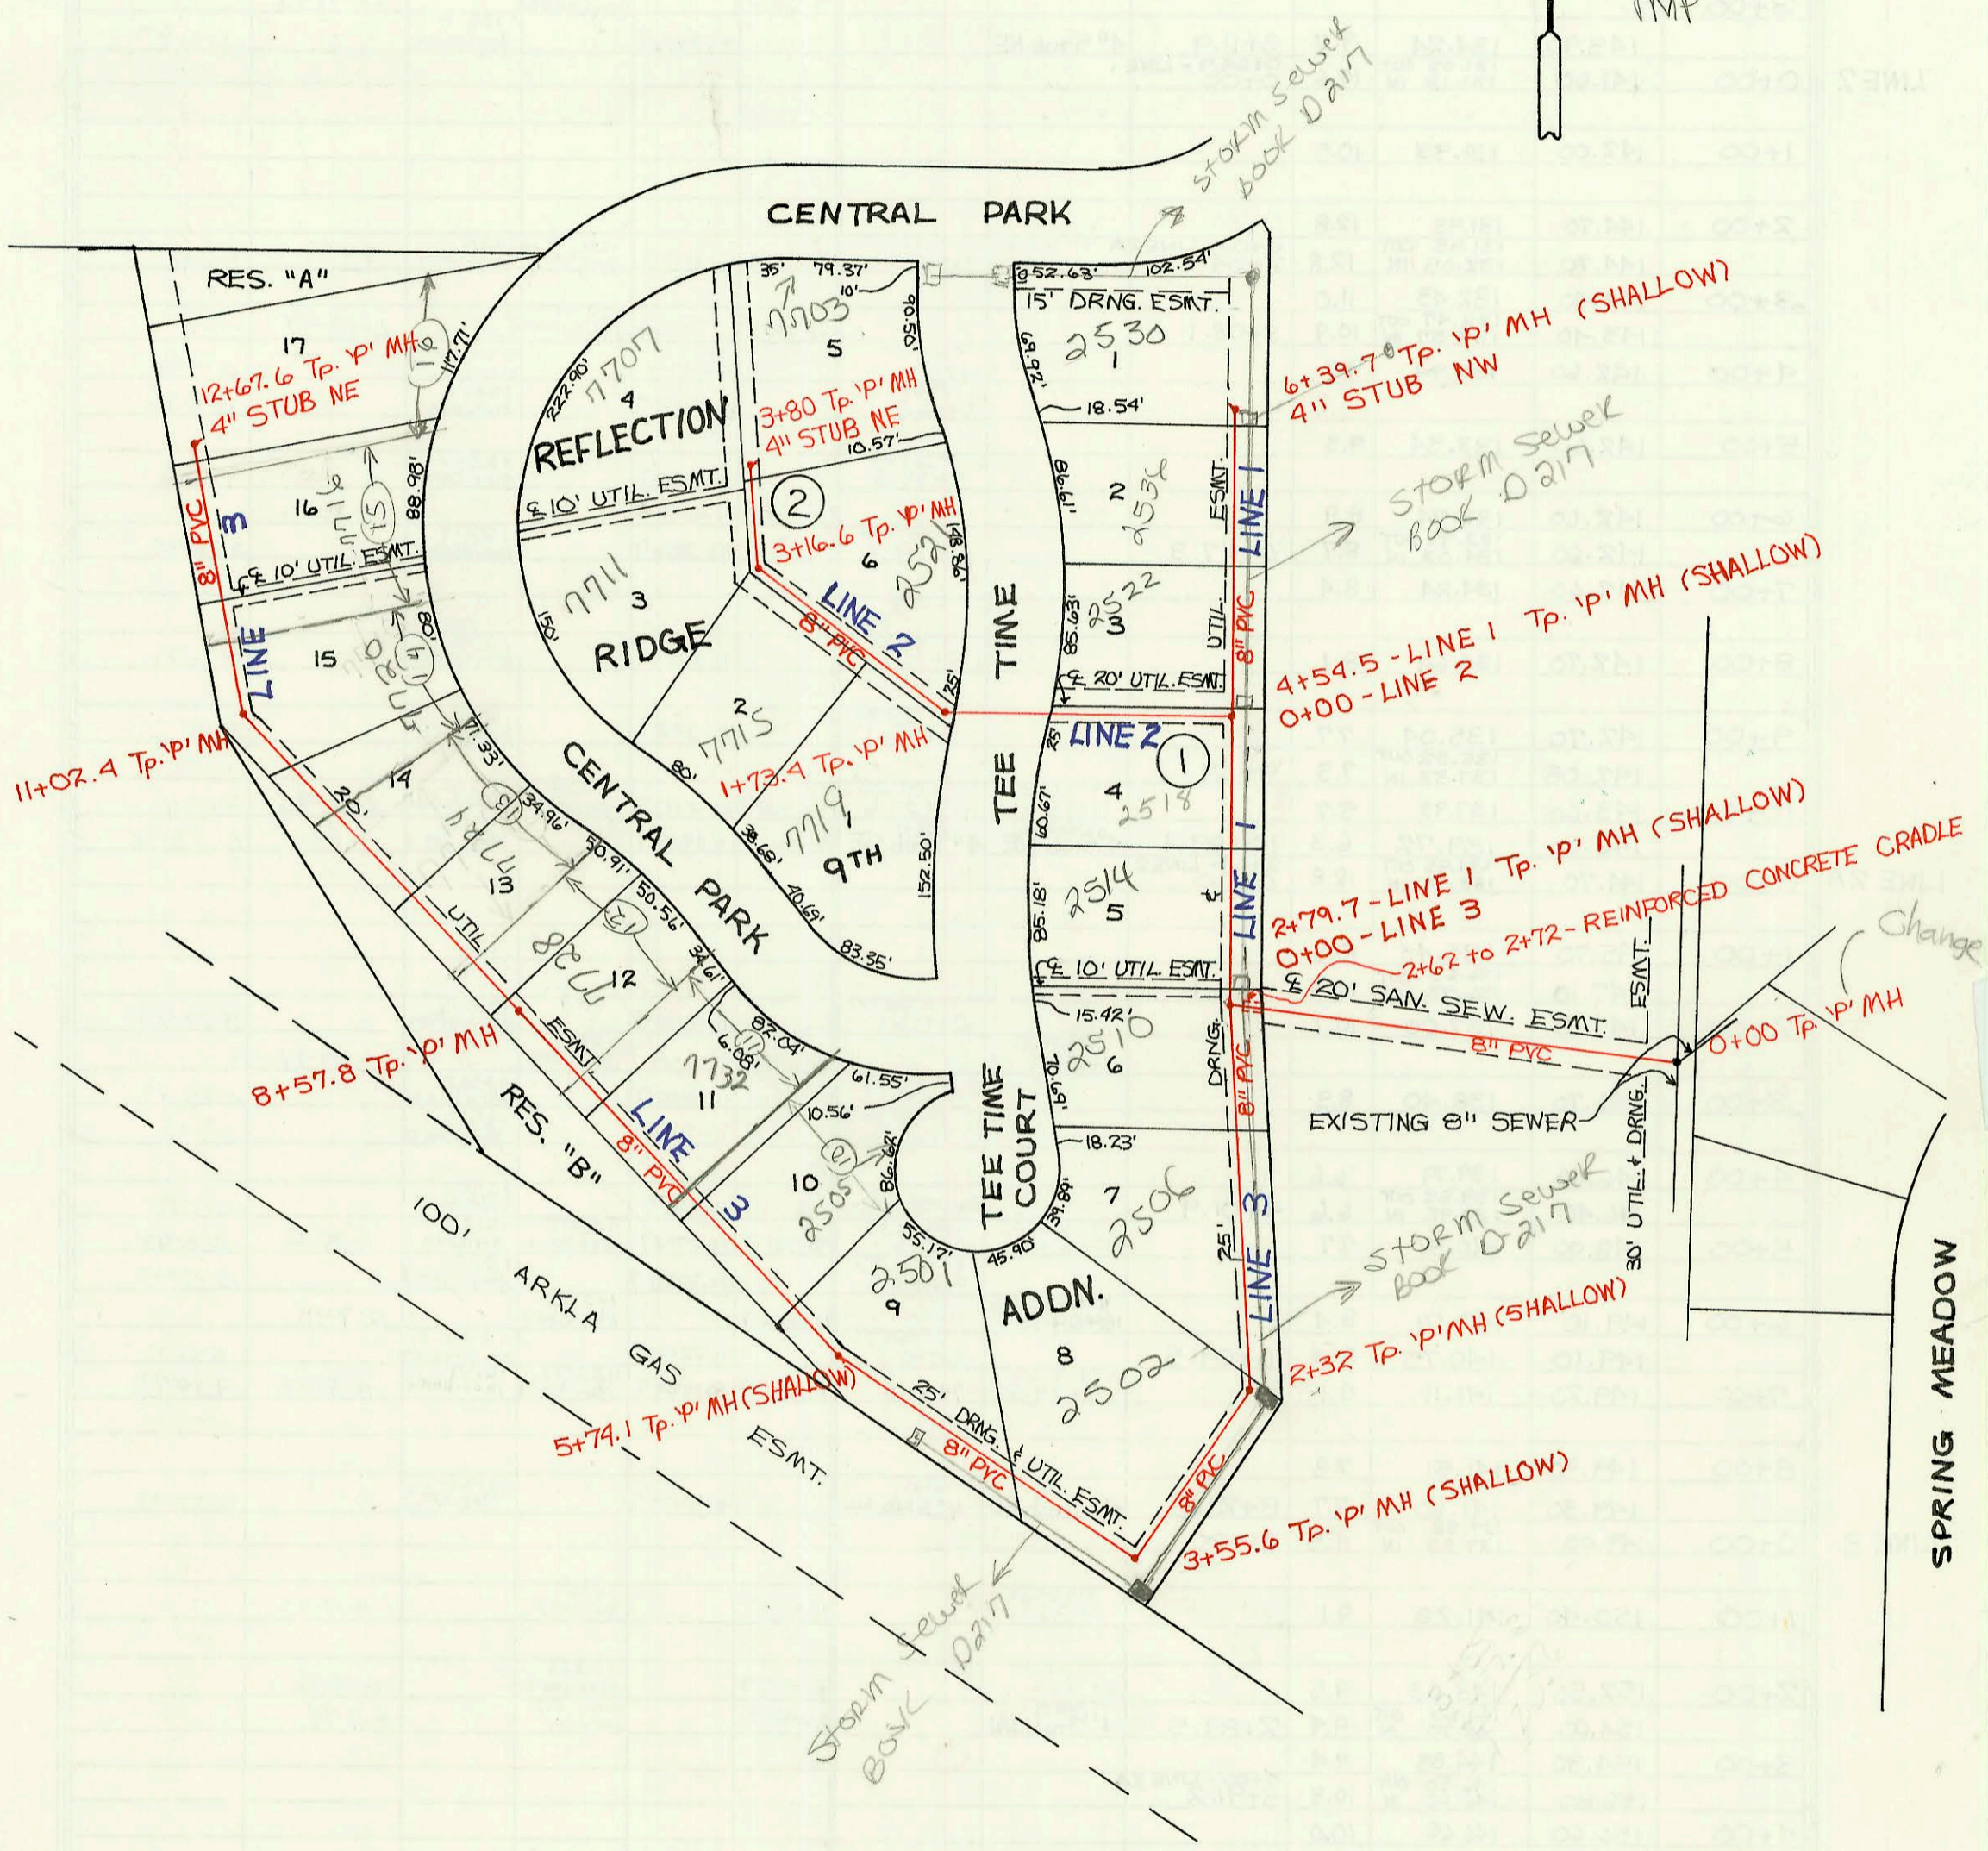

CONSTRUCTION RECORD						SERVICE RECORD						
STATION	ELEVATION		Depth	MANHOLE	4-INCH "Y" BRANCHES		No. of Permit		House Number		DATE OF PERMITS	
	Ground	Grade			North West	South East	North West	South East	North West	South East	North West	South East
LINE 1 Lateral 31, Main 15, SW1	0+00	143.85	136.66 OUT 136.68 IN	7.2	0+00							
	1+00	145.20	136.98	8.2								
	2+00	145.20	137.28	7.9								
		148.60	137.52 OUT 137.62 IN	5.1	0+00 - LINE 3 2+79.7							
	3+00	142.10	137.68	4.1								
	4+00	143.50	137.98	5.5		4" SDR 35 4+36.5	94-5387		2514 Tree Time		3-19-99	
		143.50	138.14	5.4	0+00 - LINE 2 4+54.5	4" PVC 40 4+91.5	95-12458-7		2513 Tree Time		8-9-95	
5+00	143.50	138.28	5.2			94-6319-7		2522 Tree Time		4-29-94		
6+00	143.50	138.58	4.9		4" SDR 35 5+88.7 + cap	93-20114-7		2506 Tree Time		11-30-93		
LINE 2	0+00	143.40	138.70	4.7	6+39.7	4" Stub NW	2003 03297		2520 Tree Time		12-16-03	
		143.50	138.14 OUT 138.24 IN	5.3	4+54.5 - LINE 1 0+00							
	1+00	146.50	138.54	8.0								
	1+00	146.60	138.76	7.8	1+73.4	4" SDR 35 1+89.4	94-3268-7		1719 Central PK		3-11-94	
2+00	146.80	138.84	8.0									
3+00	148.40	139.14	9.3		3+06.6		93-2751-7		1715 Central PK		10-19-93	
		139.19 OUT 139.29 IN	9.9	3+16.6	3+35.0	4" SDR 35 3+48.0	95-1919-7	95-1908-7	1711 Central PK	2521 Tree Time	11-20-95	11-8-95
	149.10	139.29	9.9	3+16.6	4" SDR 35 3+75		94-1907-7		1707 Central PK		12-1-94	
	148.70	139.48	10.8	3+80	4" Stub NE		97-2477		1703 Central PK		2-25-97	
LINE 3	0+00	142.60	137.52 OUT 137.62 IN	5.1	2+79.7 - LINE 1 0+00							
						4" SDR 35 0+43.0		96-1332-7		2510 Tree Time		8-13-96
	1+00	143.70	137.92	5.8								
						4" S.D.H. 40 P.V.C. 1+52.4		95-2347-7		2506 N Tree Time CR		2-21-95
	2+00	143.00	138.22	4.8								
		142.90	138.32	4.6	2+32							
	3+00	143.50	138.52	5.0				2001- 02966		2502 N Tree Time CR		11-20-01
		144.40	138.69 OUT 138.79 IN	5.7	3+55							
	4+00	144.40	138.92	5.5								
	5+00	144.50	139.22	5.3								
		144.80	139.44	5.4	5+74.1			2003- 01018		2501 Tree Time		4-16-03
	6+00	144.90	139.52	5.4				97-1792-7		2505 Tree Time		10-13-97
	7+00	146.40	139.82	6.6				8052- 02029		1732 Central PK		9-6-01
	8+00	148.00	140.12	7.9								
	149.20	140.29	8.9	8+57.8		4" SDR 35 8+81.3	95-1870-7		1718 Central PK		11-2-95	
9+00	149.50	140.42	9.1			4" SDR 35 9+34.8	95-3128-7		1724 Central PK		11-21-93	
10+00	151.00	140.72	10.3									
						4" SDR 35 10+89.4	94-5533-7		1720 Central PK		4-13-94	
11+00	152.60	141.02	11.6									
	152.60	141.03	11.6	11+02.4								
12+00	151.00	141.32	9.7			4" SDR 35 12+02.4	94-3264-7		1716 Central PK		3-11-94	
	150.20	141.52	8.7	12+67.6	4" Stub NE							