



PRIVATE SANITARY SEWER TO SERVE  
BERKSHIRE III APARTMENT COMPLEX  
PRIV. PROJ. NO. 373 PPS (607861)  
BUILT BY NOWAK CONSTRUCTION CO.  
BOOKED 10-25-93 FROM AS BUILTS

SCALE: 1" = 150'



PRIVATE SANITARY SEWER EXTENSION  
TO SERVE GOLF PARK WEST ADDITION  
PRIV. PROJ. NO. 549 PPS (607861)  
BUILT BY JERRY BERGERMAN CO.  
BOOKED 8-3-95 FROM AS BUILTS

21ST STREET NORTH

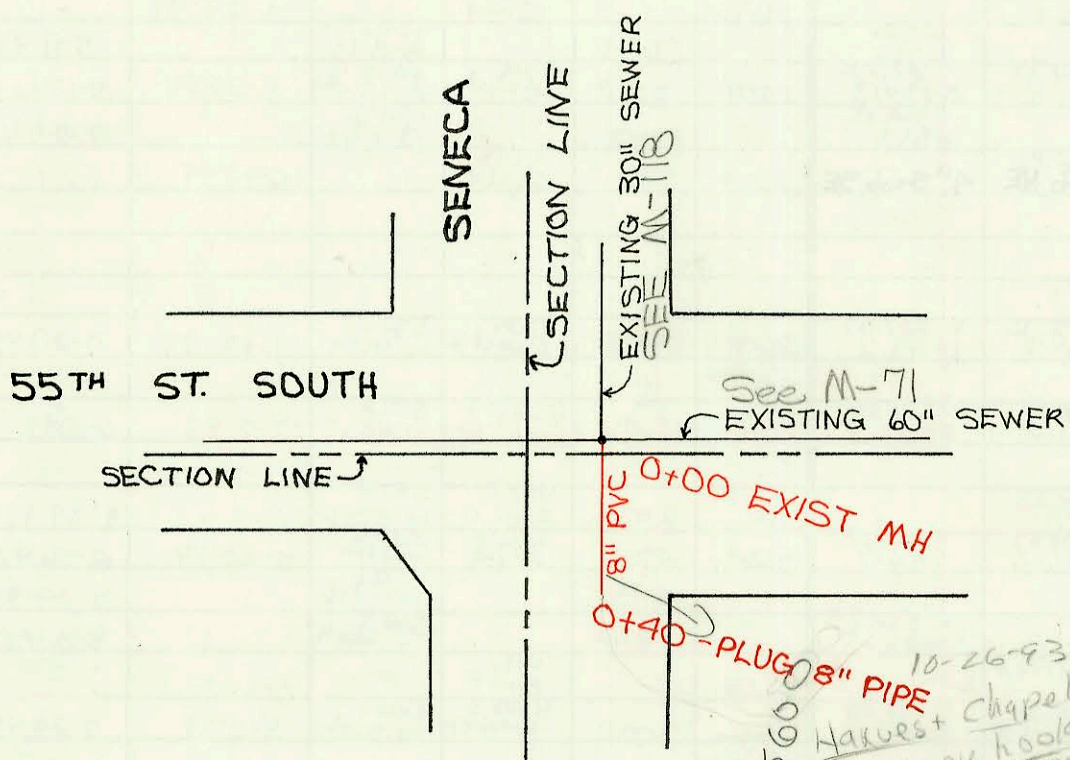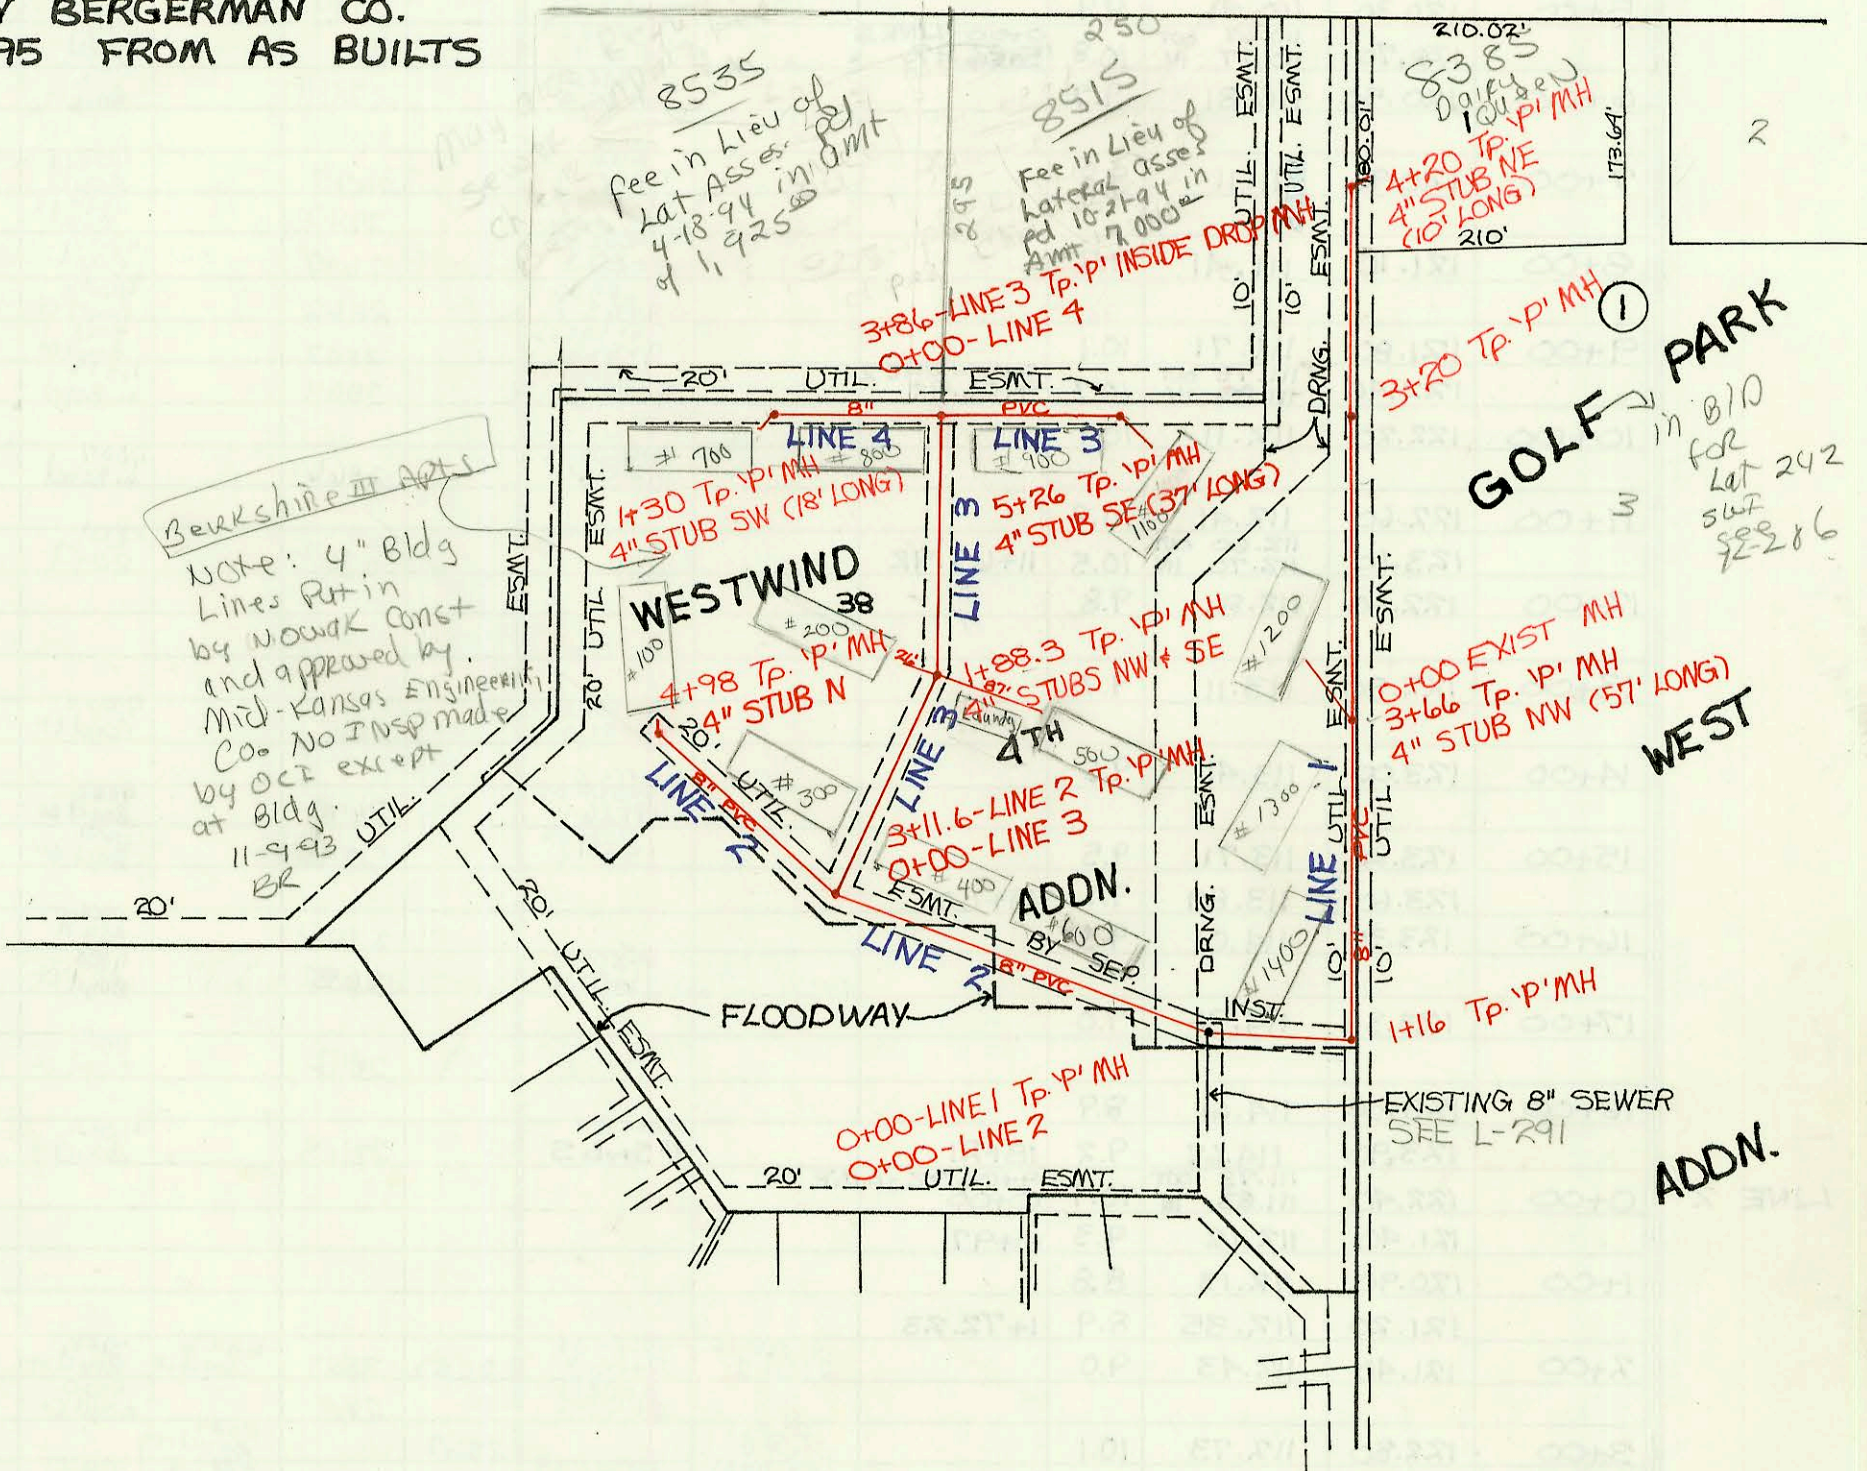

SCALE: 1" = 100'



SANITARY SEWER EXTENSION IN CONNECTION  
WITH STORM WATER SEWER NO. 402  
PROJ. NO. 468-82037 (724039)  
BUILT BY W. B. CARTER CONST. CO.  
BOOKED 10-25-93 FROM AS BUILTS

CONSTRUCTION RECORD						SERVICE RECORD						
STATION	ELEVATION		Depth	MANHOLE	4-INCH "Y" BRANCHES		No. of Permit		House Number		DATE OF PERMITS	
	Ground	Grade			North West	South East	North West	South East	North West	South East	North West	South East
Private Sanitary Sewer to Serve Berkshire III Apartment Complex												
LINE 1 0+00	163.75	154.65 OUT 156.15 IN	9.1	0+00-LINE 2 0+00								
1+00	163.70	156.78	5.9		4" S.D.R. 35 N/C 1+75-4" Riser (36' Long) W. 158.96		93-23446-7		8626 Westlawn #100		9-3-93	
2+00	163.00	157.36	5.6									
3+00	163.70	157.81	5.4		4" S.D.R. 35 N/C 3+05-4" Riser (27' Long) W. 159.30		93-23457-7		8626 Westlawn #100		9-3-93	
LINE 2 0+00	163.75	154.65 OUT 154.80 IN	9.1	0+00-LINE 1 0+00								
1+00	164.40	155.74	8.7		4" S.D.R. 35 N/C 1+50-4" Riser (10' Long) N. 157.95		93-23444-7		8626 Westlawn #100		9-3-93	
2+00	165.20	156.69	8.5		4" S.D.R. 35 N/C 2+50-4" Riser (12' Long) N. 158.85		93-23433-7		8626 Westlawn #100		9-3-93	
3+00	165.60	157.63	8.0									
4+00	167.00	158.28	8.7	0+00-LINE 3 3+11.6	4" S.D.R. 35 N/C 3+75-4" Riser (10' Long) N. 160.51		93-23432-7		8626 Westlawn #100		9-3-93	
LINE 3 0+00	166.19	157.74 OUT 157.89 IN	9.7	0+00-LINE 2 0+00	4" S.D.R. 35 N/C 4" Stub N N/C		93-23429-7		8626 Westlawn #100		9-3-93	
1+00	165.30	158.28	8.7		4" S.D.R. 35 N/C 1+70-4" Riser (26' Long)		93-23428-7		8626 Westlawn #100		9-3-93	
2+00	166.50	159.24	8.1	1+88.3	4" S.D.R. 35 N/C 2+08-4" Riser E. 159.83		93-23436-7		8626 Westlawn #100		9-3-93	
3+00	165.80	159.39										
4+00	167.12	159.52	7.6	0+00-LINE 4 3+86	4" S.D.R. 35 N/C 4+55-4" Riser (7' Long)		93-23449-7		8626 Westlawn #100		9-3-93	
5+00	165.50	160.08			A.B.S. Pipe 4+86.6 N/C		94-19328-7		8515 W 21st		12-1-94	
LINE 4 0+00	167.12	159.52 OUT 161.27 IN	5.8	0+00-LINE 3 0+00	4" S.D.R. 35 N/C 0+50-4" Riser S. 163.02		94-5538-7		8535 W 21st		4-12-94	9-3-93
1+00	167.50	162.47										
	168.43	162.83	5.6	1+30	DL Tied onto LEAD (18' Long) 4" Stub SW		93-23446-7		8626 Westlawn #100		9-3-93	
Sanitary Sewer Extension In Connection With Storm Water Sewer No. 402												
0+00	83.03	67.99 OUT 71.93 IN	15.4	0+00								
0+80	83.00	72.25	10.8									
Private Sanitary Sewer Extension To Serve Golf Park West Addition												
0+00	164.11	158.27 OUT 158.89 IN	5.8	0+00								
1+00	163.70	159.18	4.5									
2+00	164.80	159.47	5.3									
	165.79	159.56 OUT 159.53 IN	6.2	2+31								
3+00	166.00	160.03	6.0									
4+00	166.90	160.78	6.1									
	167.04	160.92	6.1	4+20	4" sch 40 161.39 4" Stub NE 10' Long		95-8817		8385 W 21st		6-16-95	