
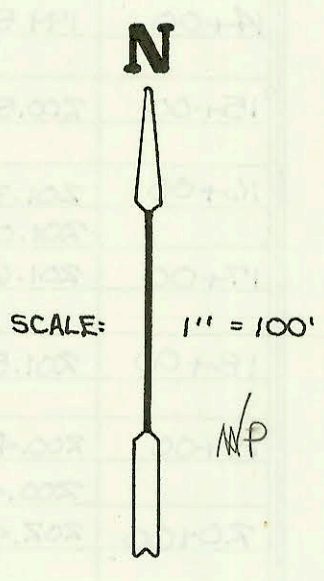


PRIVATE SANITARY SEWER TO SERVE EAST TURNPIKE ENTRANCE ADDITION  
 PRIV. PROJ. NO. 405 PPS (607861)  
 BUILT BY W.B. CARTER CONST. CO.  
 BOOKED 10-27-93 FROM AS BUILTS

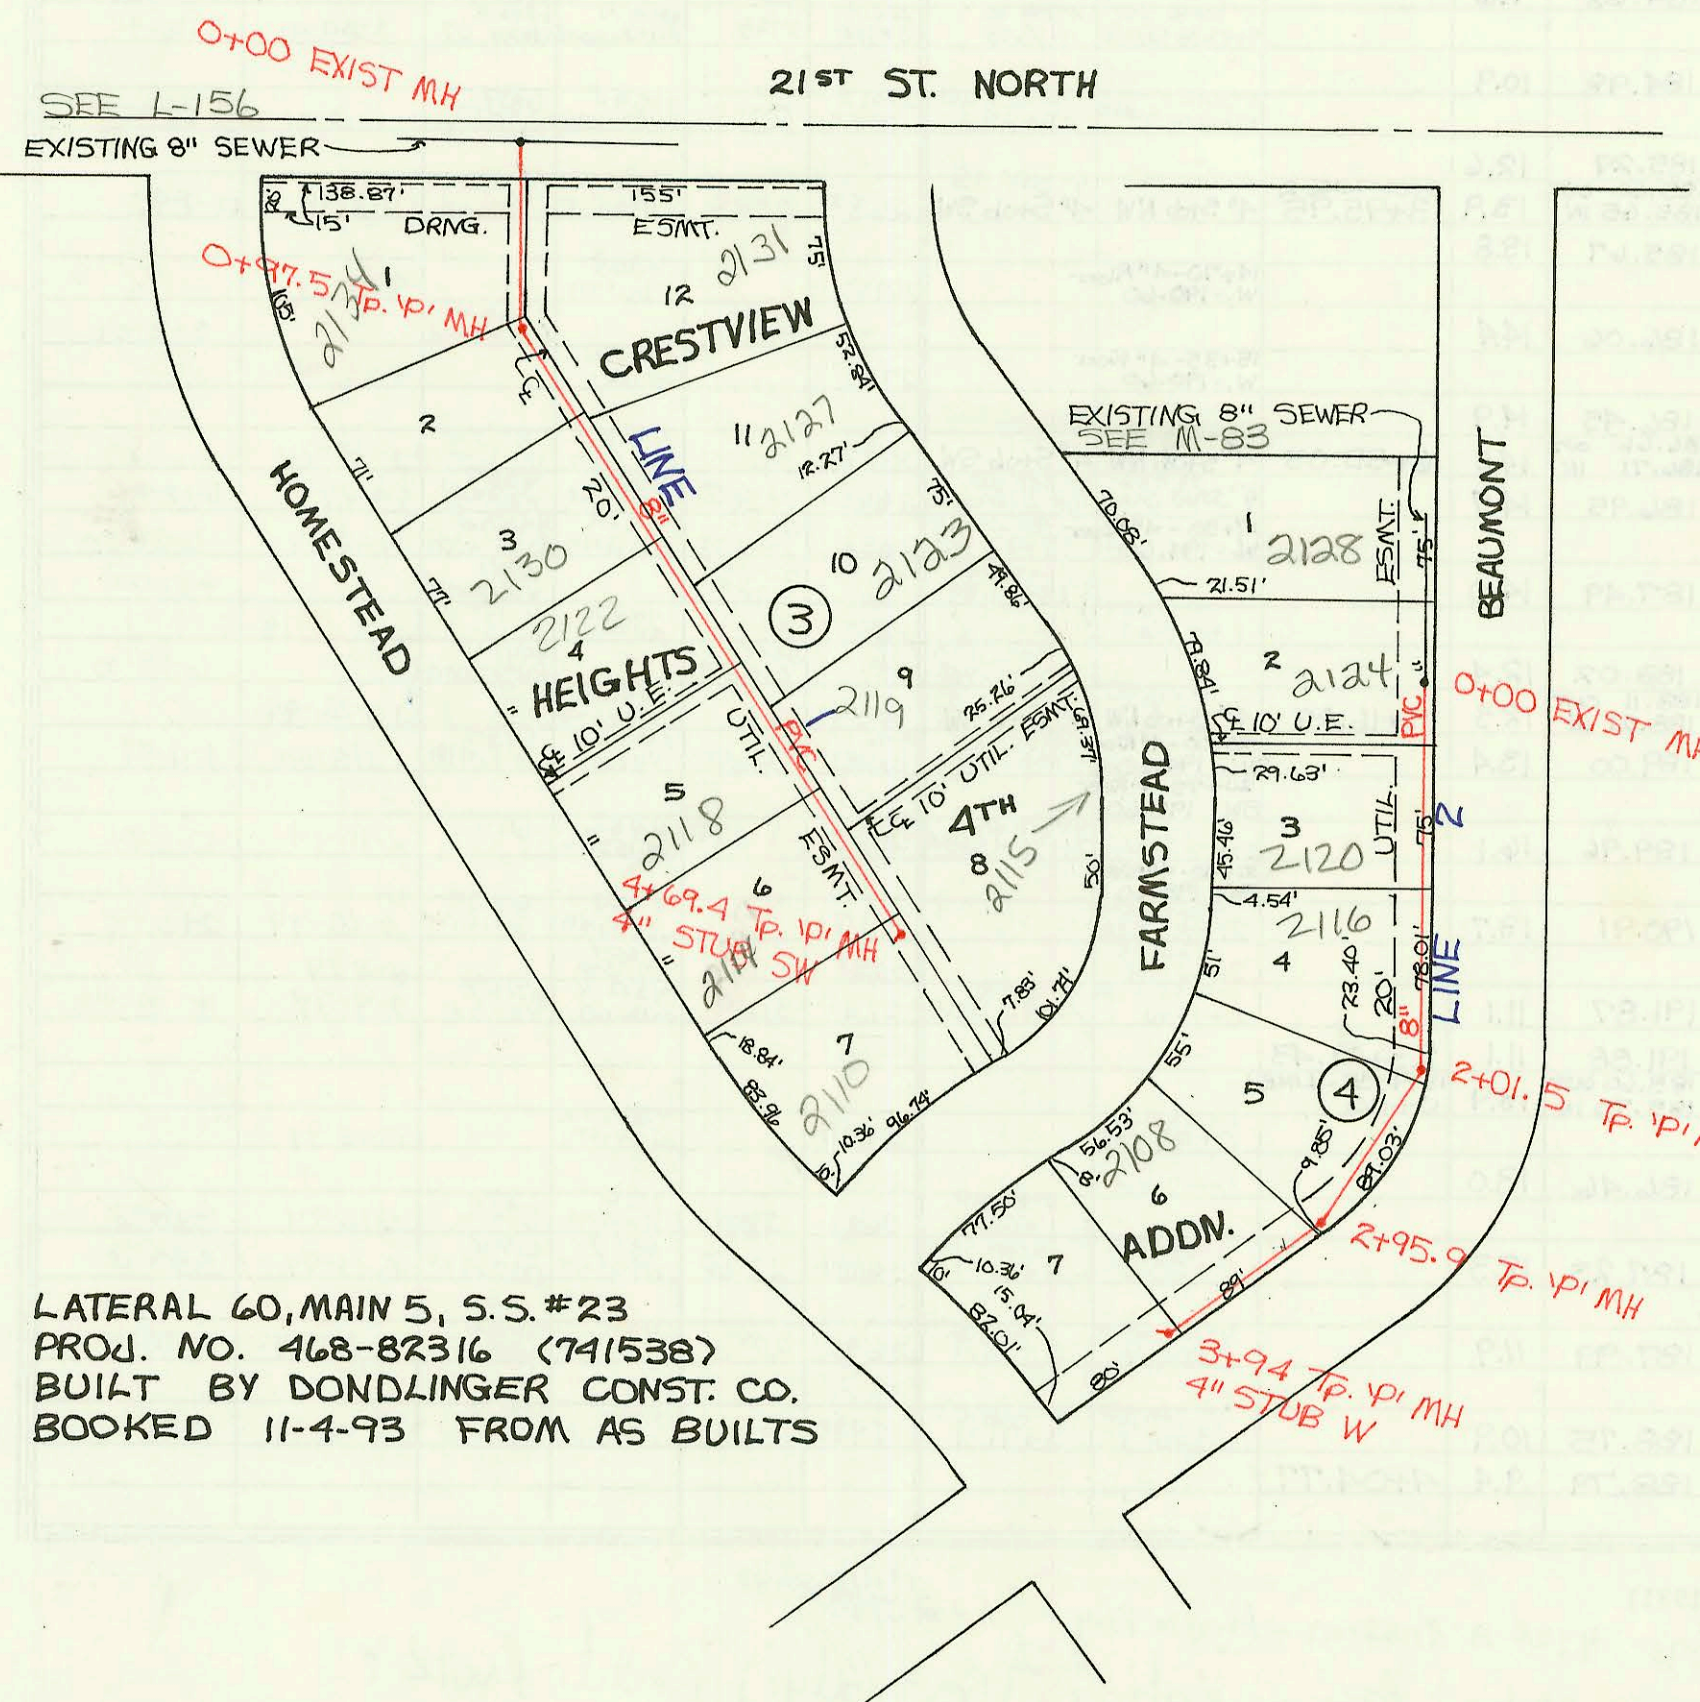

LATERAL 60, MAIN 5, S.S. #23  
 PROJ. NO. 468-82316 (741538)  
 BUILT BY DONDLINGER CONST. CO.  
 BOOKED 11-4-93 FROM AS BUILTS

CONSTRUCTION RECORD							SERVICE RECORD					
STATION	ELEVATION		Depth	MANHOLE	4-INCH "Y" BRANCHES		No. of Permit		House Number		DATE OF PERMITS	
	Ground	Grade			North West	South East	North West	South East	North West	South East	North West	South East
Private Sanitary Sewer To Serve East Turnpike Entrance Addn.												
0+00	151.40	140.85 OUT 144.50 IN	10.6	0+00								
	156.88	145.06 OUT 146.99 IN	11.8	0+67.5								
1+00	156.70	147.33	9.3									
2+00	156.70	148.39	8.3									
	156.87	148.84	8.0	2+41.5	4" Sub NE		93-276377		9405 Kellogg		10-25-93	
Laterals 1 60, Main 5, S.S. # 23												
0+00	202.21	193.44 OUT 193.75 IN	8.8	0+00	4" Sub SW	4" Sub SW	95-12977	96-13079	2134 Homestead	2131 Farmstead	8-17-95	8-16-96
	204.70	194.89 OUT 194.97 IN	10.3	0+97.5								
1+00	204.70	194.39	10.3				2004-21642	2003-22415	2130 Homestead	2127 Farmstead	6-7-04	9-17-03
2+00	205.90	195.14	10.8					2004-21798		2123 Farmstead		6-25-04
3+00	207.50	195.88	11.6		4" Sub SW 2+70.5 4" Sub SW 3+46.9		99-84227		2182 Homestead	2118 Homestead	5-28-97	1-20-95
4+00	208.90	196.63	12.3		4" Sub SW 4+46.4		96-15787		2114 Homestead		9-18-96	
0+00	210.25	197.15	13.1	4+69.4	4" Sub SW		96-161647		2110 Homestead		9-23-96	
1+00	211.67	199.03 OUT 199.16 IN	12.6	0+00	0+10-4" Riser W. 0+50-4" Riser W.		2004-21666 2004-21668		2124 Farmstead	2120 Farmstead	6-9-04	6-9-04
2+00	214.80	200.56	14.2				2004-21667		2116 Farmstead		6-9-04	
	214.80	200.57 OUT 200.60 IN	14.2	2+01.5	2+25-4" Riser NW.							
	215.03	201.24 OUT 201.27 IN	13.8	2+95.9								
3+00	215.00	201.30	13.7		3+20-4" Riser NW. 3+10		96-18975		2108 Farmstead		10-22-96	
	215.45	201.91	13.5	3+94	4" Sub W							

LINE 1

LINE 2