

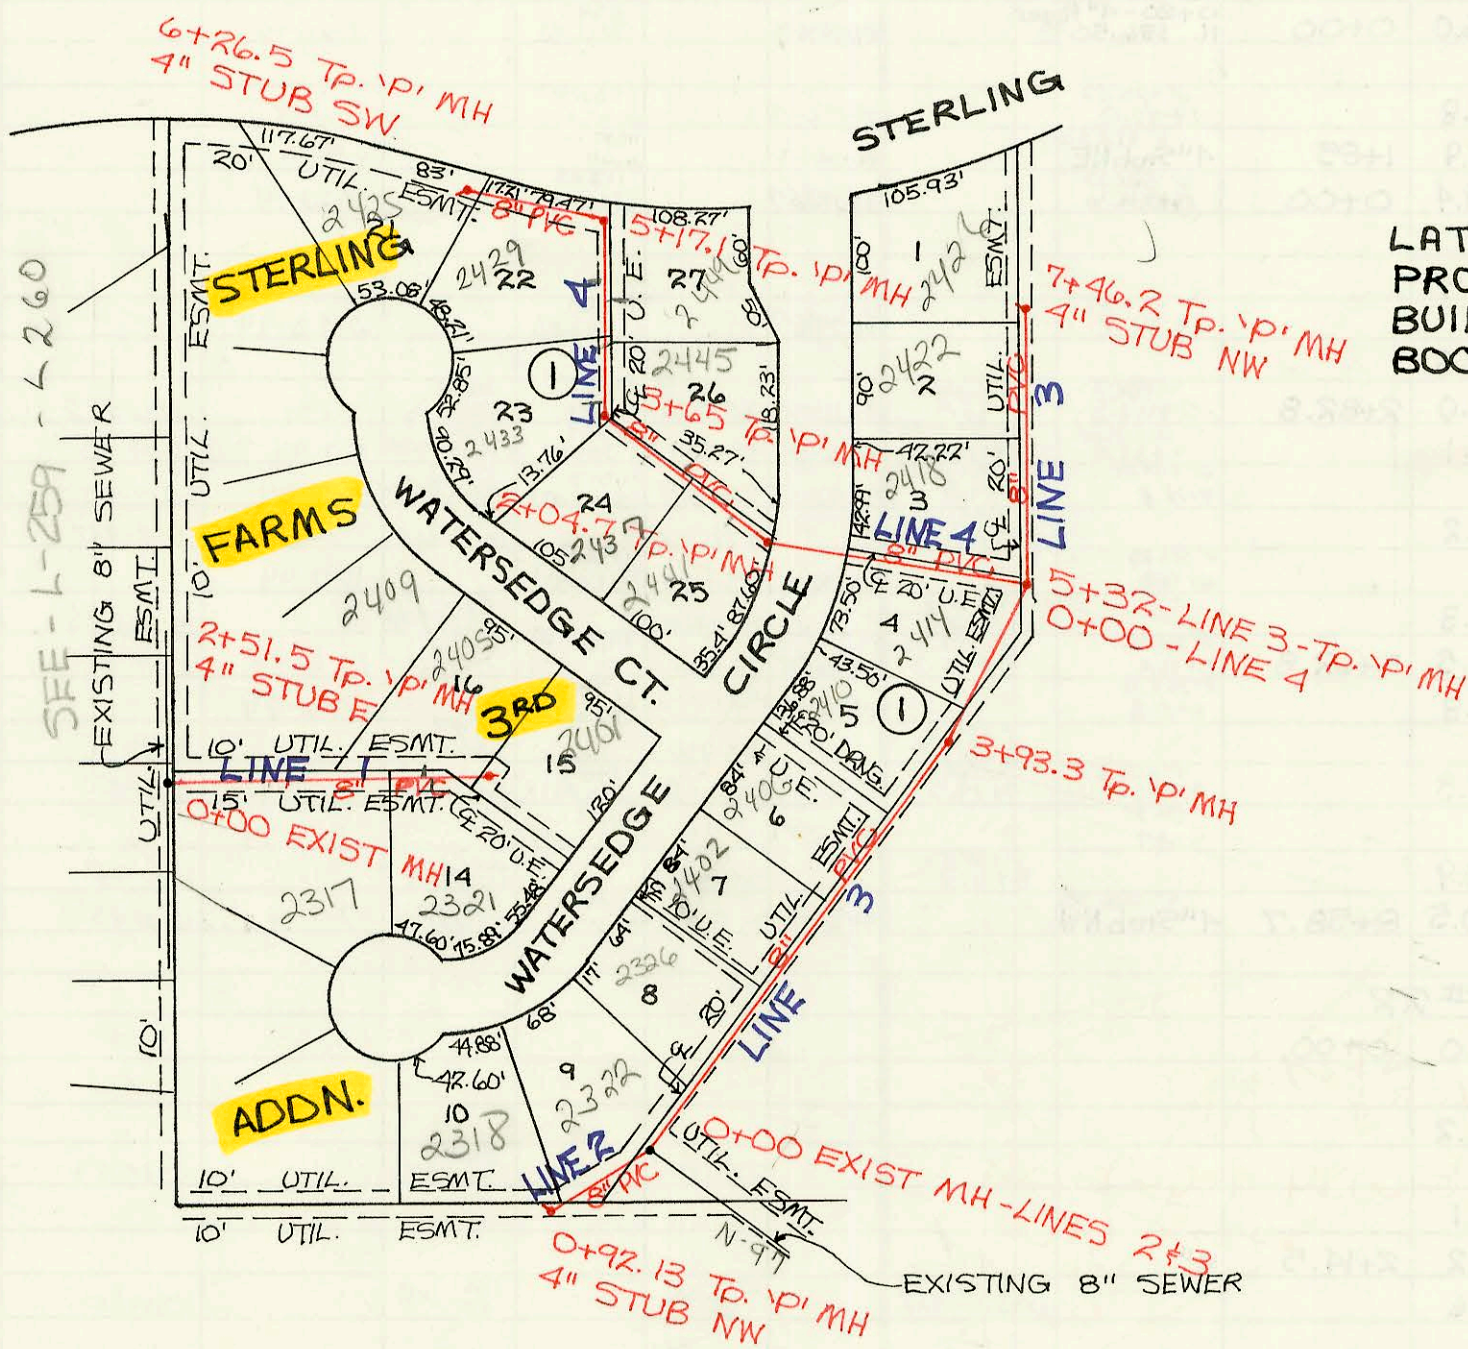
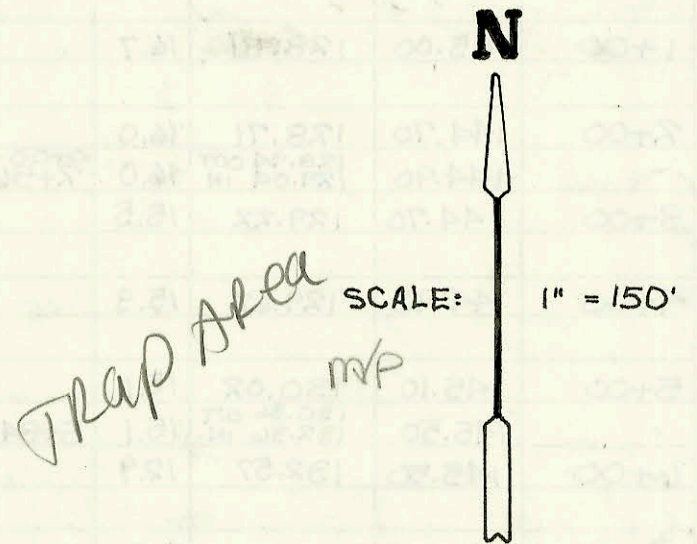
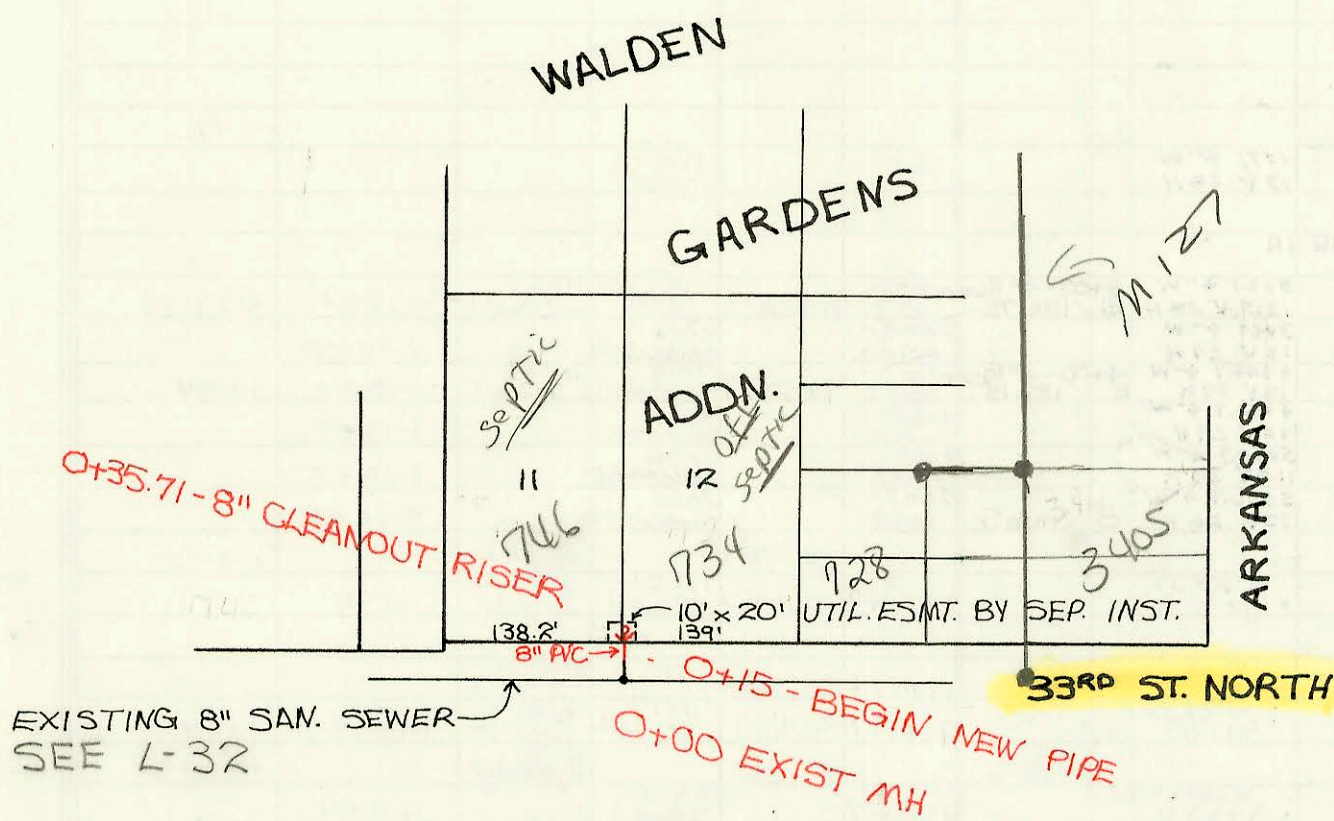



LATERAL 122, MAIN 4, S.S.# 23
PROJ. NO. 468-82203 (741124)
BUILT BY McCULLOUGH EXCAVATION
BOOKED 2-9-94 AS PER PLAN

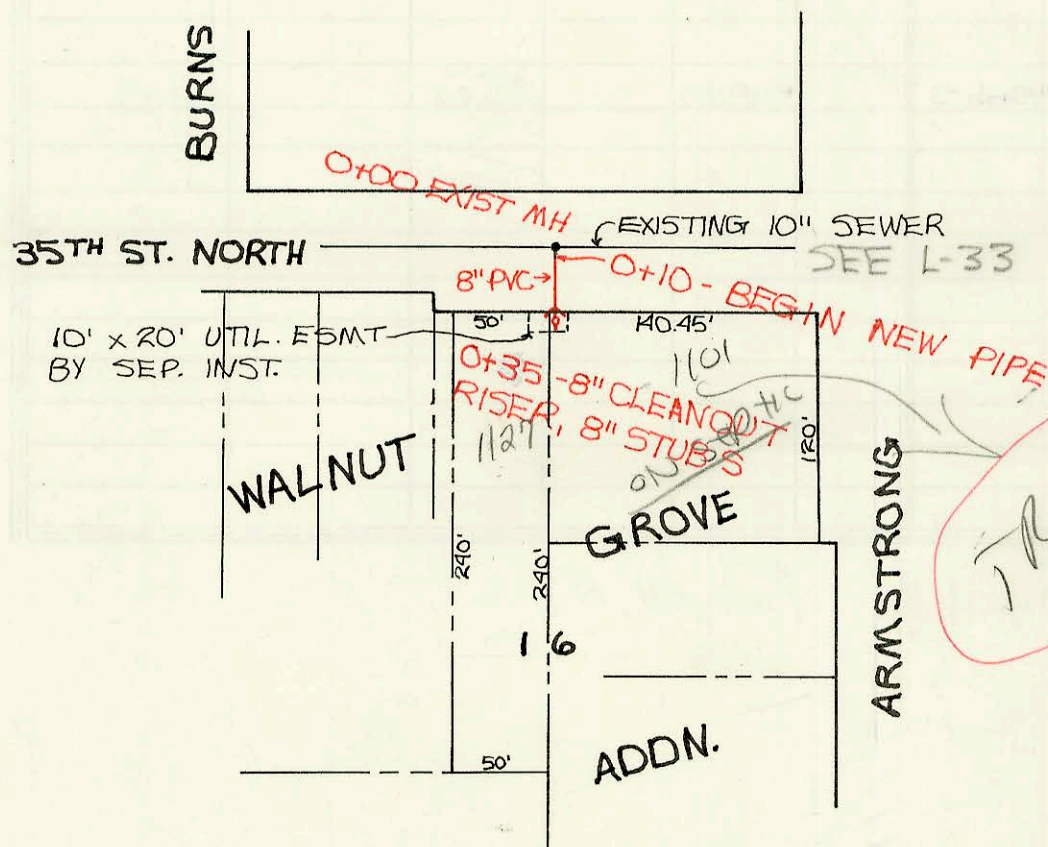

LATERAL 110, WESTLINK SEWER
PROJ. NO. 468-82331 (741611)
BUILT BY DONDLINGER CONST. CO.
BOOKED 2-10-94 AS PER PLAN

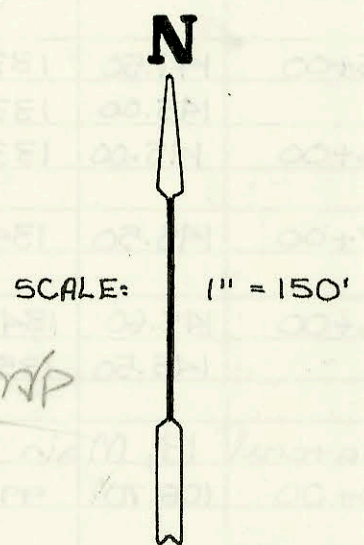

LATERAL 123, MAIN 4, S.S.# 23
PROJ. NO. 468-82223 (741199)
BUILT BY McCULLOUGH EXCAVATION
BOOKED 2-10-94 AS PER PLAN

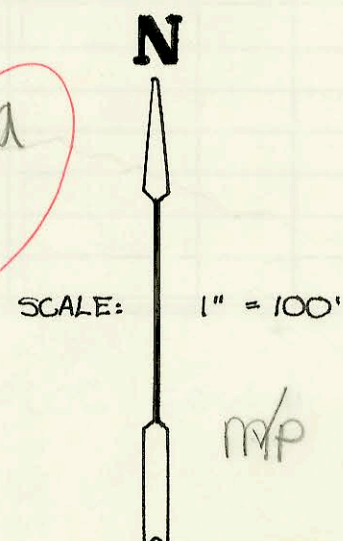

CONSTRUCTION RECORD						SERVICE RECORD						
STATION	ELEVATION		Depth	MANHOLE	4-INCH "Y" BRANCHES		No. of Permit		House Number		DATE OF PERMITS	
	Ground	Grade			North West	South East	North West	South East	North West	South East	North West	South East
lateral 122	122	Main 4	5.5	#23								
0+00	133.00	121.64 OUT 121.74 IN	11.4	0+00								
0+15	133.60	121.82	11.8									
0+35.71	133.41	121.89	11.5	0+35.7	4" Wye NE 4" Wye NW		2002 950957	9751337	706 W 33rd	734 W 33rd	2-4-02	9-5-97
LINE 1												
lateral 110	110	Westlin K		Sewer								
0+00	168.16	154.97 OUT 154.97 IN	13.2	0+00	4" SDR 35 0+80-4" Riser North		94-970-7		2409 watersedge		1-5-94	
1+00	169.60	155.27	14.3		0+85-4" Riser South SDR 35		94-011207-7		2317 N watersedge Cr		7-7-94	
2+00	168.50	155.57	12.9		2+00-4" Riser North	2+05-4" Riser South	94-3500-7	94-4848-7	2405 watersedge	2321 watersedge	3-9-94	4-6-94
	169.00	155.72	13.3	2+51.5	4" SDR 35 4" Stub E		94-1440-7		2401 watersedge		1-25-94	
LINE 2												
0+00	163.40	151.30 OUT 151.40 IN	12.1	0+00	4" SDR 35 0+55.0		95-15086-7		2322 watersedge		9-22-95	
	162.80	153.93	8.9	0+92.13	4" Stub NW		94-902-7		2318 watersedge		1-14-94	
LINE 3												
0+00	163.40	151.30 OUT 151.40 IN	12.1	0+00	6" SDR 35 0+88.0		94-3201-7		2326 watersedge		3-10-94	
1+00	163.40	151.90	11.5									
2+00	163.40	152.40	11.0				94-4719-7		2452 watersedge		3-29-94	
					4" PVC 40 2+76.3		94-10235-7		2406 watersedge		6-30-94	
3+00	163.40	152.90	10.5									
	163.70	153.37	10.3	3+93.3	4" PVC 40 3+79.7		94-10334-7		2410 watersedge		6-30-94	
4+00	163.40	153.40	10.0		4" SDR 35 4+67.3		94-5603-7		2414 N watersedge		4-13-94	
5+00	163.40	153.90	9.5									
	163.70	154.06	9.6	0+00-LINE 4 5+32	4" SDR 35 6+05.0		94-3514-7		2418 watersedge		3-9-94	
6+00	163.40	154.40	9.0									
7+00	163.40	154.90	8.5		4" SDR 35 6+90.2		94-10282-7		2422 watersedge		11-10-94	
	163.70	155.13	8.6	7+46.2	4" Stub NW		94-2810-7		2426 watersedge		7-1-94	
LINE 4												
0+00	163.70	154.06 OUT 154.26 IN	9.6	5+32-LINE 3 0+00								
1+00	167.70	154.66	13.0									
2+00	167.00	155.06	11.9		4" SDR 35 2+40 4" SW Riser		95-12657-7		2441 watersedge		8-10-95	
	167.00	155.08	11.9	2+04.7	2+70-4" Riser N. 4" SDR 35		96-6358-7		2445 watersedge		4-19-96	
3+00	168.70	155.46	13.2		3+20 4" SW Riser		94-4706-7		2437 watersedge		3-29-94	
	169.70	155.72 OUT 155.92 IN	14.0	3+65	3+75-4" Riser W.		98-1500-7		2433 watersedge		8-6-98	
4+00	170.00	156.06	13.9		4+55-4" Riser E.		98-1077-7		2449 watersedge		9-2-98	
					4+70-4" Riser W.							
5+00	168.40	156.46	11.9									
	167.90	156.53 OUT 156.73 IN	11.4	5+17.1								
6+00	167.70	157.06	10.6				97-2055-7		2429 watersedge		11-20-97	
	168.40	157.17	11.2	6+26.5	4" SDR 35 4" Stub SW		95-20057-7		2425 watersedge		12-9-95	
lateral 123	123	Main 4	5.5	#23								
0+00	131.60	123.09 OUT 123.35 IN	8.5	0+00								
0+10	131.20	123.44	7.8									
0+35	130.59	123.65	6.9				94-1847-7		1127 W 35th		7-16-97	