


LATERAL 109, WESTLINK SEWER
PROJ. NO. 468-82321 (741603)
BUILT BY NOWAK CONST. CO.
BOOKED 3-4-94 AS PER PLAN

N

SCALE: 1" = 150'

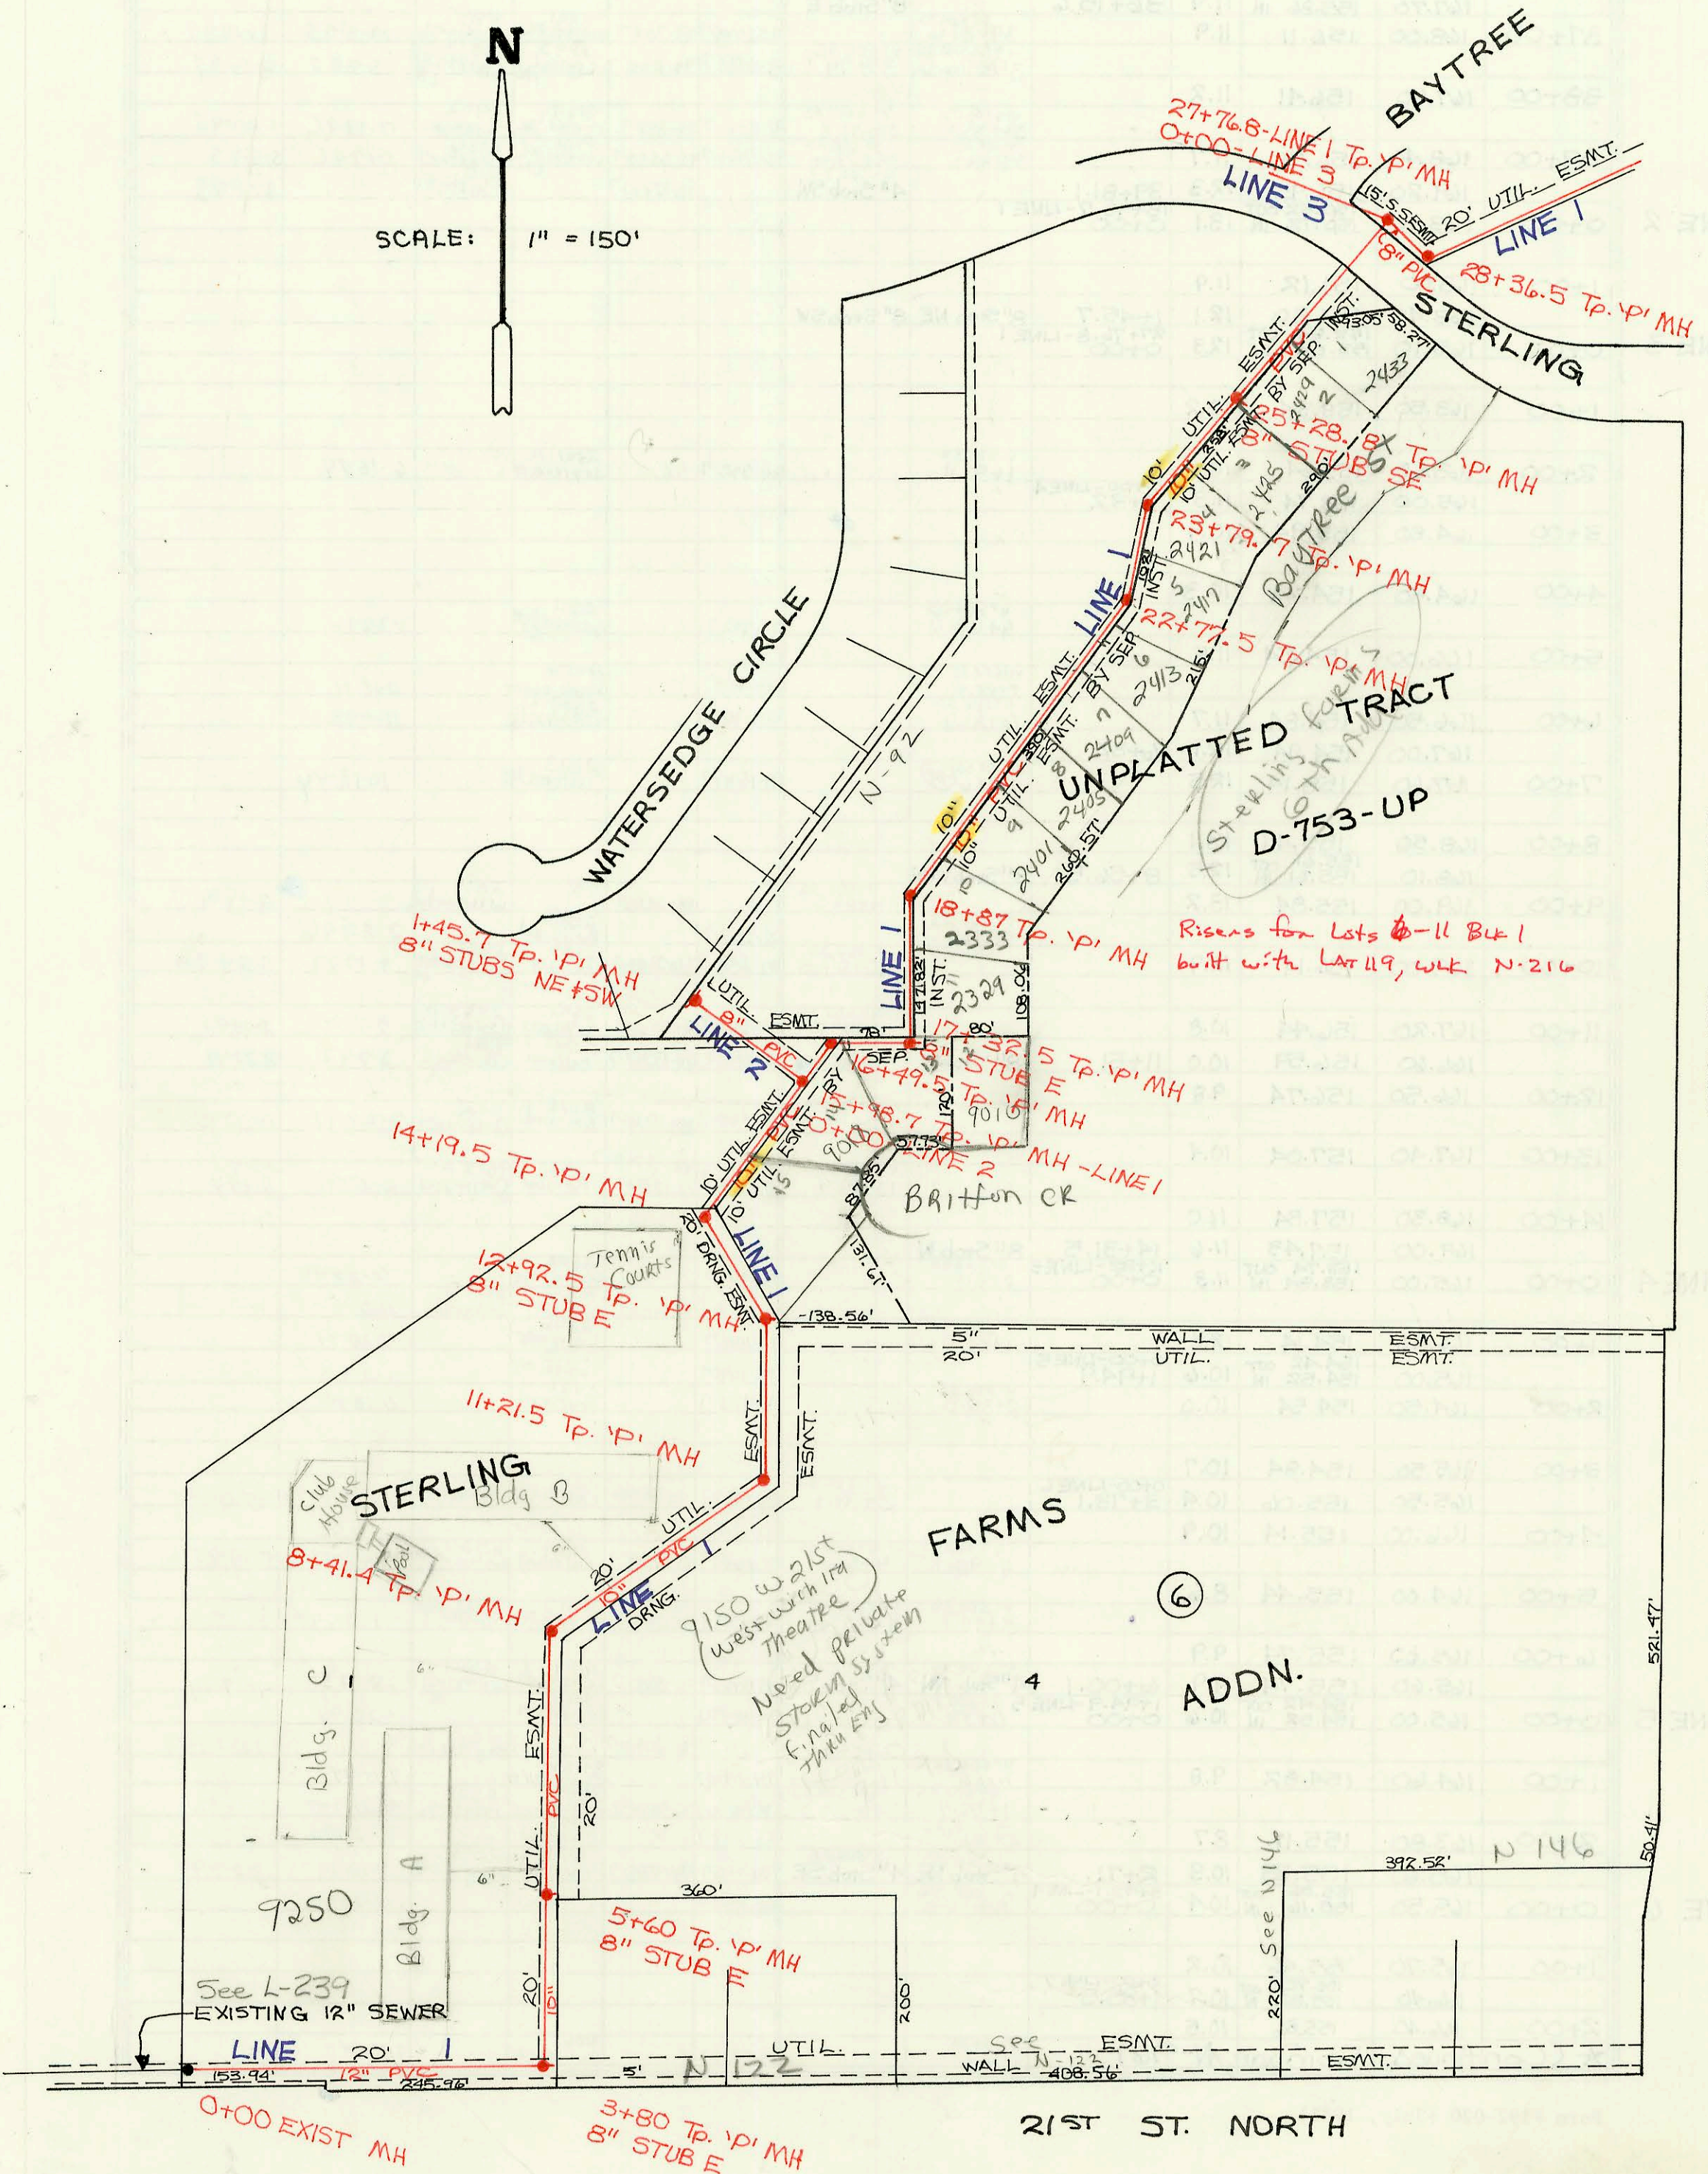

TYLER ROAD

ADDN.

21ST ST. NORTH

