


LATERAL 1, MAIN 17, SWI  
PROJ. NO. 468-82299 (741504)  
BUILT BY UTILITY CONTRACTORS, INC.  
BOOKED 5-4-94 FROM AS BUILTS

See Page 110 for  
Riser INFO

NOTE: check storm sewer Books  
as some lots have storm  
lines on them and have extra  
base. BL 52476

N

SCALE: 1" = 150'

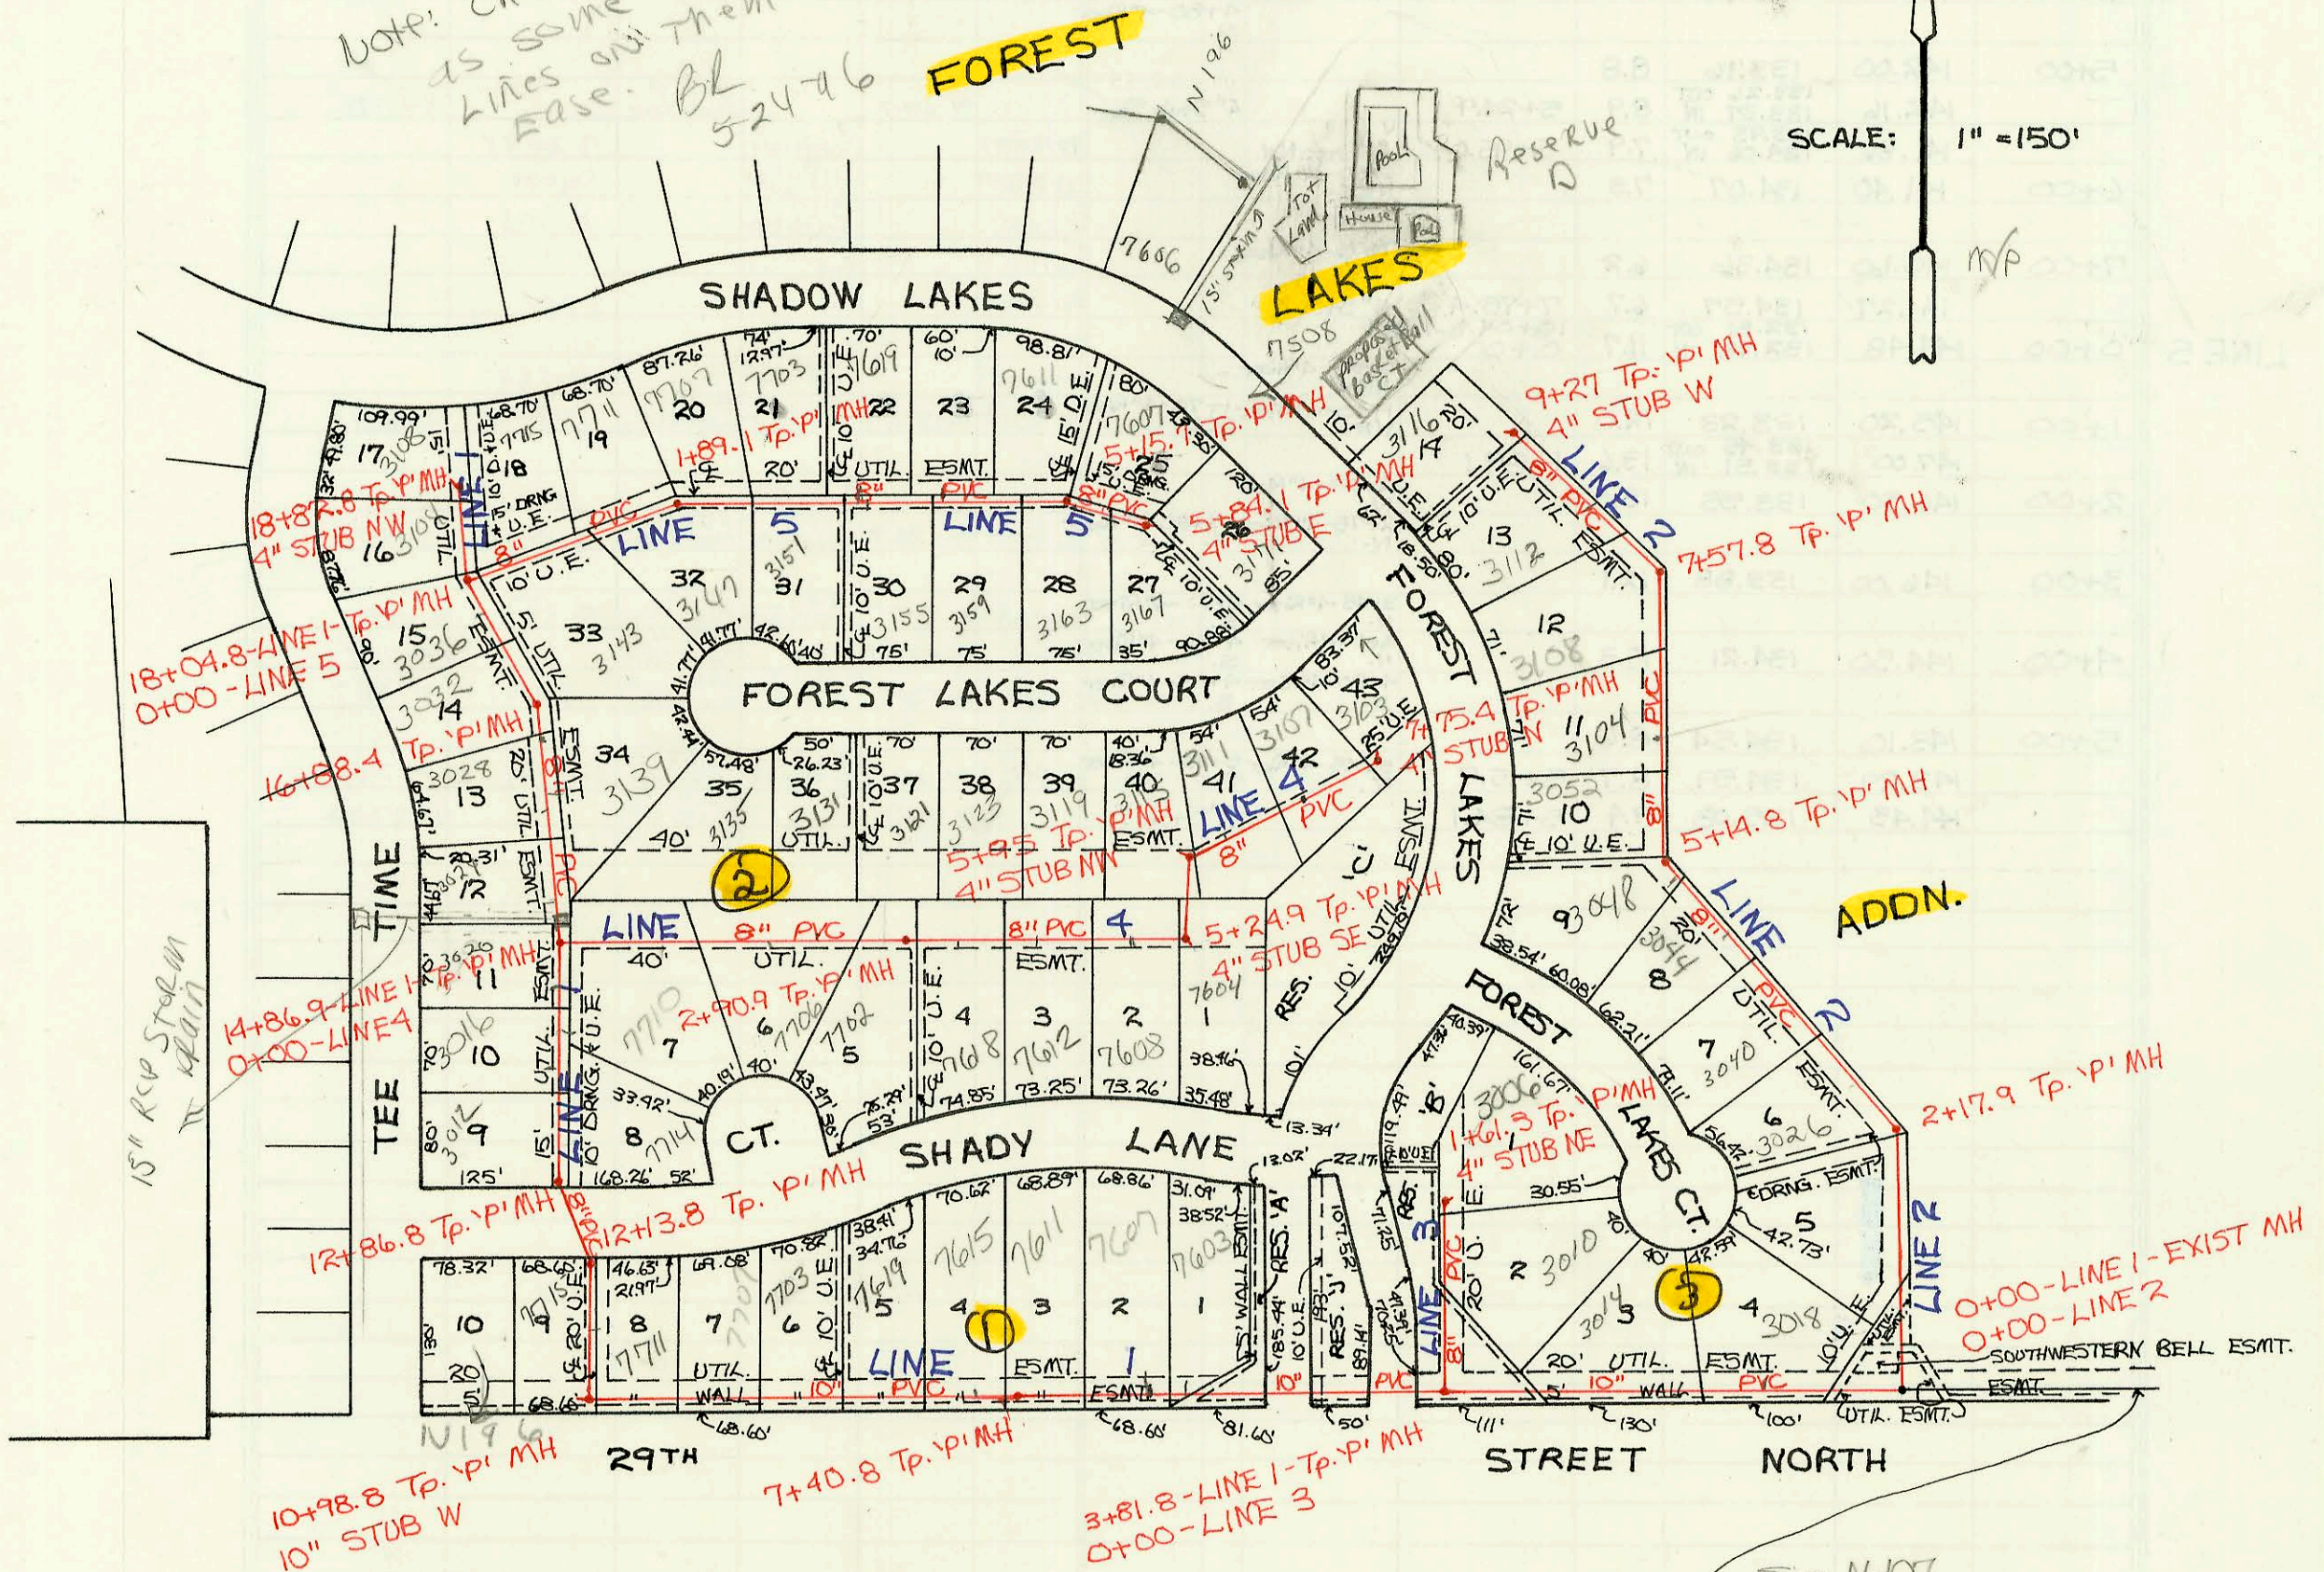

2001-01722 7/12/01 Mies Const- (NOTE: EXIST SVC LINE HIT BY PERSONS INSTALLING SPRINKLER SYSTEM) Repair of MH 5+14.8 (5+84.8) Repair 4" SCH 40 Saddle 70' N

CONSTRUCTION RECORD						SERVICE RECORD						
STATION	ELEVATION		Depth	MANHOLE	4-INCH "Y" BRANCHES		No. of Permit		House Number		DATE OF PERMITS	
	Ground	Grade			North West	South East	North West	South East	North West	South East	North West	South East
Lateral	1, Main	17.5W										
0+00	139.54	128.64 OUT 128.65 IN	10.9	0+00-LINE 2 0+00								
1+00	139.00	128.81	10.2		1+15-4" Riser N. 4" SDR 35		94-1041-7		3015 N Forest Lakes		7-1-94	
2+00	139.00	128.97	10.0		2+05-4" Riser N. 4" SDR 35 N/C		94-1330-7		3014 CT Forest Lakes		1-27-94	
3+00	139.00	129.14	9.9									
	139.62	129.87 OUT 129.28 IN	10.4	0+00-LINE 3 3+81.8								
4+00	139.00	129.31	9.7									
5+00	139.90	129.46	10.4									
6+00	140.50	129.62	10.9		6+00-4" Riser N. 4" SDR 35		94-1277-7		7603 Shady Ln		8-15-94	
					6+30-4" Riser N. 4" SDR 35		94-1381-7		7697 Shady Ln		8-16-94	
7+00	142.30	129.78	12.5		7+00-4" Riser N. 4" SDR 35		94-1200-8		7611 Shady Lane		7-19-94	
	143.02	129.84 OUT 129.85 IN	13.1	7+40.8	7+75-4" Riser N. 4" SDR 35		94-1042-7		7615 Shady Ln		7-1-94	
8+00	142.90	129.97	12.9									
					8+40-4" Riser N. 4" SDR 35 N/C		94-1310-7		7619 W Shady Lane		1-27-94	
9+00	143.20	130.17	13.0		9+45-4" Riser N. 4" SDR 35 N/C		94-957-7		7703 W Shady Lane		1-24-94	
					9+80-4" Riser N. 4" SDR 35		94-1309-7		7707 W Shady Lane E		1-27-94	
10+00	143.50	130.36	13.1									
	144.65	130.56 OUT 130.73 IN	14.1	10+98.8	10" Stab W							
11+00	144.60	130.73	13.9									
12+00	146.10	131.06	15.0									
	145.78	131.10 OUT 131.08 IN	14.7	12+13.8								
	145.44	131.52 OUT 131.52 IN	13.9	12+86.8								
13+00	145.50	131.55	14.0		13+00-4" Riser W.	13+40-4" Riser E. 4" SDR 35	94-2485-7	94-970-7	3027 Feetime	7714 W Shady Lane Ct	2-13-97	6-21-94
					13+85-4" Riser W.		94-5725-7		3016 Feetime		9-11-97	
14+00	146.00	131.73	14.3		14+50-4" Riser W. 4" SDR 35		94-1384-7		3020 Feetime		8-22-96	
	145.32	131.90 OUT 131.90 IN	13.4	0+00-LINE 4 14+86.9								
15+00	144.50	132.01	12.5									
					15+25-4" Riser W.		94		3024 Feetime		11-21-97	
16+00	145.40	132.28	13.1		16+00-4" Riser W.	16+15-4" Riser E. 4" SDR 35	94-3005-7	94-19570-7	3028 Feetime	3139 Forest Lakes	3-14-96	12-1-94
	146.12	132.53 OUT 132.54 IN	13.6	16+88.4	16+75-4" Riser WSW 4" SDR 35		94-7523-7		3032 Feetime		5-17-96	
17+00	145.50	132.57	12.9			17+30-4" Riser ENE 4" SDR 35	94-1330-7		3143 N CT Forest Lakes		1-27-94	
					17+70-4" Riser WSW 4" SDR 35		94-6248-7		3036 Feetime		4-26-95	
18+00	144.00	132.80	11.2									
	144.48	132.81 OUT 132.91 IN	11.7	18+04.8	18+20-4" Riser W.		94-20938-7		3104 Feetime		16-29-98	
	145.68	133.83	11.9	18+82.8	4" Stab NN		94-6058-7		3108 Feetime		10-8-99	
LINE 2 0+00	139.54	128.64 OUT 128.88 IN	10.9	0+00-LINE 1 0+00								
1+00	139.00	129.25	9.8		1+30-4" Riser W.							
2+00	139.00	129.62	9.4									
	139.54	129.69 OUT 129.72 IN	9.9	2+17.9	2+70-4" Riser WSW 4" SDR 35		94-18357-7		3026 Forest Lakes Ct		11-1-95	
3+00	139.00	130.07	8.9									
					3+55-4" Riser WSW 4" SDR 35 N/C		94-1314-7		3040 N Forest Lakes Ct.		1-27-94	
4+00	139.00	130.49	8.5									
					4+35-4" Riser WSW 4" SDR 35		94-5699-7		3044 Forest Lakes		4-19-95	
5+00	139.00	130.91	8.1		5+00-4" Riser WSW.		94-2100-7		3048 Forest Lakes		4-21-96	
	139.72	130.97 OUT 131.02 IN	8.8	5+4.8	5+40-4" Riser W. 4" SDR 35		94-1163-7	2001-07-22	3052 N Forest Lakes St	R see next pg	7-12-01 7-7-74	
6+00	139.00	131.33	7.7									
					6+20-4" Riser 4" SDR 35		94-15988-7		3104 Forest Lakes		9-30-94	
7+00	139.00	131.70	7.3		7+10-4" Riser W. 4" SDR 35		94-19672-7		3108 Forest Lakes		12-1-94	
	139.68	131.91 OUT 132.08 IN	7.8	7+57.8								
8+00	139.00	132.23	6.8									
					8+40-4" Riser WSW 4" SDR 35		94-10410-7		3112 N Forest Lakes		7-1-94	
9+00	139.00	132.60	6.4									
	139.65	132.70	7.0	9+27	4" Stab W	4" SDR 35 MHT TOP	94-4547-7	97-2247-7	3116 Forest Lakes	7308 Shady Lakes	3-16-94	2-19-97
LINE 3 0+00	139.62	129.27 OUT 131.22 IN	10.4	3+81.8-LINE 1 0+00								
1+00	139.50	132.12	7.4									
	140.67	132.67	8.0	1+61.3	4" Stab NE	4" SDR 35	94-11965-7		3006 N Forest Lakes		9-15-94	
*Continue on Page N-110												