

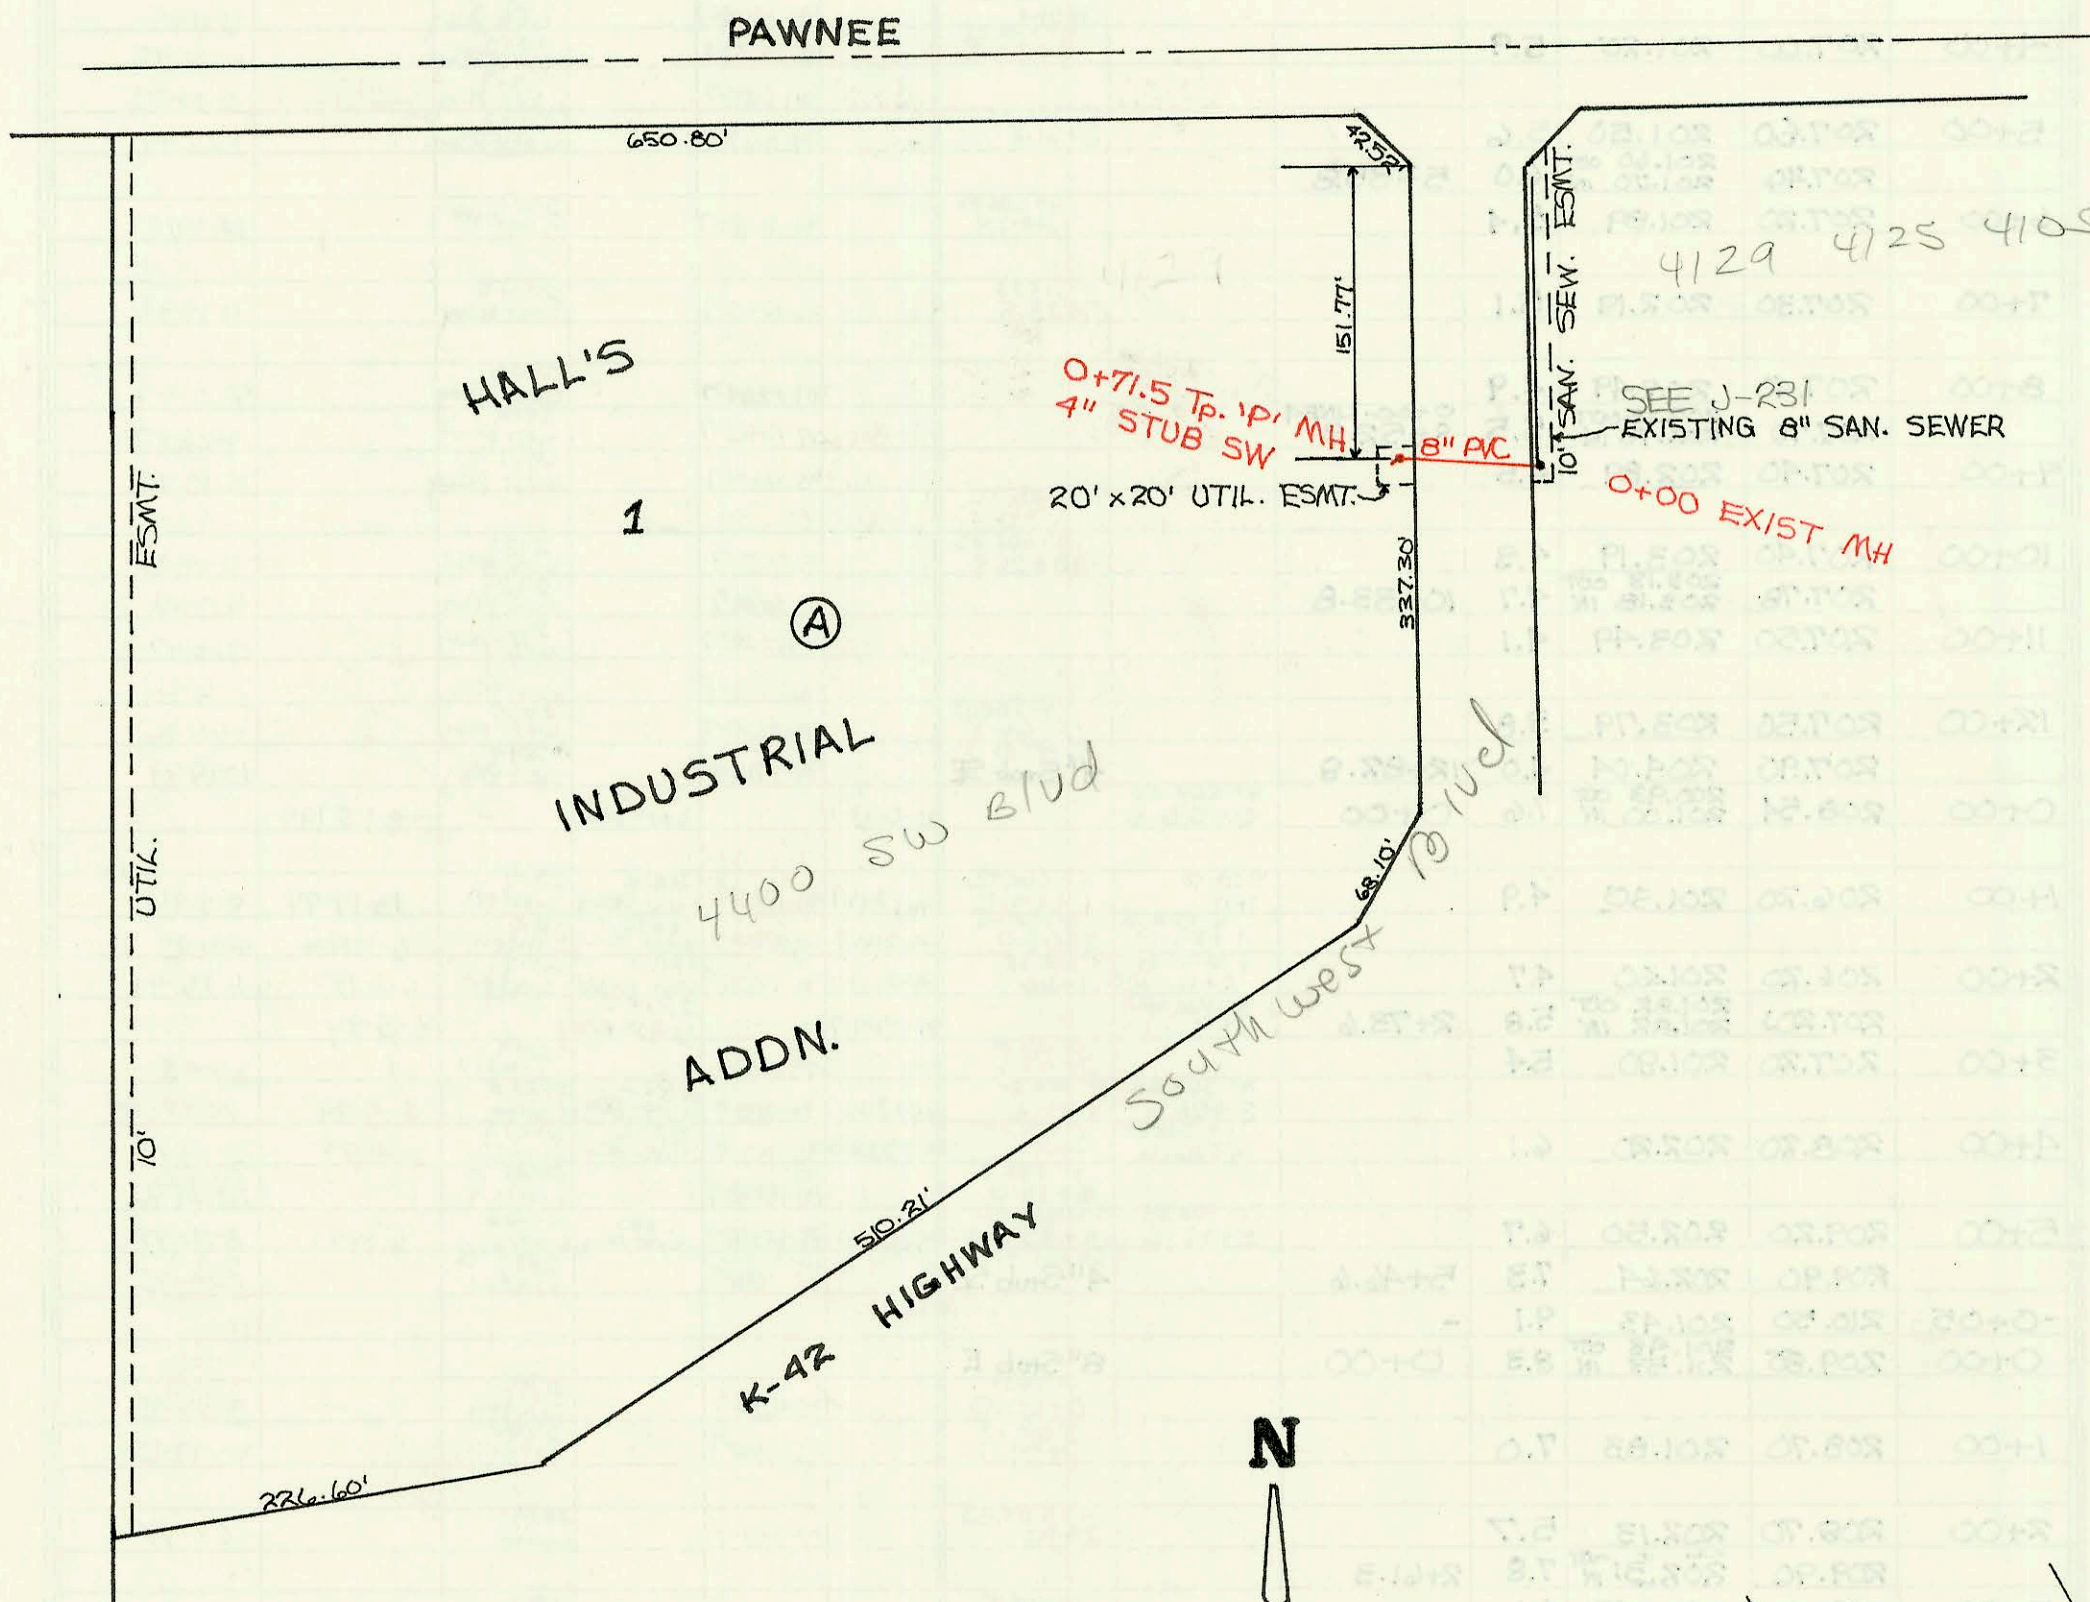
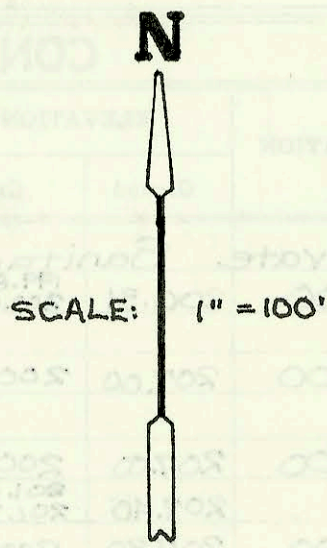


PRIVATE SANITARY SEWER EXTENSION TO
SERVE HALLS INDUSTRIAL ADDITION
PROJ. NO. 436 PPS (607861)
BUILT BY MIES CONSTRUCTION CO.
BOOKED 5-10-94 FROM AS BUILTS

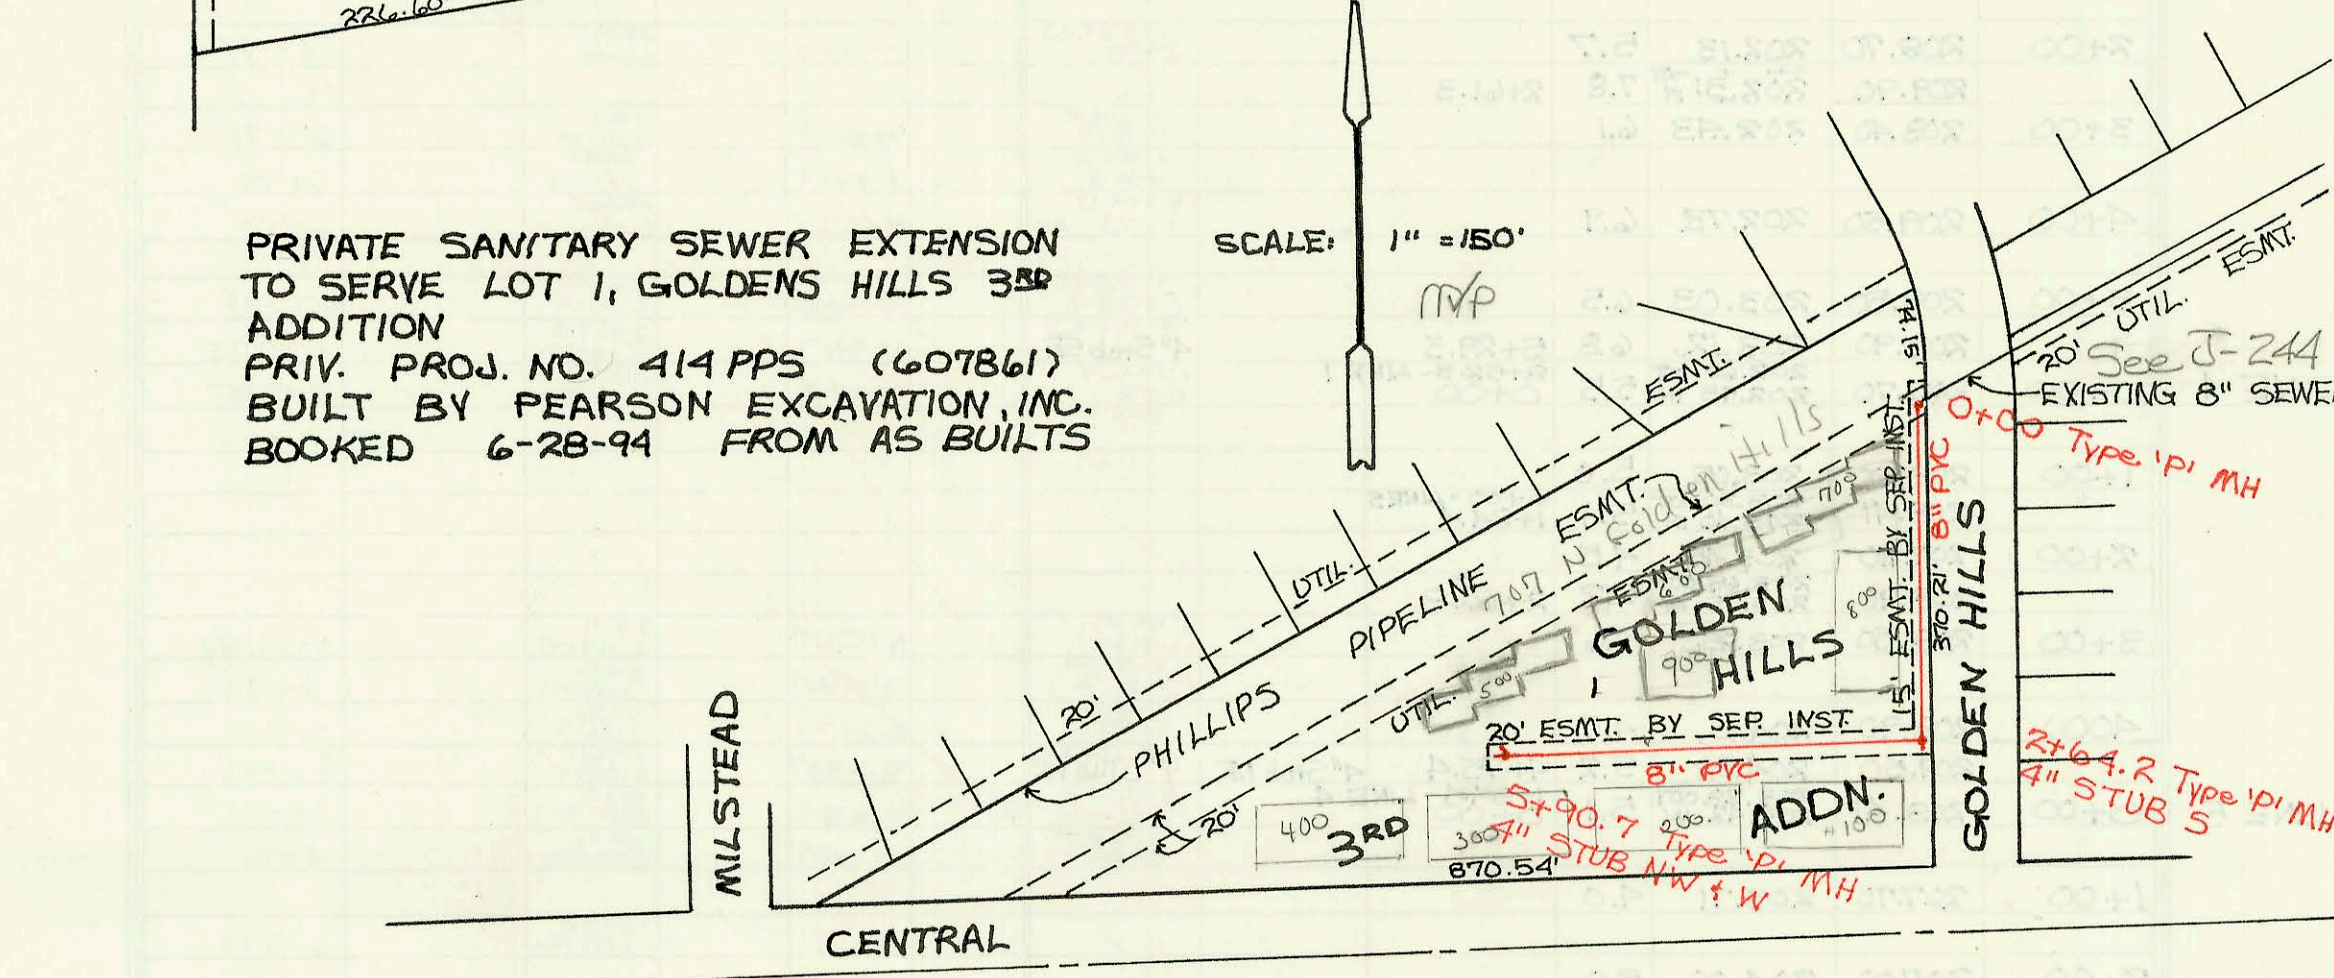

PRIVATE SANITARY SEWER EXTENSION
TO SERVE LOT 1, GOLDENS HILLS 3RD
ADDITION
PRIV. PROJ. NO. 414 PPS (607861)
BUILT BY PEARSON EXCAVATION, INC.
BOOKED 6-28-94 FROM AS BUILTS

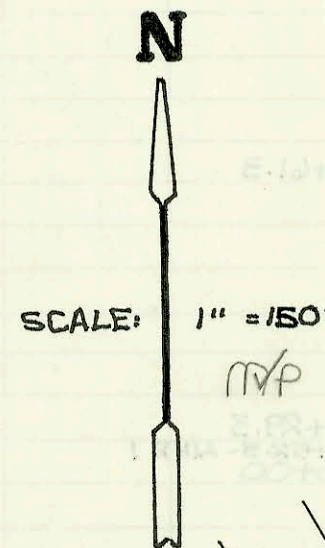

CONSTRUCTION RECORD						SERVICE RECORD						
STATION	ELEVATION		Depth	MANHOLE	4-INCH "Y" BRANCHES		No. of Permit		House Number		DATE OF PERMITS	
	Ground	Grade			North West	South East	North West	South East	North West	South East	North West	South East
Private Sanitary Sewer Extension To Serve Hall Industrial Addition												
0+00	106.58	98.46 OUT 98.56 IN	8.1	0+00								
	107.10	98.92	8.2	0+71.5	4" sch 40 4" stubs		94-698-7		4400 Sun Blvd		5-10-94	
Private Sanitary Sewer Extension To Serve Lot 1, Golden Hills 3RD Addition												
0+00	162.13	146.33 OUT 148.07 IN	15.8	0+00								
1+00	160.30	148.96	11.3		4" sch 40 4" stubs		94-10187		707 #700 Golden Hills		6-28-94	
2+00	159.40	149.84	9.6									
	157.68	150.41 OUT 150.47 IN	7.3	2+64.2	4" stubs							
3+00	158.10	150.63	7.5									
4+00	158.00	151.06	6.9		4" sch 40 4+77.0 4" sch 40 4+78.2 4" sch 40 4+79.2	3+98.8 4" sch 40 4+00.2	94-10177 94-10187 94-10187	94-10177	707 #400 Golden Hills 707 #600 Golden Hills 707 #800 Golden Hills	707 #100 Golden Hills 707 #200 Golden Hills	6-28-94 6-28-94 6-28-94	6-28-94 6-28-94
5+00	158.50	151.50	7.0		4" sch 40 4" stub W 4" stub NW 4" sch 40	4" sch 40 5+56.4	94-10180 94-10187	94-10179 94-10179	707 #500 Golden Hills 707 #300 Golden Hills	707 #900 Golden Hills	6-28-94 6-28-94	6-28-94 6-28-94