

PRIVATE SANITARY SEWER EXTENSION TO SERVE
TOWNE PARC 5TH ADDITION
PRIV. PROJ. NO. 435 PPS (607861)
BUILT BY W. B. CARTER CONST. CO.
BOOKED 6-29-94 FROM AS BUILTS


N

SCALE: 1" = 150'


NO SCALE MP

SEE N-112A

SEE N-55
EXISTING 8" SEWER

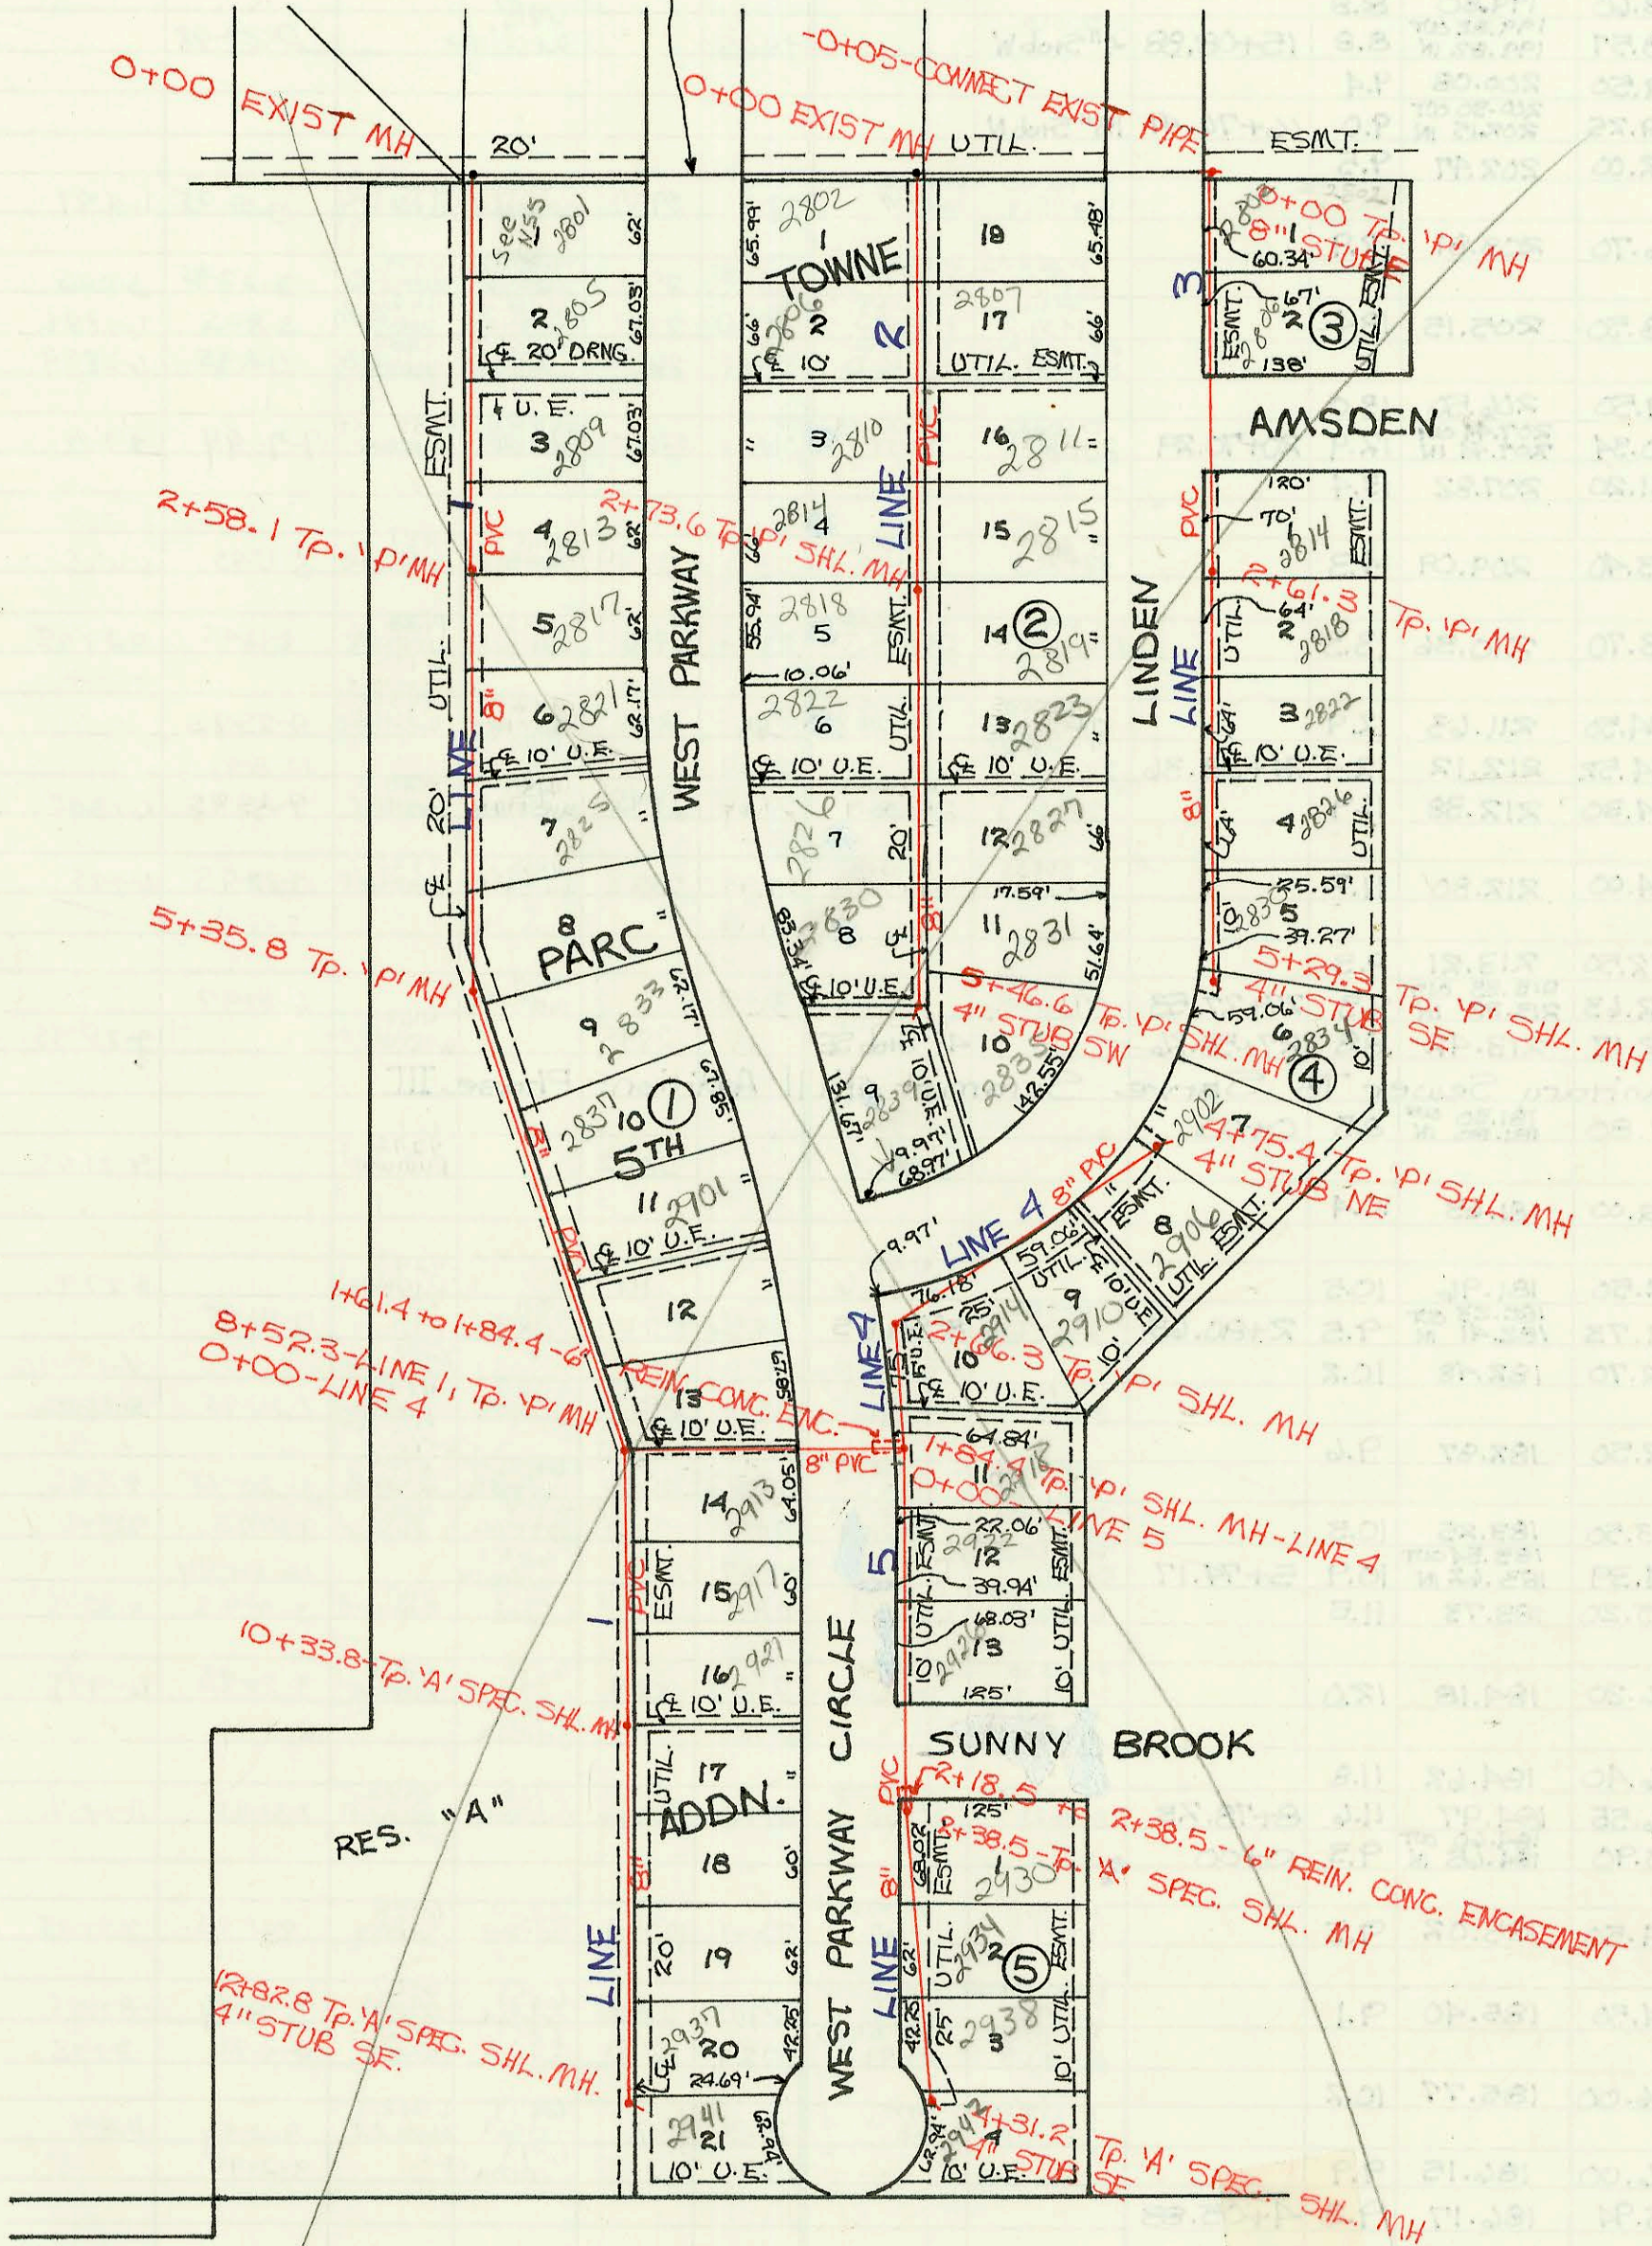

SANITARY SEWER TO SERVE
TOWNE PARC 5TH ADDITION
PROJECT NO. 435PPS (607861)
BUILT BY W. B. CARTER CONSTRUCTION CO.
BOOKED 6/29/94 FROM AS BUILTS

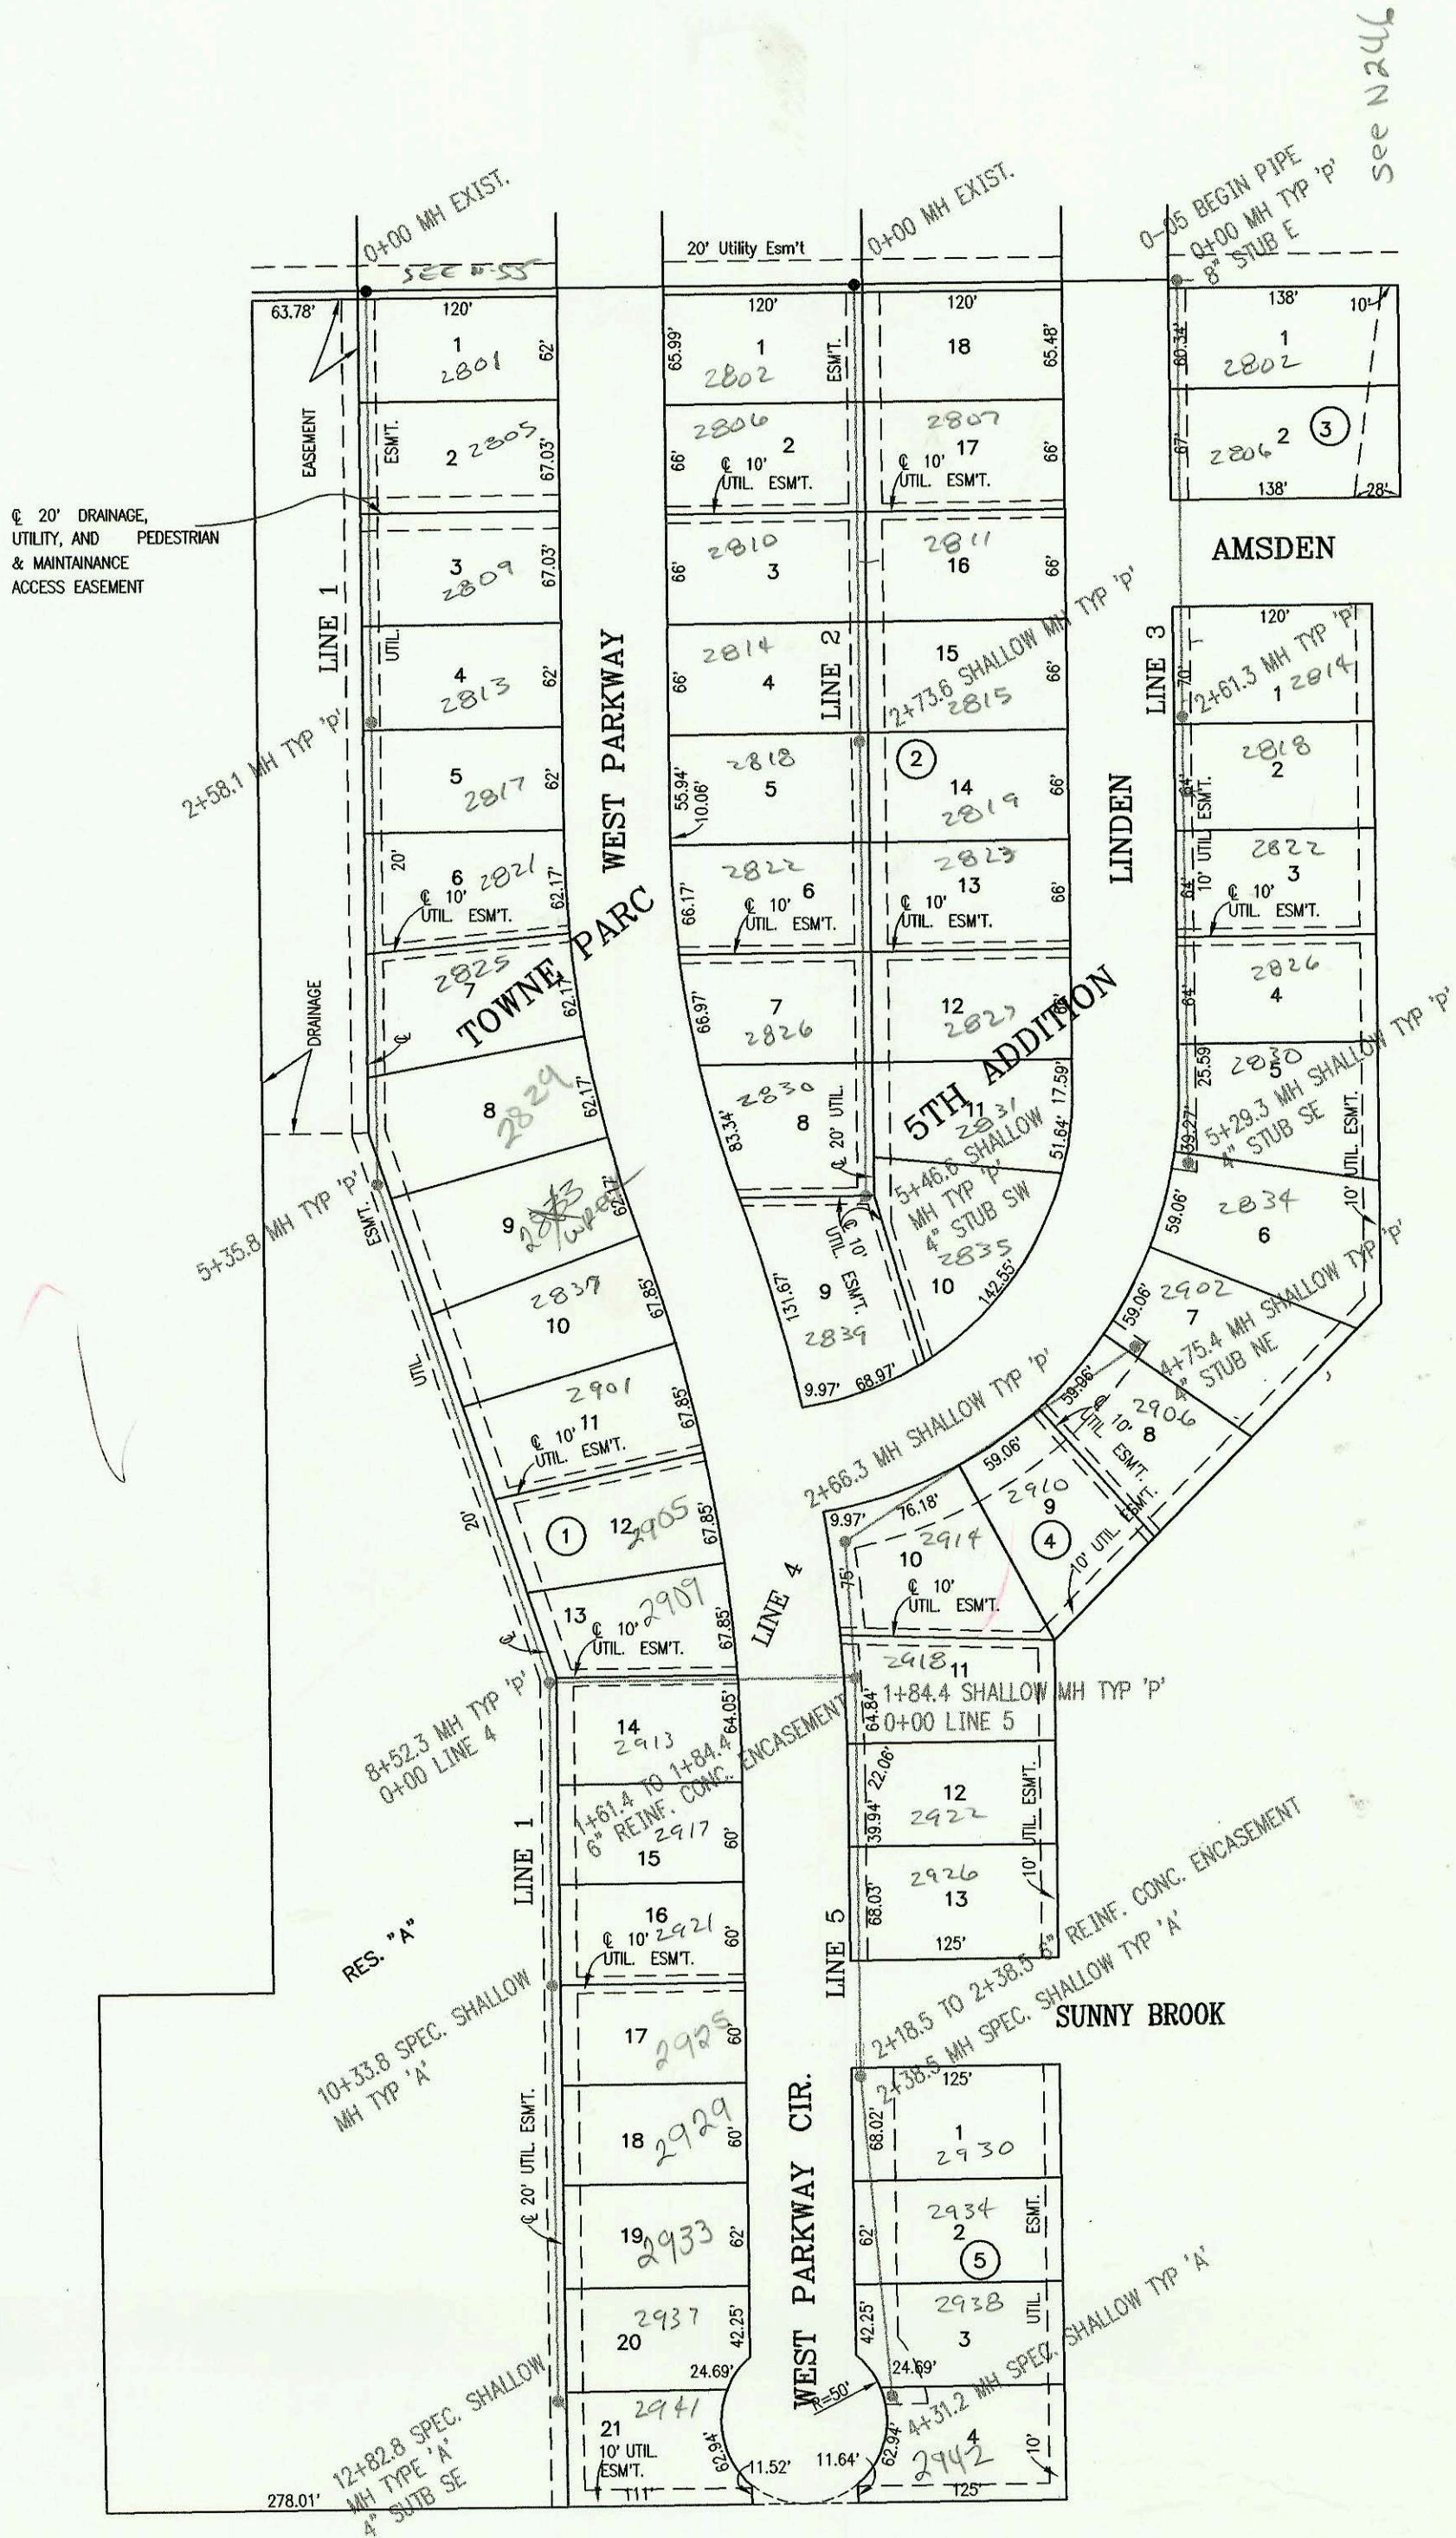

CONSTRUCTION RECORD

SERVICE RECORD

STATION	ELEVATION		Depth	MANHOLE	4-INCH "Y" BRANCHES		No. of Permit		House Number		DATE OF PERMITS	
	Ground	Grade			North West	South East	North West	South East	North West	South East	North West	South East
Private Sanitary Sewer to Serve Towne Parc 5th Addition												
0+00	206.31	199.86 OUT 199.95 IN	6.5	0+00								
1+00	207.00	200.22	6.8									
2+00	207.00	200.48	6.5									
	207.45	200.64 OUT 200.64 IN	6.8	2+58.1								
3+00	207.30	200.77	6.5									
4+00	207.00	201.07	5.9									
5+00	207.00	201.38	5.6									
	207.50	201.49 OUT 201.61 IN	6.0	5+35.8								
6+00	207.20	201.83	5.4									
7+00	207.30	202.18	5.1									
8+00	207.40	202.52	4.9									
	208.19	202.70 OUT 202.77 IN	5.5	8+52.3	0+00-LINE 4							
9+00	207.40	202.86	4.5									
10+00	207.40	203.06	4.3									
	207.78	203.13 OUT 203.18 IN	4.7	10+33.8								
11+00	207.50	203.37	4.1									
12+00	207.50	203.66	3.8									
	207.85	203.90	4.0	12+82.8								
0+00	208.54	200.93 OUT 201.01 IN	7.6	0+00	4" SDR 35 0+23.6							
1+00	206.20	201.27	4.9									
2+00	206.20	201.53	4.7									
	207.50	201.72 OUT 201.72 IN	5.8	2+73.6								
3+00	207.20	201.81	5.4									
4+00	208.20	202.13	6.1									
5+00	209.20	202.46	6.7									
	209.90	202.61	7.3	5+46.6								
-0+05	210.50	201.41	9.1									
0+00	209.75	201.45 OUT 201.52 IN	8.3	0+00	8" Stub E							
1+00	208.70	201.75	7.0									
2+00	208.70	202.98	5.7									
	209.95	202.12 OUT 202.20 IN	7.8	2+61.3								
3+00	208.40	202.32	6.1									
4+00	209.50	202.65	6.9									
5+00	209.50	202.97	6.5									
	209.90	203.06	6.8	5+29.3								
0+00	208.19	202.70 OUT 202.77 IN	5.5	8+52.3-LINE 1 0+00	4" Stub SE							
1+00	208.00	203.05	5.0									
	208.41	203.28 OUT 203.36 IN	5.1	0+00-LINE 5 1+84.4								
2+00	207.90	203.42	4.5									
	208.94	203.75 OUT 203.75 IN	5.2	2+66.3								
3+00	208.50	203.89	4.6									
4+00	208.90	204.16	4.7									
	209.56	204.36	5.2	4+75.4								
0+00	208.41	203.28 OUT 203.42 IN	5.1	1+84.4-LINE 4 0+00	4" Stub NE							
1+00	207.70	203.71	4.0									
2+00	207.00	204.00	3.0									
	208.12	204.12 OUT 204.20 IN	4.0	2+38.5								
3+00	208.00	204.40	3.6									
4+00	208.50	204.74	3.8									

LINE 1

LINE 2

LINE 3

LINE 4

LINE 5

209.04 204.84 4.2 4+31.2 4" Stub SE 97-15067 2972 West PKwy 1-24-97
 Form #192-020 (July, 1981)
 96-1636-7 2918 S. West PKwy - (NSP Meas. 115' S. of Mt 2+66.3 on Line 4)