
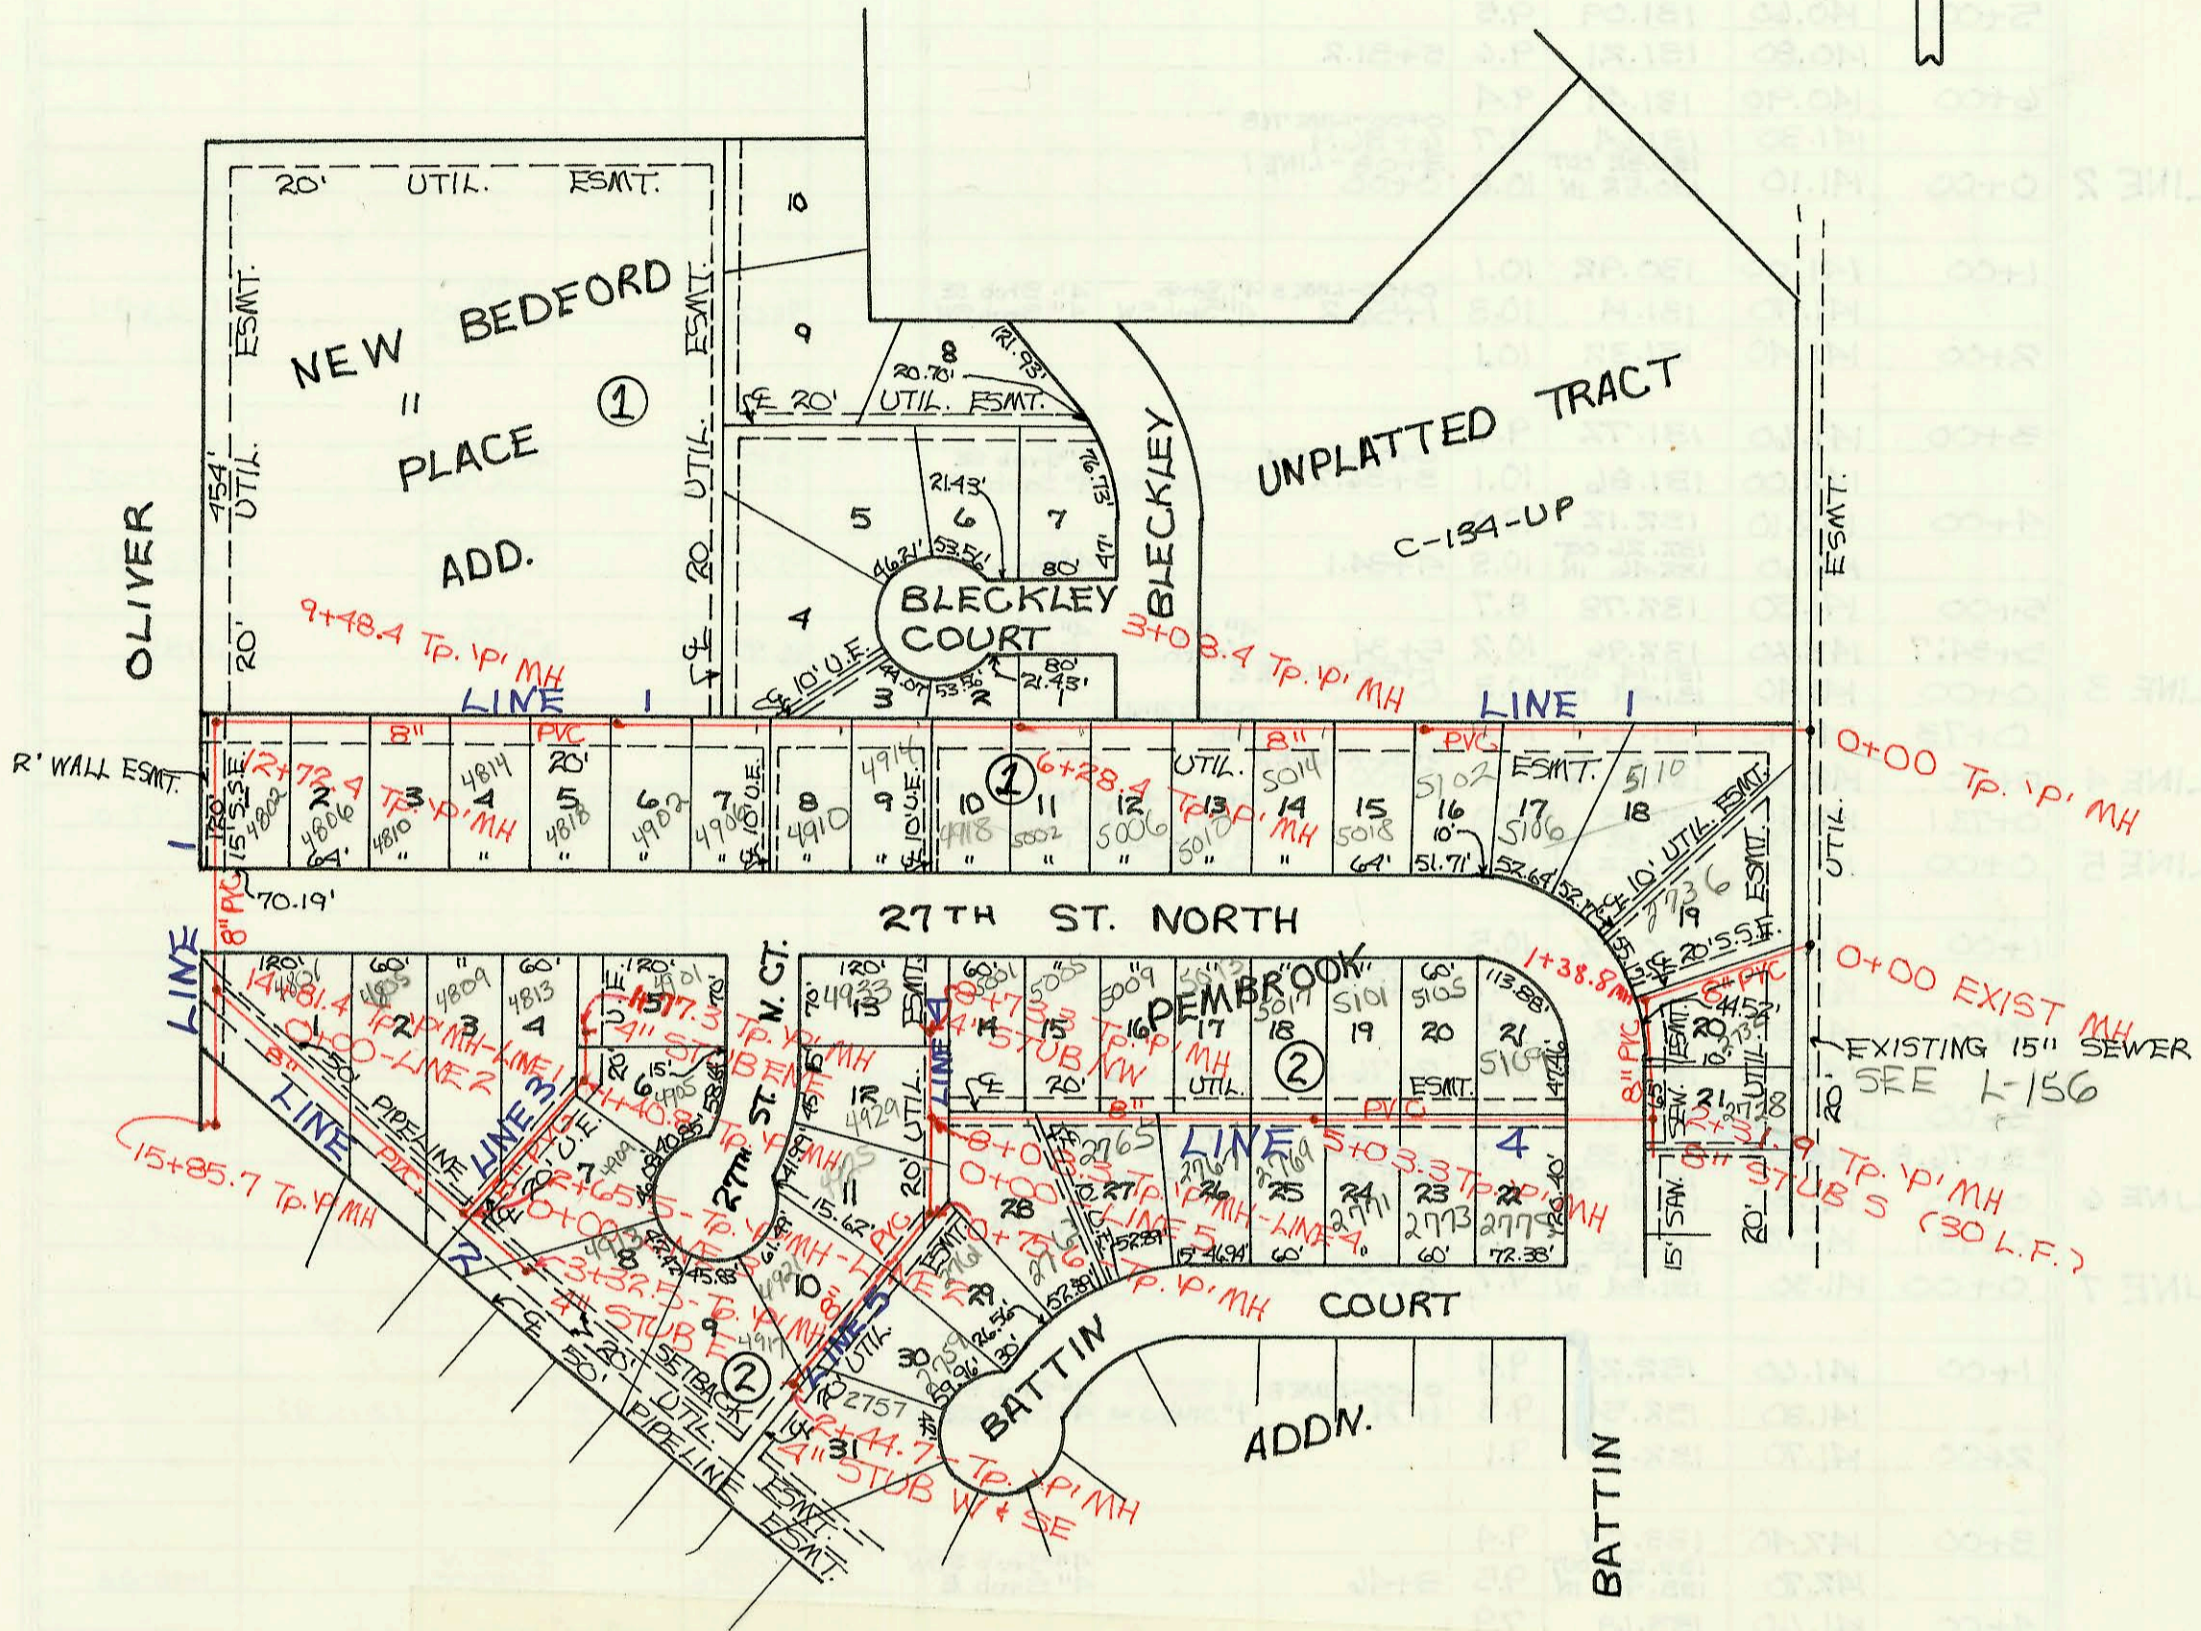


LATERAL 64, MAIN 5, S.S.#23
 PROJ. NO. 468-82360 (741801)
 BUILT BY NOWAK CONSTRUCTION CO.
 BOOKED 7-25-94 AS PER PLAN

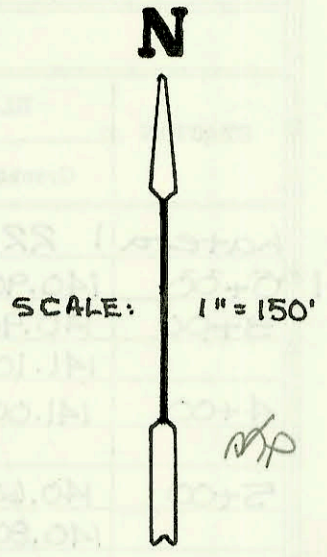

SEWER SERVICE TABLE

(See detail and notes, sheet no. 14)

N-114

NO.	SIZE	LOCATION				FOR INFORMATION ONLY		RECORD INFORMATION		NO.
		BLOCK NO.	LOT NO.	LINE NO.	STATION/DIRECTION	APPROXIMATE LENGTH 4" PIPE		(To be completed by Project Inspector)		
						VERTICAL	HORIZONTAL	DISTANCE FROM NEAREST MANHOLE		
								UPSTREAM	DOWNSTREAM	
1	8"x4"	1	18	1	0+90/Lt.	9'	14'			1
2	8"x4"	1	17	1	1+80/Lt.	11'	14'			2
3	8"x4"	1	16	1	2+60/Lt.	13'	14'			3
4	8"x4"	1	15	1	3+30/Lt.	14'	14'			4
5	8"x4"	1	14	1	3+90/Lt.	15'	14'			5
6	8"x4"	1	13	1	4+50/Lt.	17'	14'			6
7	8"x4"	1	12	1	5+15/Lt.	18'	14'			7
8	8"x4"	1	11	1	5+75/Lt.	18'	14'			8
9	8"x4"	1	10	1	6+50/Lt.	17'	14'			9
10	8"x4"	1	9	1	7+10/Lt.	15'	14'			10
11	8"x4"	1	8	1	7+70/Lt.	14'	14'			11
12	8"x4"	1	7	1	8+40/Lt.	13'	14'			12
13	8"x4"	1	6	1	9+00/Lt.	12'	14'			13
14	8"x4"	1	5	1	9+70/Lt.	11'	14'			14
15	8"x4"	1	4	1	10+30/Lt.	10'	14'			15
16	8"x4"	1	3	1	11+00/Lt.	9'	14'			16
17	8"x4"	1	21	4	2+10/Lt.	9'	10'			17
18	8"x4"	2	26	4	5+70/Lt.	8'	4'			18
19	8"x4"	2	17	4	5+75/Rt.	8'	14'			19
20	8"x4"	2	16	4	6+30/Rt.	9'	14'			20
21	8"x4"	2	27	4	6+40/Lt.	9'	4'			21
22	8"x4"	2	15	4	6+80/Rt.	10'	14'			22
23	8"x4"	2	28	4	7+30/Lt.	10'	4'			23
24	8"x4"	2	14	4	7+50/Rt.	10'	14'			24
25	8"x4"	2	12	4	8+25/Lt.	10'	4'			25
26	8"x4"	2	11	5	0+40/Rt.	11'	4'			26
27	8"x4"	2	29	5	0+90/Lt.	10'	14'			27
28	8"x4"	2	30	5	1+50/Lt.	9'	14'			28
29	8"x4"	2	10	5	1+55/Rt.	9'	4'			29

1. Vertical Riser Pipe shall be extended to 2' minimum above ground water elevation and 4' maximum below proposed ground elevation.

CONSTRUCTION RECORD							SERVICE RECORD					
STATION	ELEVATION		Depth	MANHOLE	4-INCH "Y" BRANCHES		No. of Permit		House Number		DATE OF PERMITS	
	Ground	Grade			North West	South East	North West	South East	North West	South East	North West	South East
LINE 1	0+00	163.10	151.47 152.05	11.6	0+00							
	1+00	165.20	152.35	12.9		0+90-4" Riser S. 4" sch 40	95-8835-7		5110 E 27th			6-14-95
	2+00	167.70	152.65	15.1		1+80-4" Riser S.	97-2505-7		5100 E 27th			2-14-97
	3+00	170.80	152.95	17.9		2+60-4" Riser S.						
	3+00	170.80	152.98	17.8	3+08.4	3+30-4" Riser S.	97-11521-7		5018 B E 27th			1-12-2000 7-11-97
	4+00	172.70	153.25	19.5		3+90-4" Riser S.	96-1969-7		5014 E 27th			11-19-96
	5+00	175.20	153.55	21.7		4+50-4" Riser S. 4" SDR 35	95-7610-7		5010 E 27th			5-19-95
	6+00	175.00	153.85	21.2		5+15-4" Riser S. 4" SDR 35	95-13868-7		5006 E 27th			8-30-95
	6+00	175.00	153.94	21.1	6+28.4	5+75-4" Riser S.	96-19731-7		5002 E 27th			11-19-96
	7+00	173.50	154.15	19.4		6+50-4" Riser S.	96-19732-7		4918 E 27th			11-19-96
	7+00	173.50	154.15	19.4		7+10-4" Riser S. 4" PVC 40	94-16624-7		4914 E 27th			11-9-94
	8+00	172.10	154.45	17.7		7+70-4" Riser S. 4" SDR 35	96-7541-7		4910 E 27th			5-17-96
	9+00	170.50	154.75	15.8		8+40-4" Riser S. 4" SDR 35	94-15994-7		4906 E 27th N			9-30-94
	9+00	170.20	154.90	15.3	9+48.4	9+00-4" Riser S. 4" SDR 35 TAP	94-10527-7		4902 E. 27th N.			7-1-94
	10+00	169.10	155.05	14.1		9+70-4" Riser S. 4" SDR 35 N/C	94-10523-7		4878 E. 27th N.			7-1-94
11+00	167.70	155.35	12.4		10+30-4" Riser S.	94-10521-7		4814 E. 27th N.			7-1-94	
12+00	166.00	155.65	10.4		11+00-4" Riser S. 4" PVC 40 TAP	94-9929-7		4810 E. 27th N.			5-31-94	
12+00	165.10	155.87 156.07	9.7	12+72.4	11+98.4 N/C 4" SCH. 40 T.V.C. 12+46.4 N/C	94-10522-7 94-10323-7		4806 E. 27th N. 4803 E. 27th NO.			7-1-94 6-30-94	
13+00	165.00	156.15	8.9									
14+00	165.80	156.45	9.4									
14+00	166.10	156.69	9.4	14+81.4								
15+00	165.50	156.75	8.8									
15+00	166.10	157.01	9.1	15+85.7								
LINE 2	0+00	166.10	156.69 156.89	9.4	14+81.4-LINE 1 0+00							
	1+00	166.90	157.69	9.2			96-18655-7		4801 E 27th N			11-7-96
	2+00	168.30	158.49	9.8		4" SDR 35 1+62.5	95-20105-7		4805 E 27th			12-4-95
LINE 3	0+00	169.40	159.01 159.21	10.4	0+00-LINE 3 2+65.5							
	1+00	170.50	160.71	9.8		4" SDR 35 1+21.8 N/C	94-10531-7		4813 E. 27th N.			7-1-94
	1+00	171.50	161.32 161.52	10.2	1+40.8		97-6582-7		4909 W 27th			4-16-98
LINE 4	0+00	164.32	152.24 154.24	12.1	0+00							
	1+00	167.80	155.74	12.1		4" Stub E	97-11513-7		4901 E 27th ct			7-3-97
	1+00	169.20	156.32 156.52	13.3	1+38.8		95-4287-7		4901 Battin			3-22-95 11-21-97
2+00	169.10	156.76	12.3		2+10-4" Riser E. 4" sch 40 PK	94-10317-7		4908 Battin			6-30-94	
2+00	169.04	156.89 157.09	12.3	2+31.9	8" Stub S			4905 Battin			10-27-97	
3+00	169.00	158.05	11.0		4" SDR 35 3+52.7	97-19180-7		5109 E 27th N			5-17-96	
4+00	170.50	159.45	11.1			97-7438-7		5105 E 27th N			5-1-97	
5+00	172.40	160.84	11.6			96-19681-7		5101 E 27th			11-19-96	
5+00	172.40	160.89	11.5	5+03.3	5+75-4" Riser N. 4" SDR 35	96-19681-7		5011 E 27th			10-9-96	
6+00	173.50	161.28	12.2		6+30-4" Riser N. 4" PK 40	96-11547-7		5013 E 27th			7-2-95	
6+00	173.50	161.28	12.2		6+40-4" Riser S.	95-20177-7		5009 E 27th N			12-7-95	
7+00	175.00	161.68	13.3		6+80-4" Riser N. 4" SDR 35	95-20146-7		5005 E 27th N			12-20-95	
8+00	176.60	162.08	14.5		7+50-4" Riser 4" SDR 35	95-20143-7		5001 E 27th N			12-19-95	
8+00	176.60	162.11 162.31	14.5	8+08.3	8+25-4" Riser W. 4" sch 40	95-8826-7		4924 E 27th ct			6-14-95	
8+00	175.60	163.61	12.0	8+73.3	4" Stub NW	97		4933 E 27th ct.				
LINE 5	0+00	176.60	162.11 162.31	14.5	8+08.3-LINE 4 0+00							
	1+00	177.00	162.41 162.81	14.4	0+75.6	0+90-4" Riser ESE	95-12712-7		4985 E 27th ct			8-10-95
	1+00	176.30	162.91	13.4		1+55-4" Riser NW 4" SDR 35	97-8255-7		4981 E 27th ct			5-3-99
2+00	174.70	163.31	11.4		1+50-4" Riser SE	95-20161-7		4981 E 27th ct			12-4-95	
2+00	174.40	163.49	11.2	2+44.7	4" Stub W	96-12181-7		4917 E 27th ct			8-6-96	
2+00	174.40	163.49	11.2	2+44.7	4" Stub SE	98-6587-7		4917 E 27th ct			4-16-98	