

SCALE: 1" = 150'

nhp



PRIVATE SANITARY SEWER EXTENSION TO SERVE LOT 1, P.C. INDUSTRIAL ADDITION PRIV. PROJ. NO. 481 PPS (607861) BUILT BY McCULLOUGH EXCAVATION BOOKED 12-5-94 FROM AS BUILTS

PRIVATE SANITARY SEWER EXTENSION TO LOT 1, WILLHITE ADDITION PRIV. PROJ. NO. 472 PPS (607861) BUILT BY MIES CONST. CO. BOOKED 12-6-94 FROM AS BUILTS

0+69.63 - 8" CLEANOUT RISER
4" WYES NW & NE

20' x 93' UTIL. ESMT. BY SEP. INST.

SEE J-122 EXISTING 8" SEWER

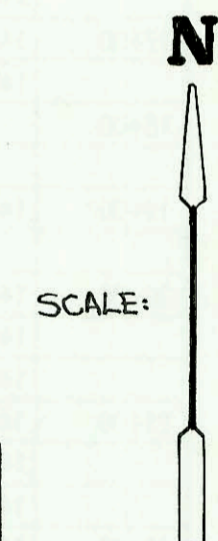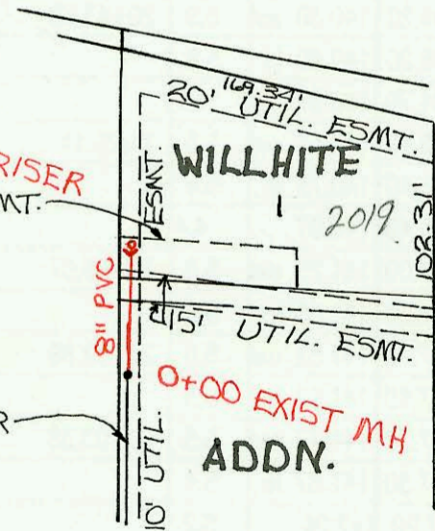


SCALE: 1" = 100'

nhp

McCLEAN

CUSTER

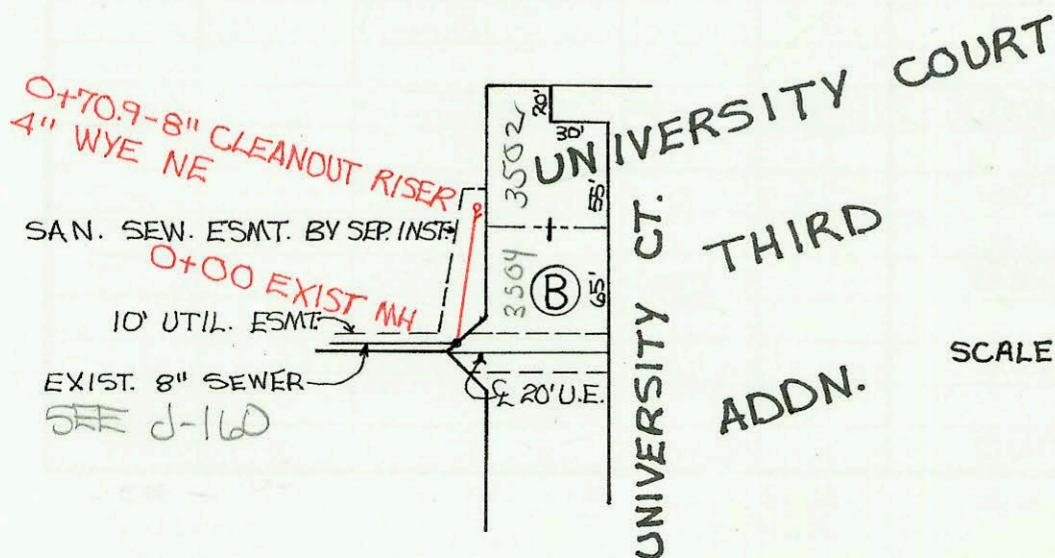

SCALE: 1" = 100'

nhp

PRIVATE SANITARY SEWER EXTENSION TO SERVE LOT 1, BLOCK B, UNIVERSITY COURT THIRD ADDITION PRIV. PROJ. NO. 482 PPS (607861) BUILT BY UTILITY MAINTENANCE CONTRACTORS BOOKED 12-6-94 FROM AS BUILTS

CONSTRUCTION RECORD					SERVICE RECORD							
STATION	ELEVATION		DEPTH	MANHOLE	4-INCH "Y" BRANCHES		No. of Permit		House Number		DATE OF PERMITS	
	GROUND	GRADE			North West	South East	North West	South East	North West	South East	North West	South East
Private Sanitary Sewer Extension To Serve Lot 1, P.C. Industrial Addition												
0+00	88.40	75.81 OUT 76.64 IN	12.6	0+00								
		89.06	76.80 IN	12.4	0+12.8	6" Stub W						
1+00	88.50	77.14	11.4									
2+00	88.00	77.65	10.4									
3+00	87.80	78.15	9.7									
	87.88	78.17	9.7	3+03.8	6" SDR 35 6" stub SW		94-16793-7	5015 S. Water Cir.			10-13-94	
Private Sanitary Sewer Extension To Lot 1, Willhite Addition												
0+00	125.50	117.40 OUT 117.79 IN	8.1	0+00								
0+69.63	125.85	118.07	7.8		4" Wye NW	4" S.D.R. 35 4" Wye NE	94-18194-7	2019 McBean			11-8-94	
Private Sanitary Sewer Extension To Serve Lot 1, Block B, University Court Third Addition												
0+00	119.10	109.70 OUT 111.73 IN	9.4	0+00								
0+70.9	119.10	112.36	6.7			4" SDR 35 4" Wye NE	94-17117-7	3502 W. University			10-24-94	