


LATERAL 26, MAIN 24, WAR INDUSTRIES SEWER
 PROJECT NO. 468-82390 (741991)
 BUILT BY DULING CONSTRUCTION CO.
 BOOKED 12/9/94 PER PLAN

check to see if in B/D before issuing further permit to connect to MH stubs NE 5/27/95

Prop. Lot split Main Street

Prop Bldg 2682 require Main Street San.

PRIV. SAN. SEWER FOR SUNSET ADDN.
 PROJECT NO. 503PPS (607861)
 BUILT BY MIES CONSTRUCTION CO.
 BOOKED 12/9/94 PER AS BUILT PLAN

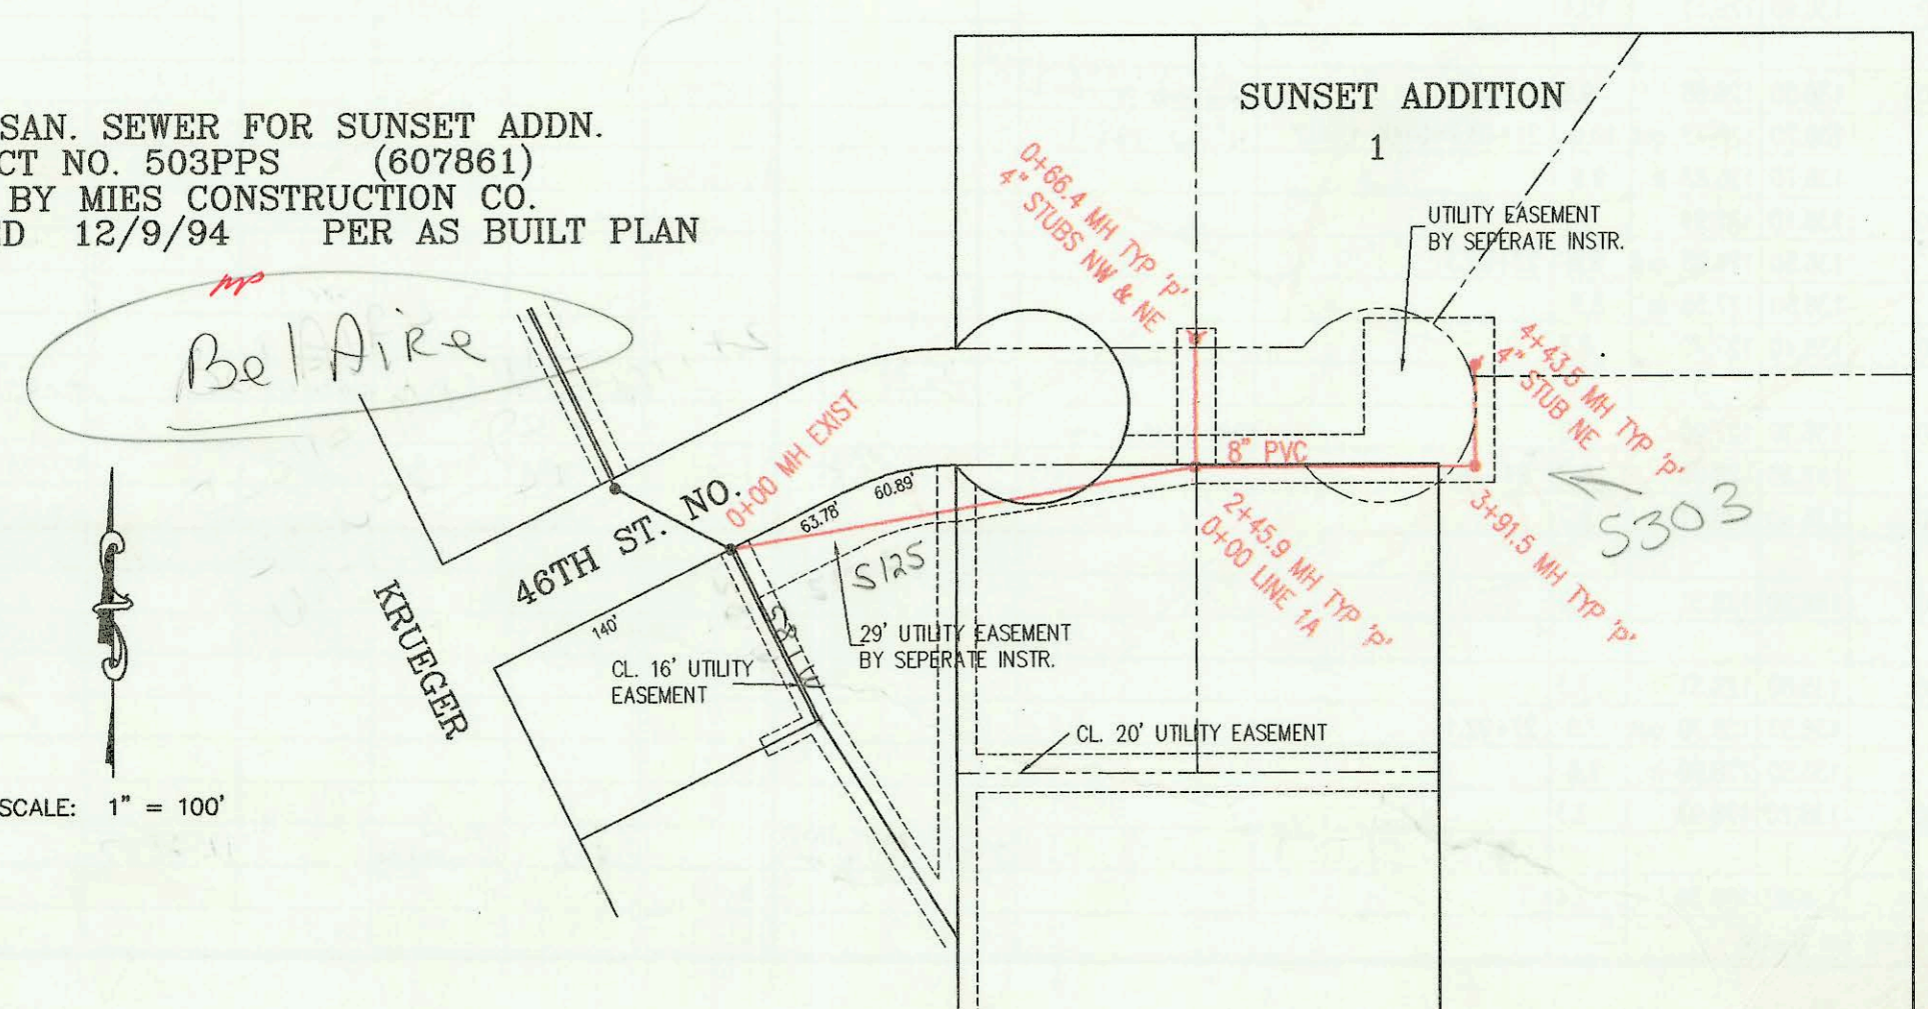

SCALE: 1" = 100'

