


See Sep. Stmt
RES C. File 1452
Pg. 1931
Pg. of DEEDS

Note:
DL advised 2/26/96
that he hit water at
9' Had to de-water
to de-water BR

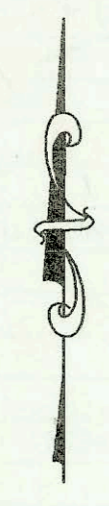

SCALE: 1" = 100'

LATERAL 32, MAIN 15, SOUTHWEST INTERCEPTOR SEWER
PROJECT NO. 468-82334 (741736)
BUILT BY W. B. CARTER CONSTRUCTION CO.
BOOKED 12/8/94 PER PLAN

San. Sewer Ext. for
Lake Ridge 3rd Addn
521 PPS
Built by ~~W.B. Carter~~ Mies Const.
Booked 10/19/98 from A.B. Plan
page N-136

All of Reserve
An

Note: There
should be 15"
along 36"
36" STORM
Lake

21ST ST NO

CONSTRUCTION RECORD					SERVICE RECORD							
STATION	ELEVATION		DEPTH	MANHOLE	4-INCH "Y" BRANCHES		No. of Permit		House Number		DATE OF PERMITS	
	GROUND	GRADE			North West	South East	North West	South East	North West	South East	North West	South East
LAT 32, MAIN 15, SW INTERCEPTOR												
L-1 0+05	136.20	122.56	13.6	0+05 EXIST								
1+10	136.10	122.72	13.4			1+25 4" S 128.3		96-6354-7	2377 N Sandplum			4-19-96
2+00	136.70	122.85	13.9			2+01 4" S 128.9		2000-01674	2373 N Sandplum			7-20-00
						2+66 4" S 129.1		2000-01675	2369 Sandplum			7-20-00
3+00	136.50	123.00	13.5			3+31 4" S 128.7		97-1964-7	2365 Sandplum			2-7-97
	135.90	123.12 out	12.8	3+80.0		4" SW 124.72 Sch 40		2000-2105	2361 Sandplum			9-25-00
	135.90	123.22 in	12.7									
4+00	135.60	123.25	12.4									
						4+61 4" S 127.3		2001-01640	2357 Sandplum			7-6-01
5+00	135.70	123.40	12.3									
						5+34 4" S 128.4		97-19047-7	2355 Sandplum			9-30-97
6+00	136.50	123.56	12.9									
						6+26 4" S 128.6		2001-03131	2349 Sandplum			11-21-01
7+00	135.30	123.71	11.6									
	135.60	123.75 out	11.9	7+27.8		8" N 124.15	4" S 125.75	96-26943-7	2345 Sandplum			12-16-95
	135.60	123.85 in	11.8									
8+00	134.30	123.96	10.3									
	134.50	123.99 out	10.5	8+16.7		MHTAP 4" Sch 40 8+66 4" 129.2		96-5080-7	2341 Sandplum			4-10-96
	134.50	124.09 in	10.4									
9+00	134.90	124.21	10.7									
	134.50	124.35 out	10.2	9+88.8		MHTAP 4" Sch 40 4" S 126.3		97-87-7	2337 Sandplum			12-26-96
	134.50	124.45 in	10.1									
10+00	133.00	124.47	8.5									
11+00	128.00	124.62	3.4									
12+00	133.50	124.77	8.7									
13+00	137.60	124.93	12.7									
	137.90	124.99 out	12.9	13+40.0		4" NE 126.99	4" SE 126.99	97-18521-7	6710 Garden Ridge	6711 W Garden Ridge	10-22-97	6-17-97
	137.90	125.09 in	12.8									
14+00												
	137.60	125.19 out	12.4	14+03.6		4" NW 127.19 Sch 35		95-16643-7	6714 Garden Ridge		10-17-95	
	137.60	125.29 in	12.3									
15+00												
	137.00	125.45 out	11.6	15+08.6=0+00 L-1A		4" NW 127.5						
	137.00	125.55 in	11.4			4" PVC 90 15+90.6		96-16232-7	6718 Garden Ridge		9-30-96	
16+00	136.50	125.69	10.8									
17+00	136.10	125.84	10.3									
18+00	136.50	126.00	10.5									
	136.80	126.03 out	10.8	18+21.3=0+00 L-1B		MHTAP 4" Sch 40 4" NW 128.0		95-20168-7	6810 Garden Ridge	6806 Garden Ridge	12-19-95	4-17-91
	136.80	126.13 in	10.7									
19+00	136.80	126.25	10.6									
	137.50	126.35 out	11.2	19+63.0		4" W 128.4		96-1900-7	6902 Garden Ridge		2-5-96	
	137.50	126.45 in	11.1			4" N 128.4						
20+00	136.90	126.51	10.4					97-9530-7	6946 Garden Ridge		6-12-97	
21+00	136.50	126.66	9.8					94-19735-7	6970 W Garden Ridge		12-1-94	
	136.70	126.73 out	10.0	21+48.7=0+00 L-1C		4" W 128.7		12-18948-7	6976 Garden Ridge		10-6-98	
	136.70	126.83 in	9.9									
22+00	136.10	126.91	9.2									
	136.50	126.95 out	9.6	22+26.3								
	136.50	127.55 in	8.9									
23+00	136.40	127.70	8.7									
24+00	136.90	127.90	9.0					96-3622-7	6821 W Garden Ridge		3-14-96	
	137.30	128.06	9.2	24+76.1		4" Sch 40 24+54.5		99-010401	6903 Garden Ridge		10-28-99	
25+00	136.80	128.11	8.7					2001-03096	6907 Garden Ridge		12-5-01	
26+00	136.20	128.31	7.9									
								99-11501-7	6914 Garden Ridge		6-2-99	
27+00	135.80	128.51	7.3									
	136.50	128.70 out	7.8	27+92.1								
	136.50	128.90 in	7.6									
28+00	136.20	128.93	7.3									
29+00	136.80	129.36	7.4					2005-03152	6923 W Garden Ridge		12-29-05	
CONTINUED ON N-136												