

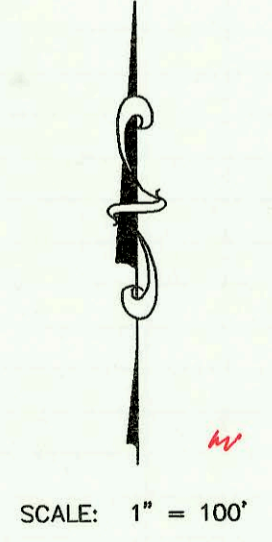
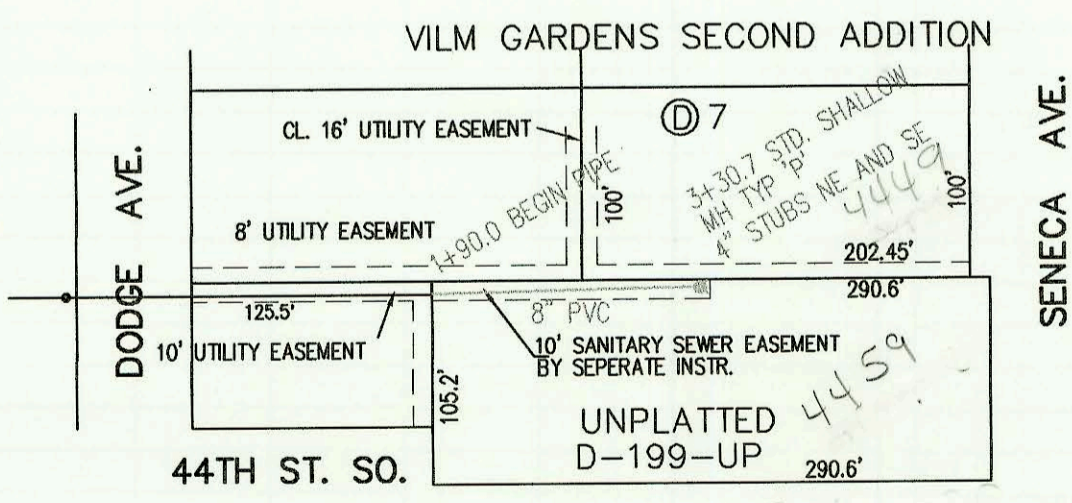


1994 SANITARY SEWER REHABILITATION PROGRAM- PHASE II
 PROJ. NO. 468-82399 (623124)
 BUILT BY INSITUFORM PLAINS, INC.
 BOOKED 2/16/95 AS PER PLANS

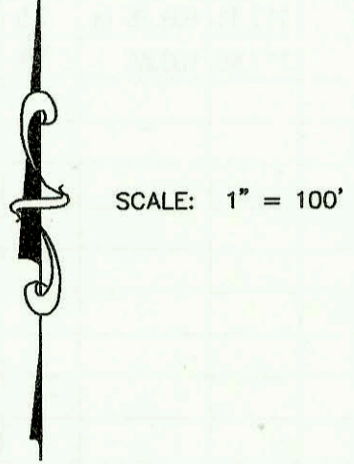

LATERAL 51, MAIN 3, SW. INTERCEPTOR SEWER
 PROJECT NO. 468-82409 (742080)
 BUILT BY W. B. CARTER CONSTRUCTION CO.
 BOOKED 2/24/95 PER PLAN

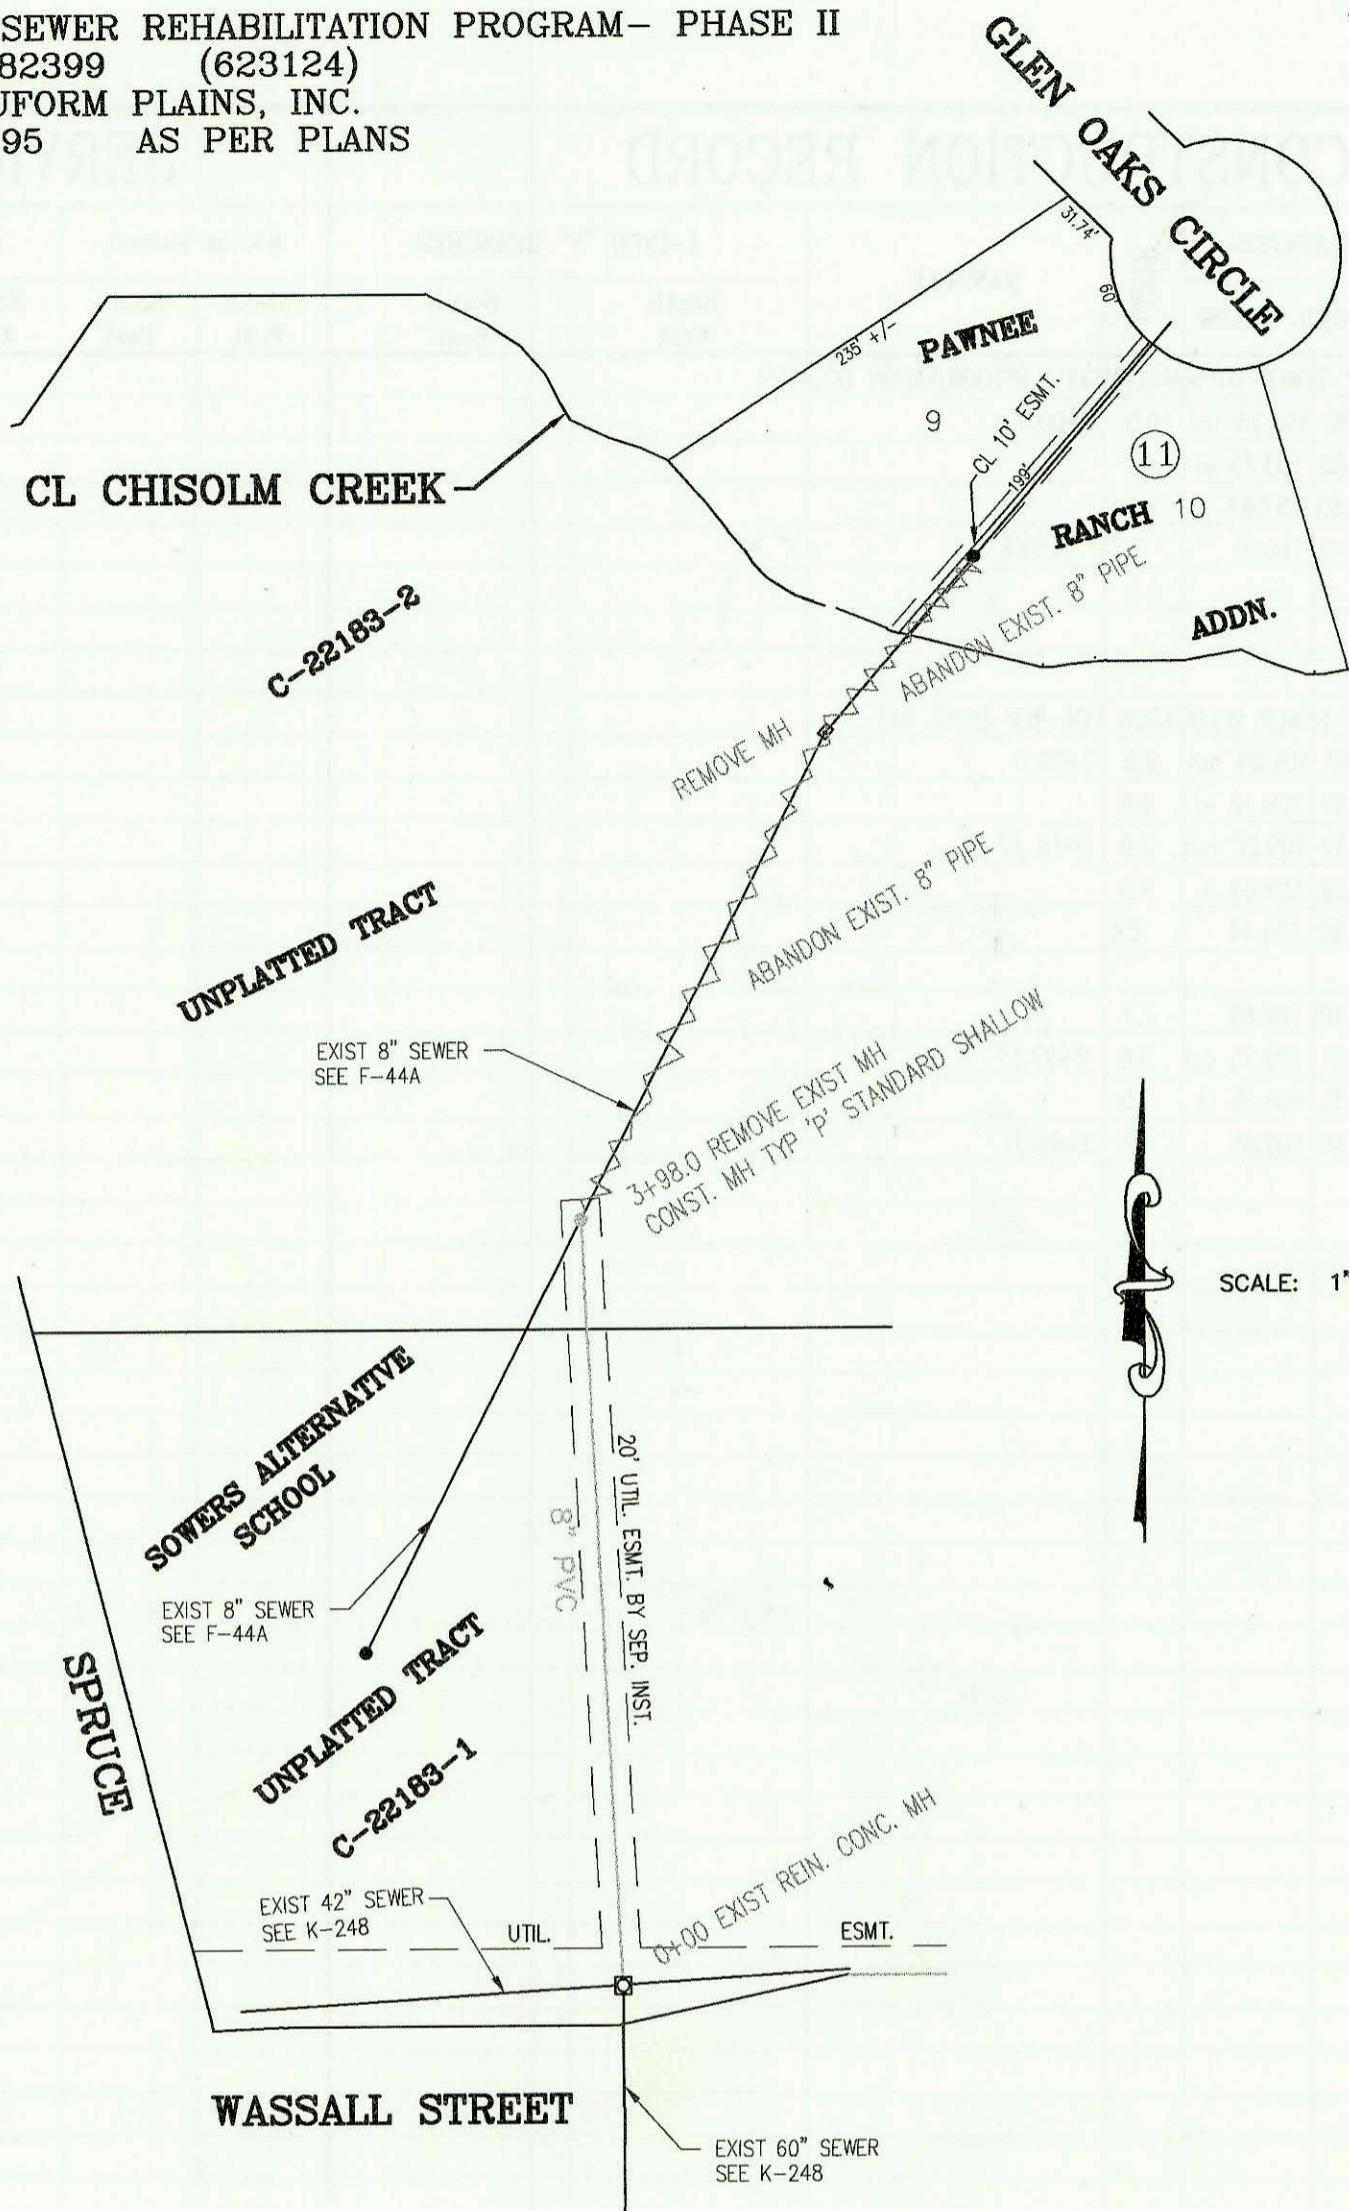