
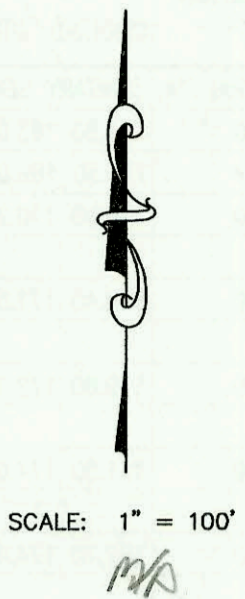


PRIVATE SANITARY SEWER TO WICHITA REHABILITATION HOSPITAL
 PRIVATE PROJECT NO. 301PPS (607861)
 BUILT BY W. B. CARTER CONSTRUCTION CO.
 BOOKED 02/23/95 AS PER PLAN

NOTE: MANHOLE AT STA. 1+59.6 WAS NOT TESTED OR ACCEPTED BY THE CITY OF WICHITA.

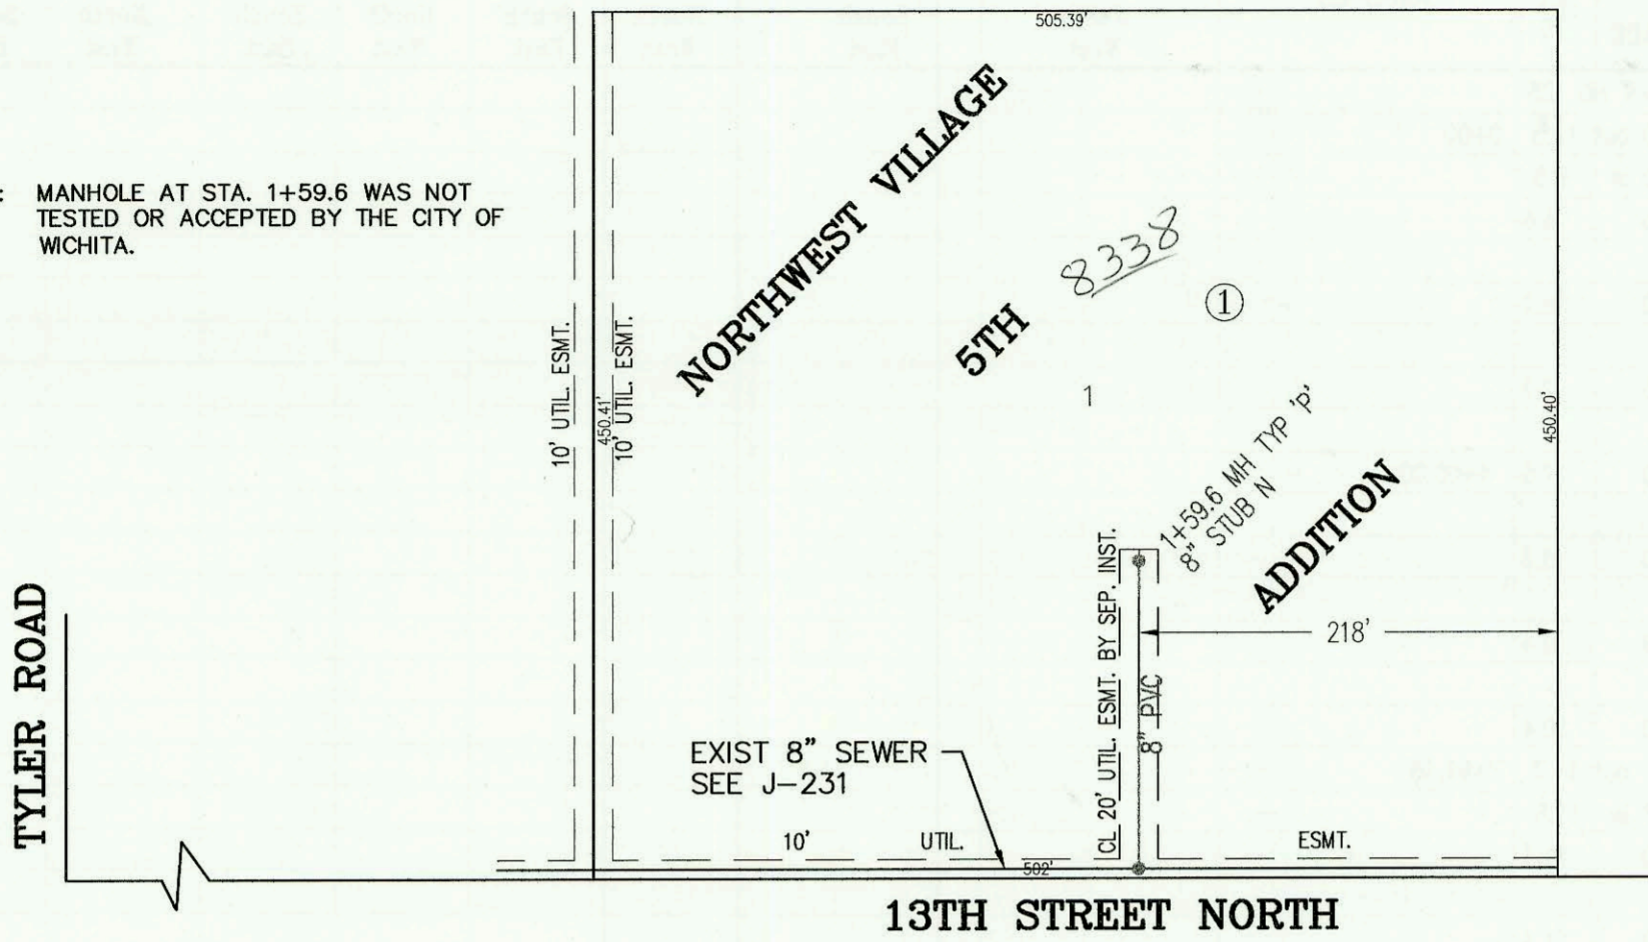

PRIVATE SANITARY SEWER RELOCATION FOR PEP BOYS, INC.
 PRIVATE PROJECT NO. 466PPS (607861)
 BUILT BY W. B. CARTER CONSTRUCTION CO.
 BOOKED 02/23/95 AS PER PLAN

TAFT STREET

