


MAIN I, COWSKIN INTERCEPTOR SEWER, PHASE II
PROJECT NO. 468-82001 (725028)
BUILT BY UTILITY CONTRACTORS, INC.
BOOKED 12-8-94 AS PER PLAN

N

SCALE: 1" = 150'

M/D

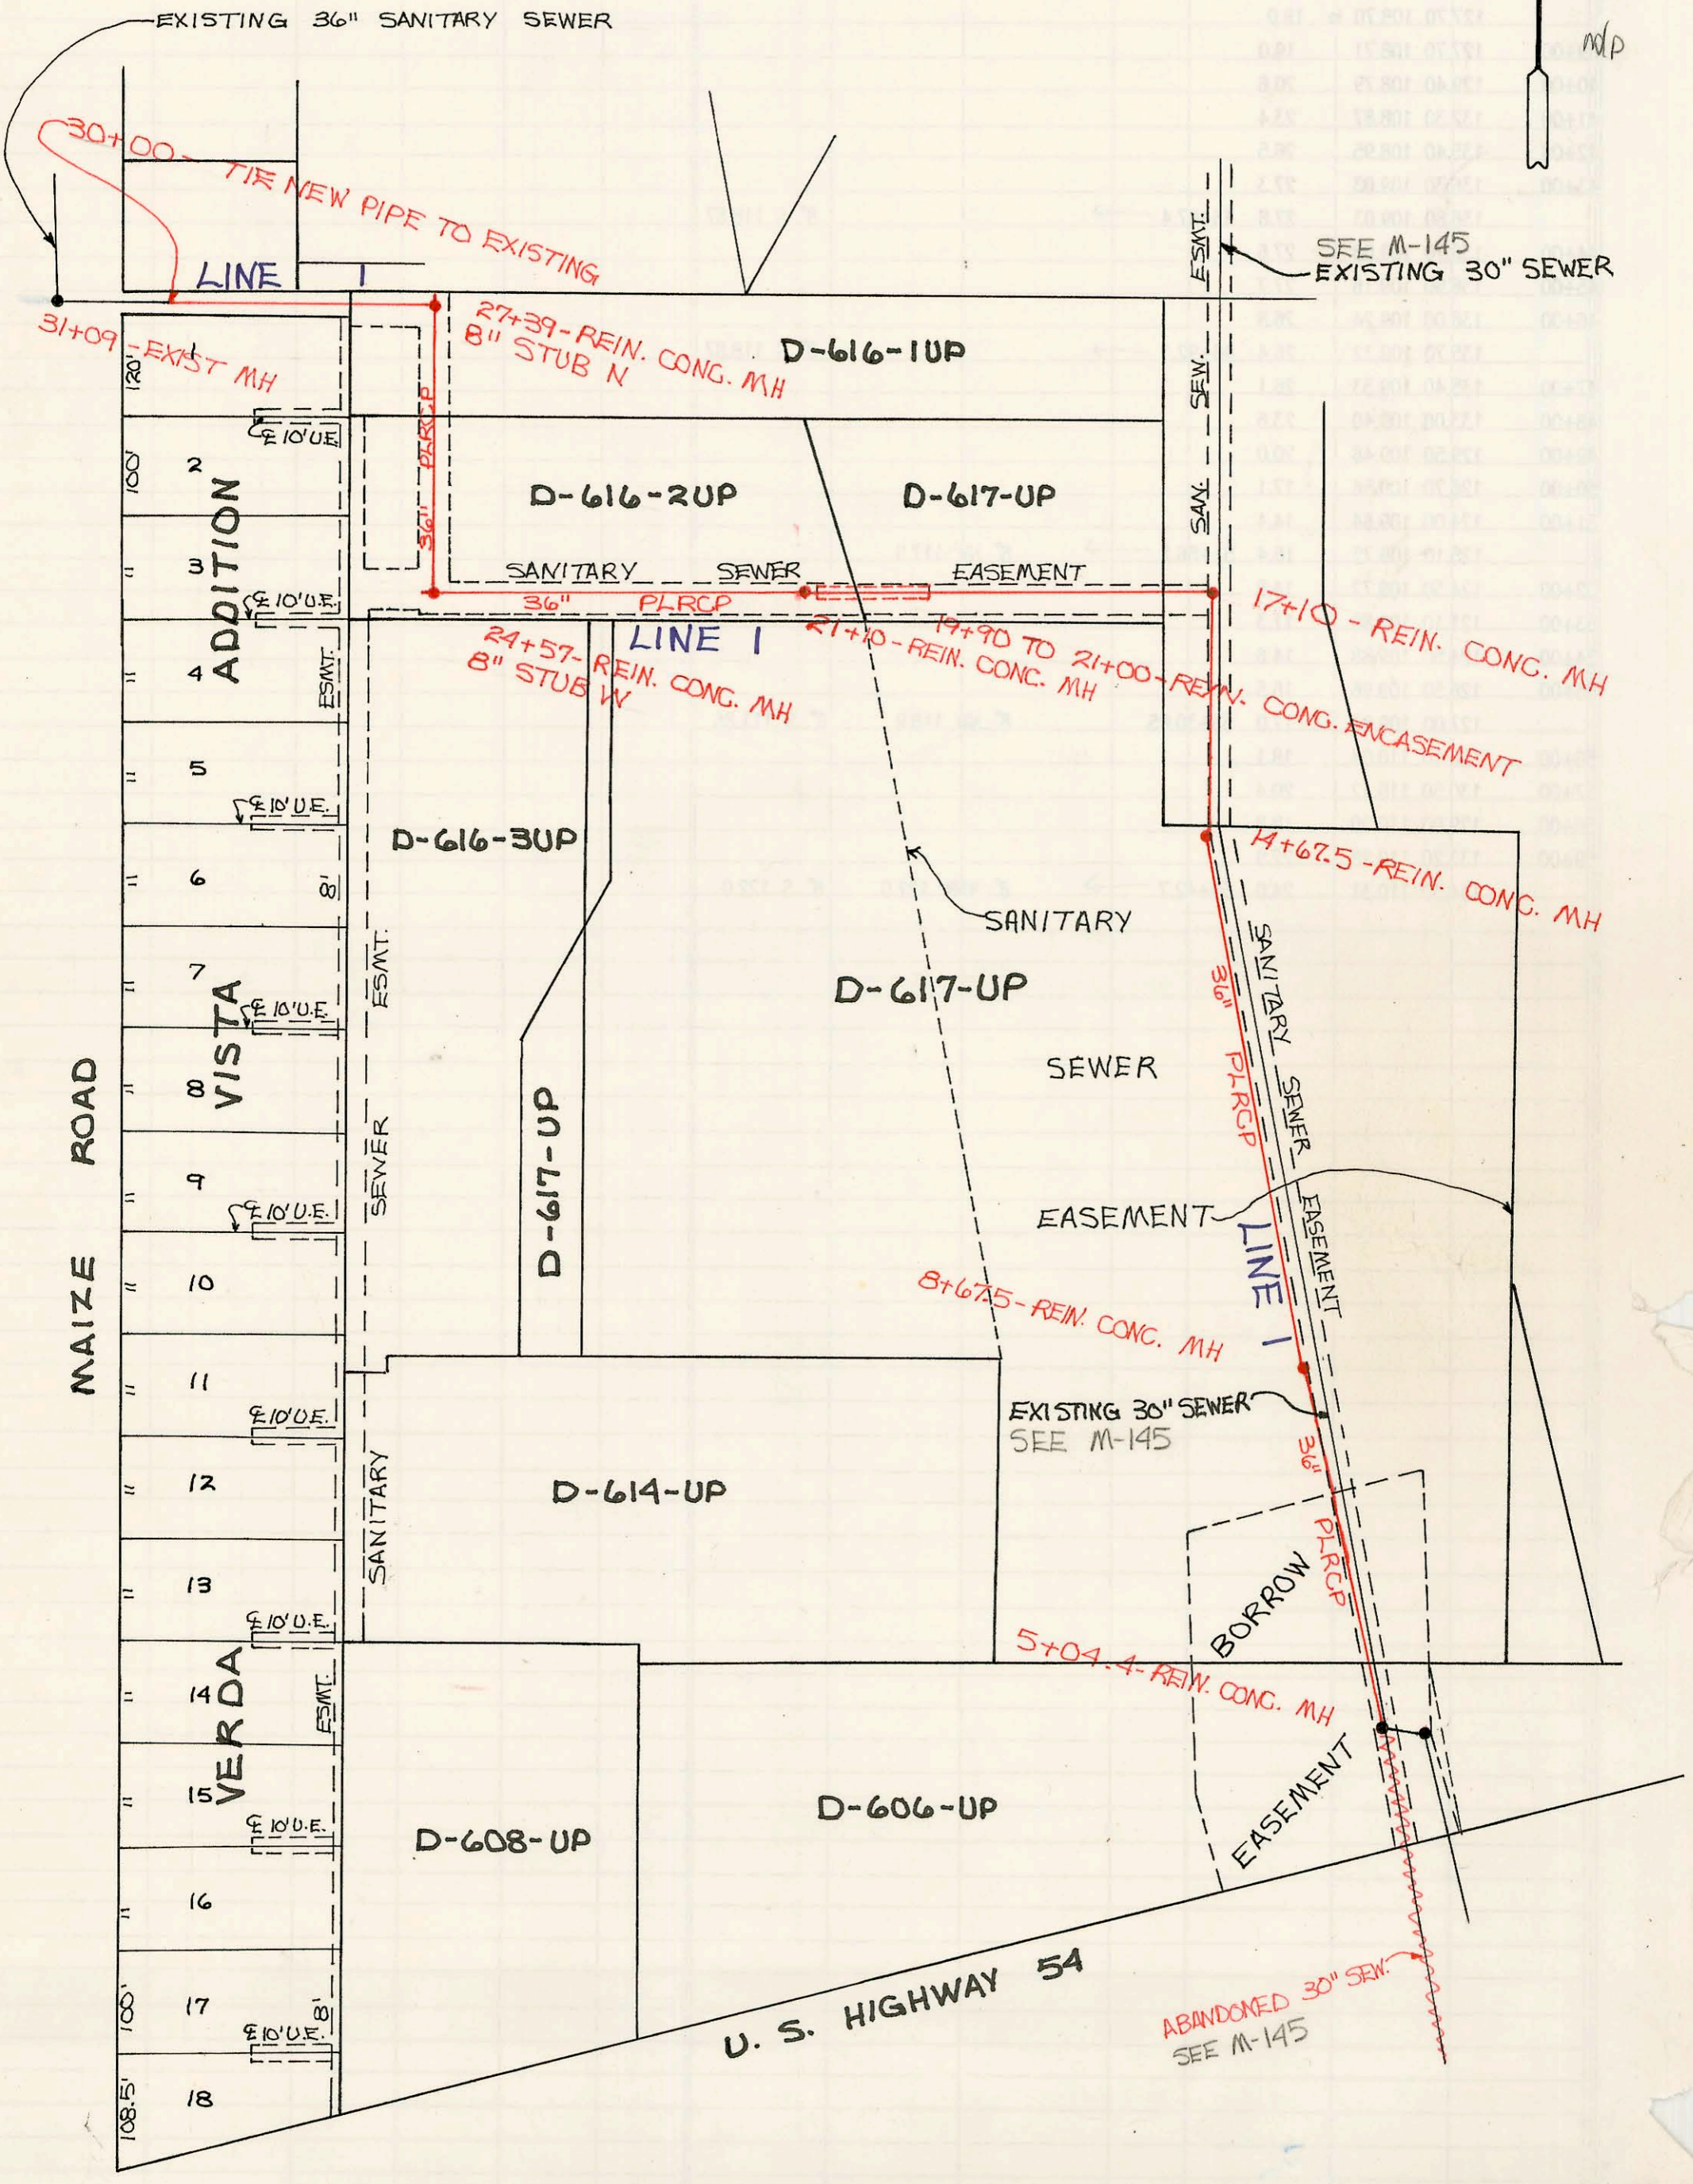

LINE 1

CONSTRUCTION RECORD						SERVICE RECORD						
STATION	ELEVATION		Depth	MANHOLE	4-INCH "Y" BRANCHES		No. of Permit		House Number		DATE OF PERMITS	
	Ground	Grade			North West	South East	North West	South East	North West	South East	North West	South East
Main 1, Cowskin Interceptor Sewer (Phase 2)												
5+04.4	118.40	103.72 OUT 105.22 IN		5+04.4								
6+00	117.50	105.30										
7+00	116.20	105.38										
8+00	117.20	105.46										
	118.60	105.51		8+67.5								
9+00	119.00	105.54										
10+00	120.30	105.62										
11+00	119.50	105.70										
12+00	118.70	105.78										
13+00	117.90	105.86										
14+00	119.80	105.94										
	123.50	105.99		14+67.5								
15+00	123.50	106.02										
16+00	124.20	106.10										
17+00	122.40	106.17										
	122.40	106.18		17+10								
18+00	118.90	106.25										
19+00	119.20	106.33										
20+00	118.90	106.41										
21+00	119.50	106.49										
	120.40	106.50		21+10								
22+00	122.30	106.57										
23+00	122.50	106.65										
24+00	124.00	106.73										
	125.40	106.77		24+57	8" Stub W							
25+00	126.80	106.81										
26+00	126.60	106.89										
27+00	126.20	106.97										
	126.30	107.00		27+39	8" Stub N							
28+00	127.20	107.05										
29+00	132.50	107.13										
30+00	136.40	107.21										
31+00	137.00	107.29										
	137.70	107.30		31+09								