


MAIN 1, COWSKIN INTERCEPTOR SEWER- PHASE III
PROJECT NO. 468-82001 (725028)
BUILT BY WILDCAT CONSTRUCTION CO.
BOOKED 01/26/95 AS PER PLAN



SCALE: 1" = 150'
m/p

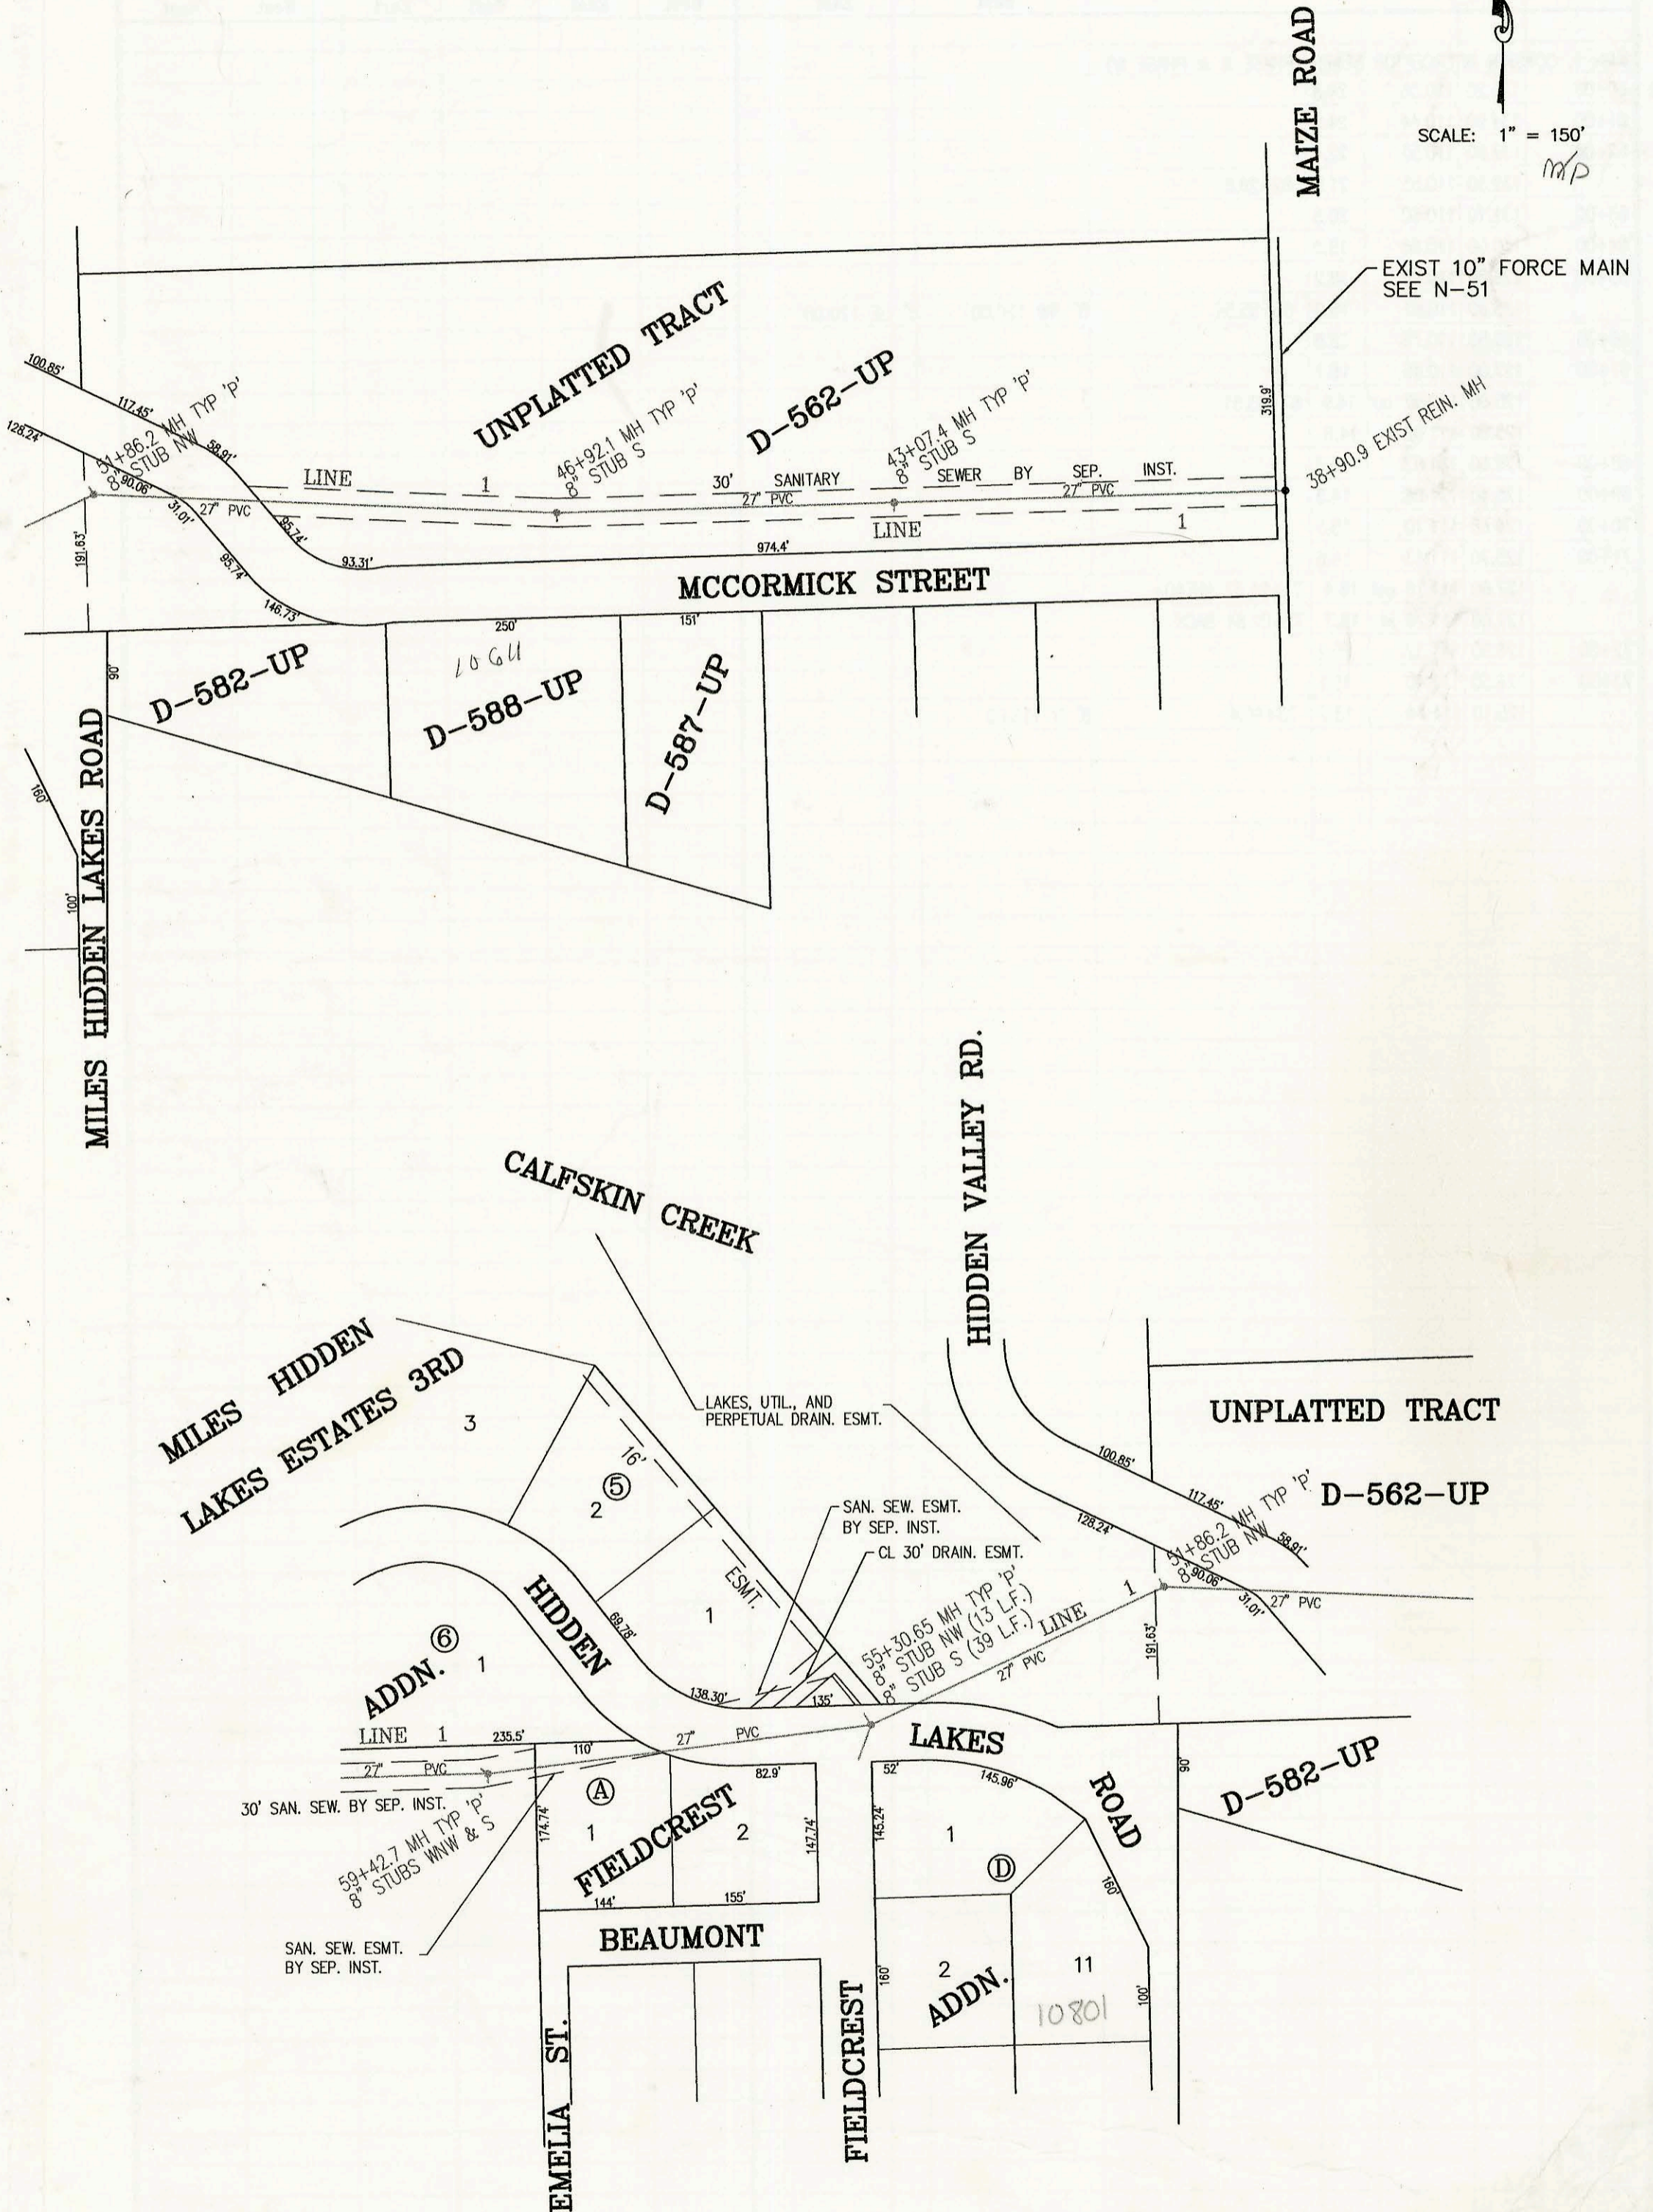

CONSTRUCTION RECORD							SERVICE RECORD					
STATION	ELEVATION		Depth	MANHOLE	4-INCH "Y" BRANCHES		No. of Permit		House Number		DATE OF PERMITS	
	Ground	Grade			North West	South East	North West	South East	North West	South East	North West	South East
MAIN 1, COWSKIN INTERCEPTOR SEWER (PHASE III)												
LINE 1 38+90.9	127.70	107.93	out 19.8	38+90.9	→							
	127.70	108.70	in 19.0									
39+00	127.70	108.71	19.0									
40+00	129.40	108.79	20.6									
41+00	132.30	108.87	23.4									
42+00	135.40	108.95	26.5									
43+00	136.30	109.03	27.3									
	136.80	109.03	27.8	43+07.4	→	8" S	118.87					
44+00	136.70	109.08	27.6									
45+00	136.90	109.16	27.7									
46+00	136.00	109.24	26.8									
	135.70	109.32	26.4	46+92.1	→	8" S	118.87					
47+00	135.40	109.33	26.1									
48+00	133.00	109.40	23.6									
49+00	129.50	109.48	20.0									
50+00	126.70	109.56	17.1									
51+00	124.00	109.64	14.4									
	125.10	109.72	15.4	51+86.2	→	8" NW	117.9					
52+00	124.50	109.72	14.8									
53+00	121.10	109.80	11.3									
54+00	124.50	109.88	14.6									
55+00	126.50	109.96	16.5									
	127.00	109.97	17.0	55+30.65		8" NW	118.9	8" S	111.86			
56+00	128.10	110.04	18.1									
57+00	130.50	110.12	20.4									
58+00	129.00	110.20	18.8									
59+00	133.20	110.28	22.9									
	134.30	110.31	24.0	59+42.7	→	8" WNW	122.0	8" S	122.0			