
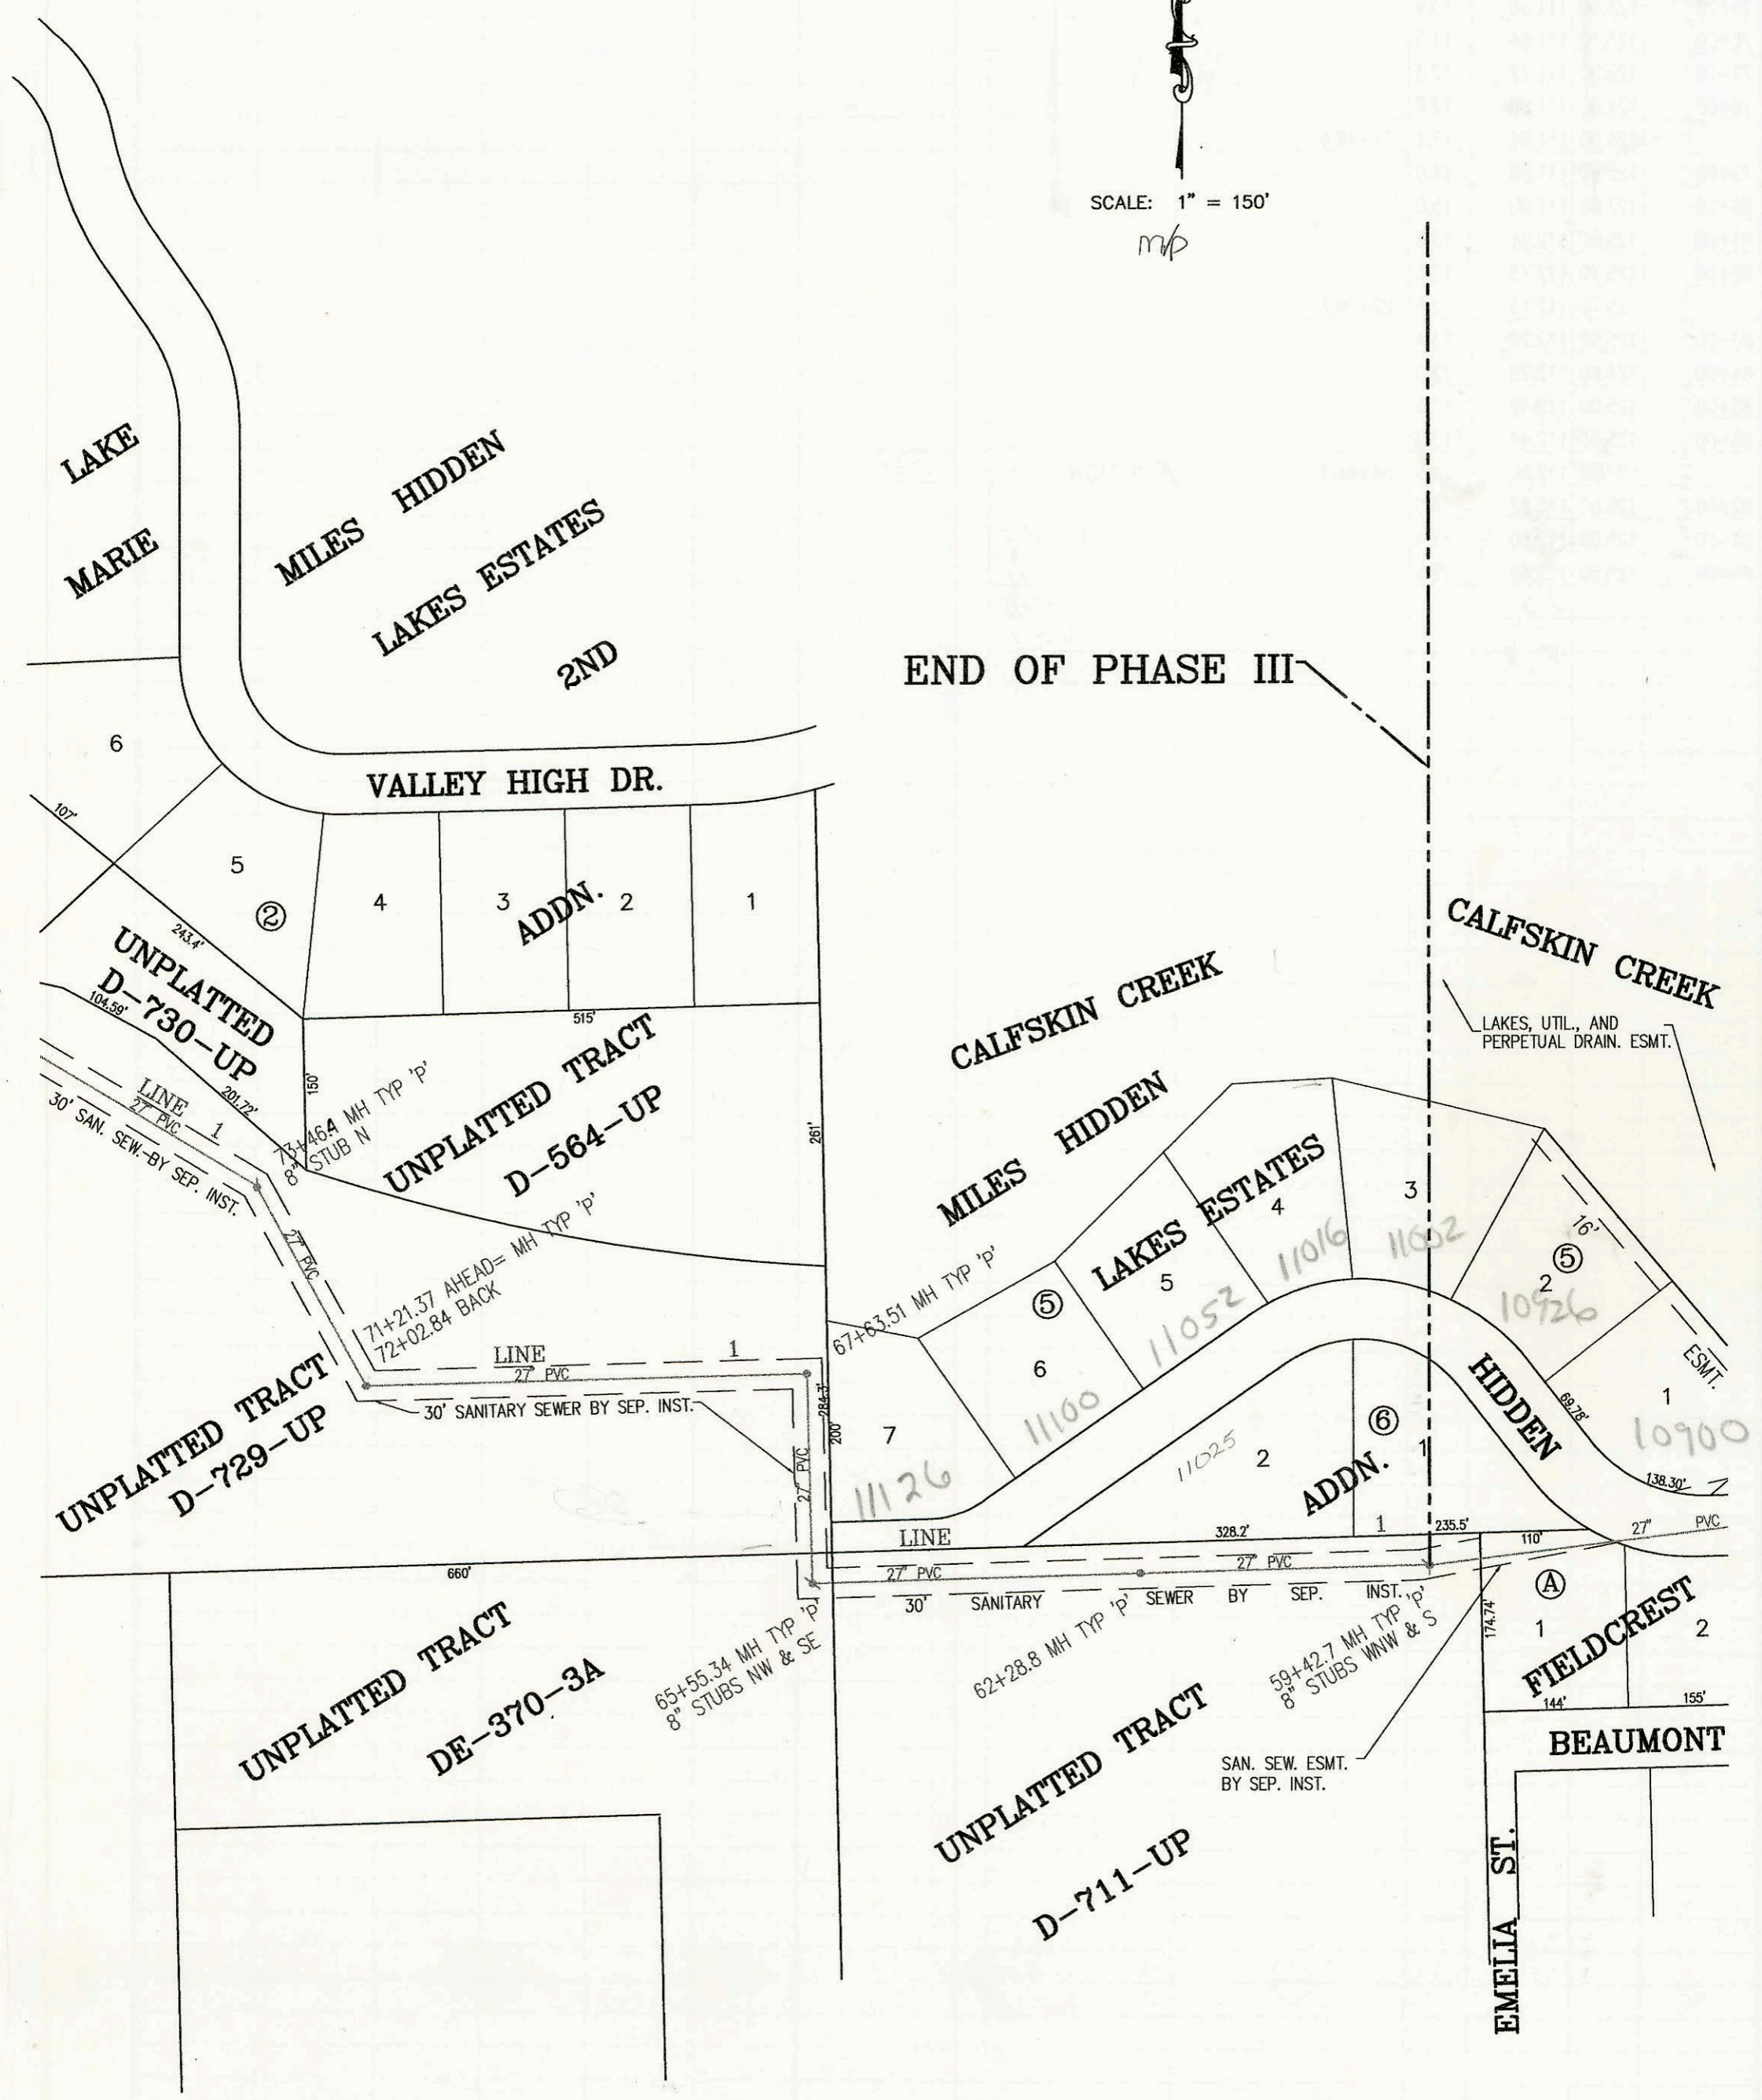


MAIN 1, COWSKIN INTERCEPTOR SEWER- PHASE IV
PROJECT NO. 468-82001 (725028)
BUILT BY WILDCAT CONSTRUCTION CO.
BOOKED 02/28/95 AS PER PLAN

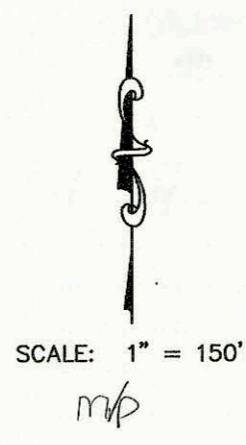

CONSTRUCTION RECORD						SERVICE RECORD						
STATION	ELEVATION		DEPTH	MANHOLE	4-INCH "Y" BRANCHES		No. of Permit		House Number		DATE OF PERMITS	
	GROUND	GRADE			North West	South East	North West	South East	North West	South East	North West	South East
MAIN 1, COWSKIN INTERCEPTOR SEWER (PHASE III & PHASE IV)												
60+00	135.20	110.36	24.8									
61+00	134.90	110.44	24.5									
62+00	132.90	110.52	22.4									
	132.50	110.55	21.9	62+28.8								
63+00	131.10	110.60	20.5									
64+00	130.00	110.68	19.3									
65+00	129.00	110.76	18.2									
	125.80	110.81	15.0	65+55.34	8" NW 120.00	8" SE 120.00						
66+00	129.50	110.75	18.8									
67+00	127.00	110.86	16.1									
	125.80	110.92 out	14.9	67+63.51								
	125.80	111.02 in	14.8									
68+00	126.60	111.03	15.6									
69+00	125.40	111.06	14.3									
70+00	126.60	111.10	15.5									
71+00	125.70	111.13	14.6									
	127.60	111.16 out	16.4	71+21.37 AHEAD=								
	127.60	111.26 in	16.3	72+02.84 BACK								
72+00	126.50	111.32	15.2									
73+00	126.50	111.40	15.1									
	125.10	111.44	13.7	73+46.4	8" N 115.00							

LINE 1