


MAIN 1, COWSKIN INTERCEPTOR SEWER- PHASE IV  
PROJECT NO. 468-82001 (725028)  
BUILT BY WILDCAT CONSTRUCTION CO.  
BOOKED 01/26/95 AS PER PLAN

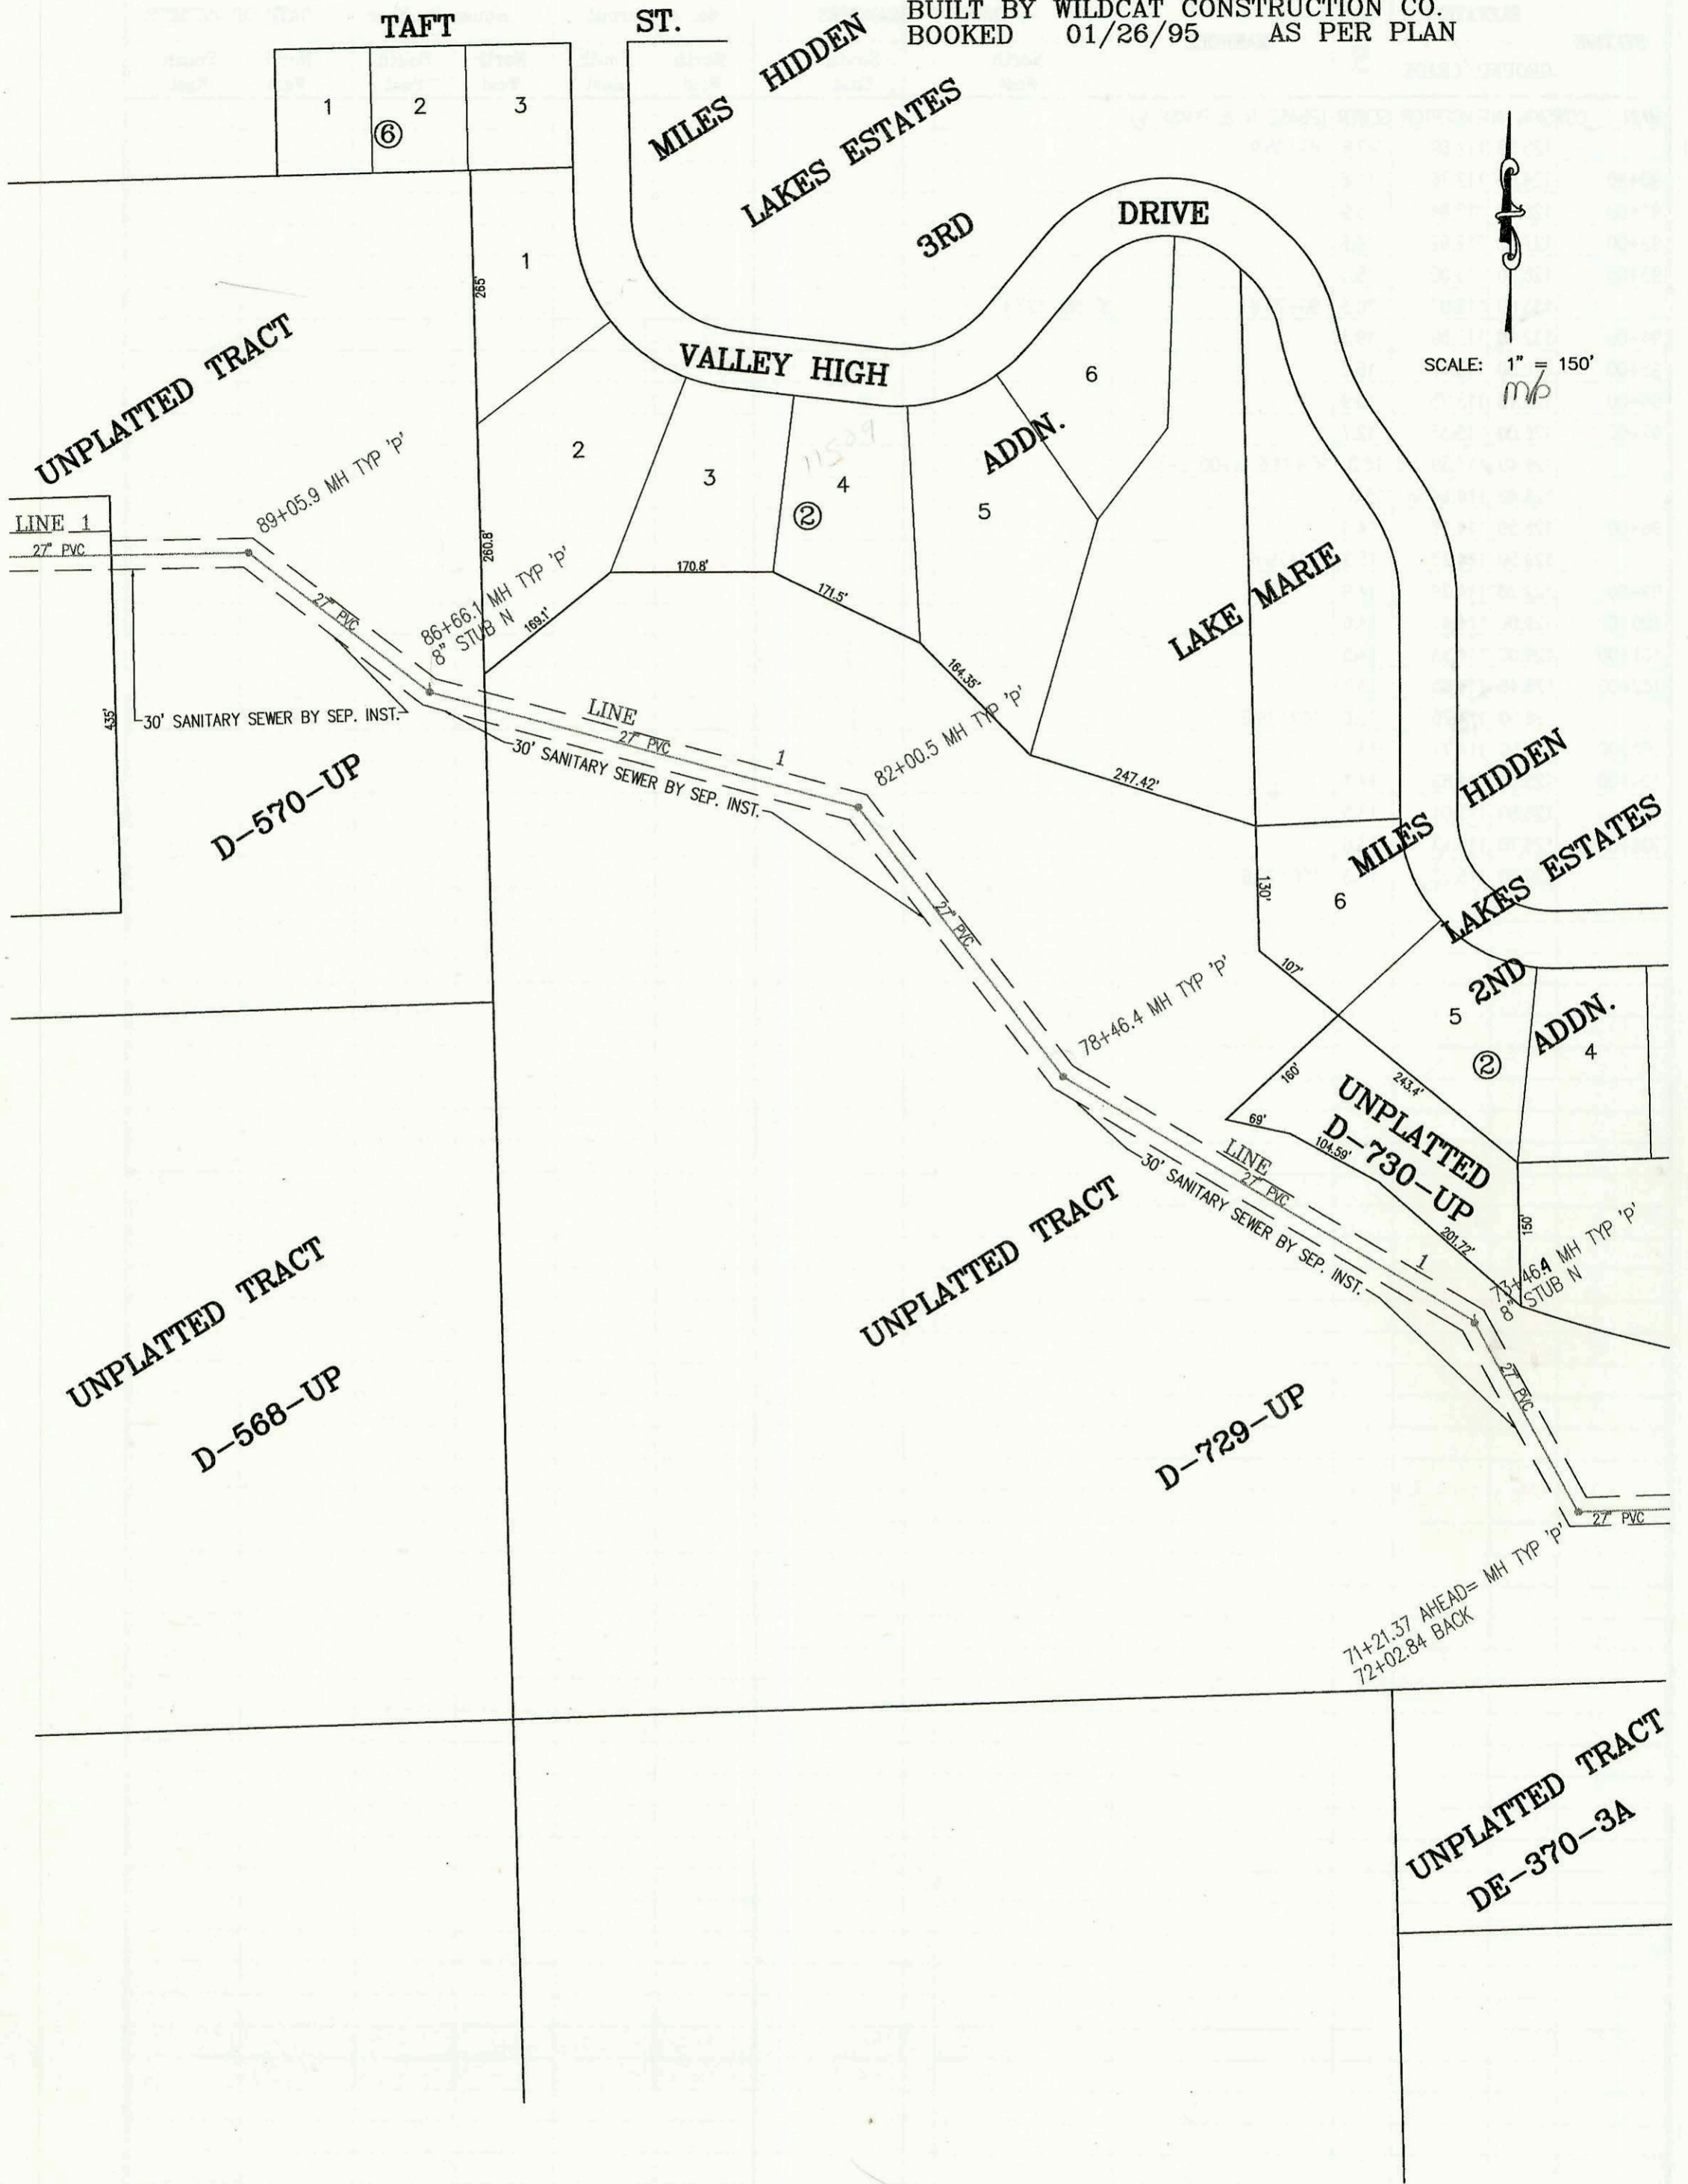

SCALE: 1" = 150'  
mb

TAFT		
1	2	3
	⑥	

262-8808  
Hidden

