


MAIN 1, COWSKIN INTERCEPTOR SEWER- PHASE V
PROJECT NO. 468-82001 (725028)
BUILT BY UTILITY CONSTRUCTION CO.
BOOKED 03/06/95 AS PER PLAN



SCALE: 1" = 150'
MJP

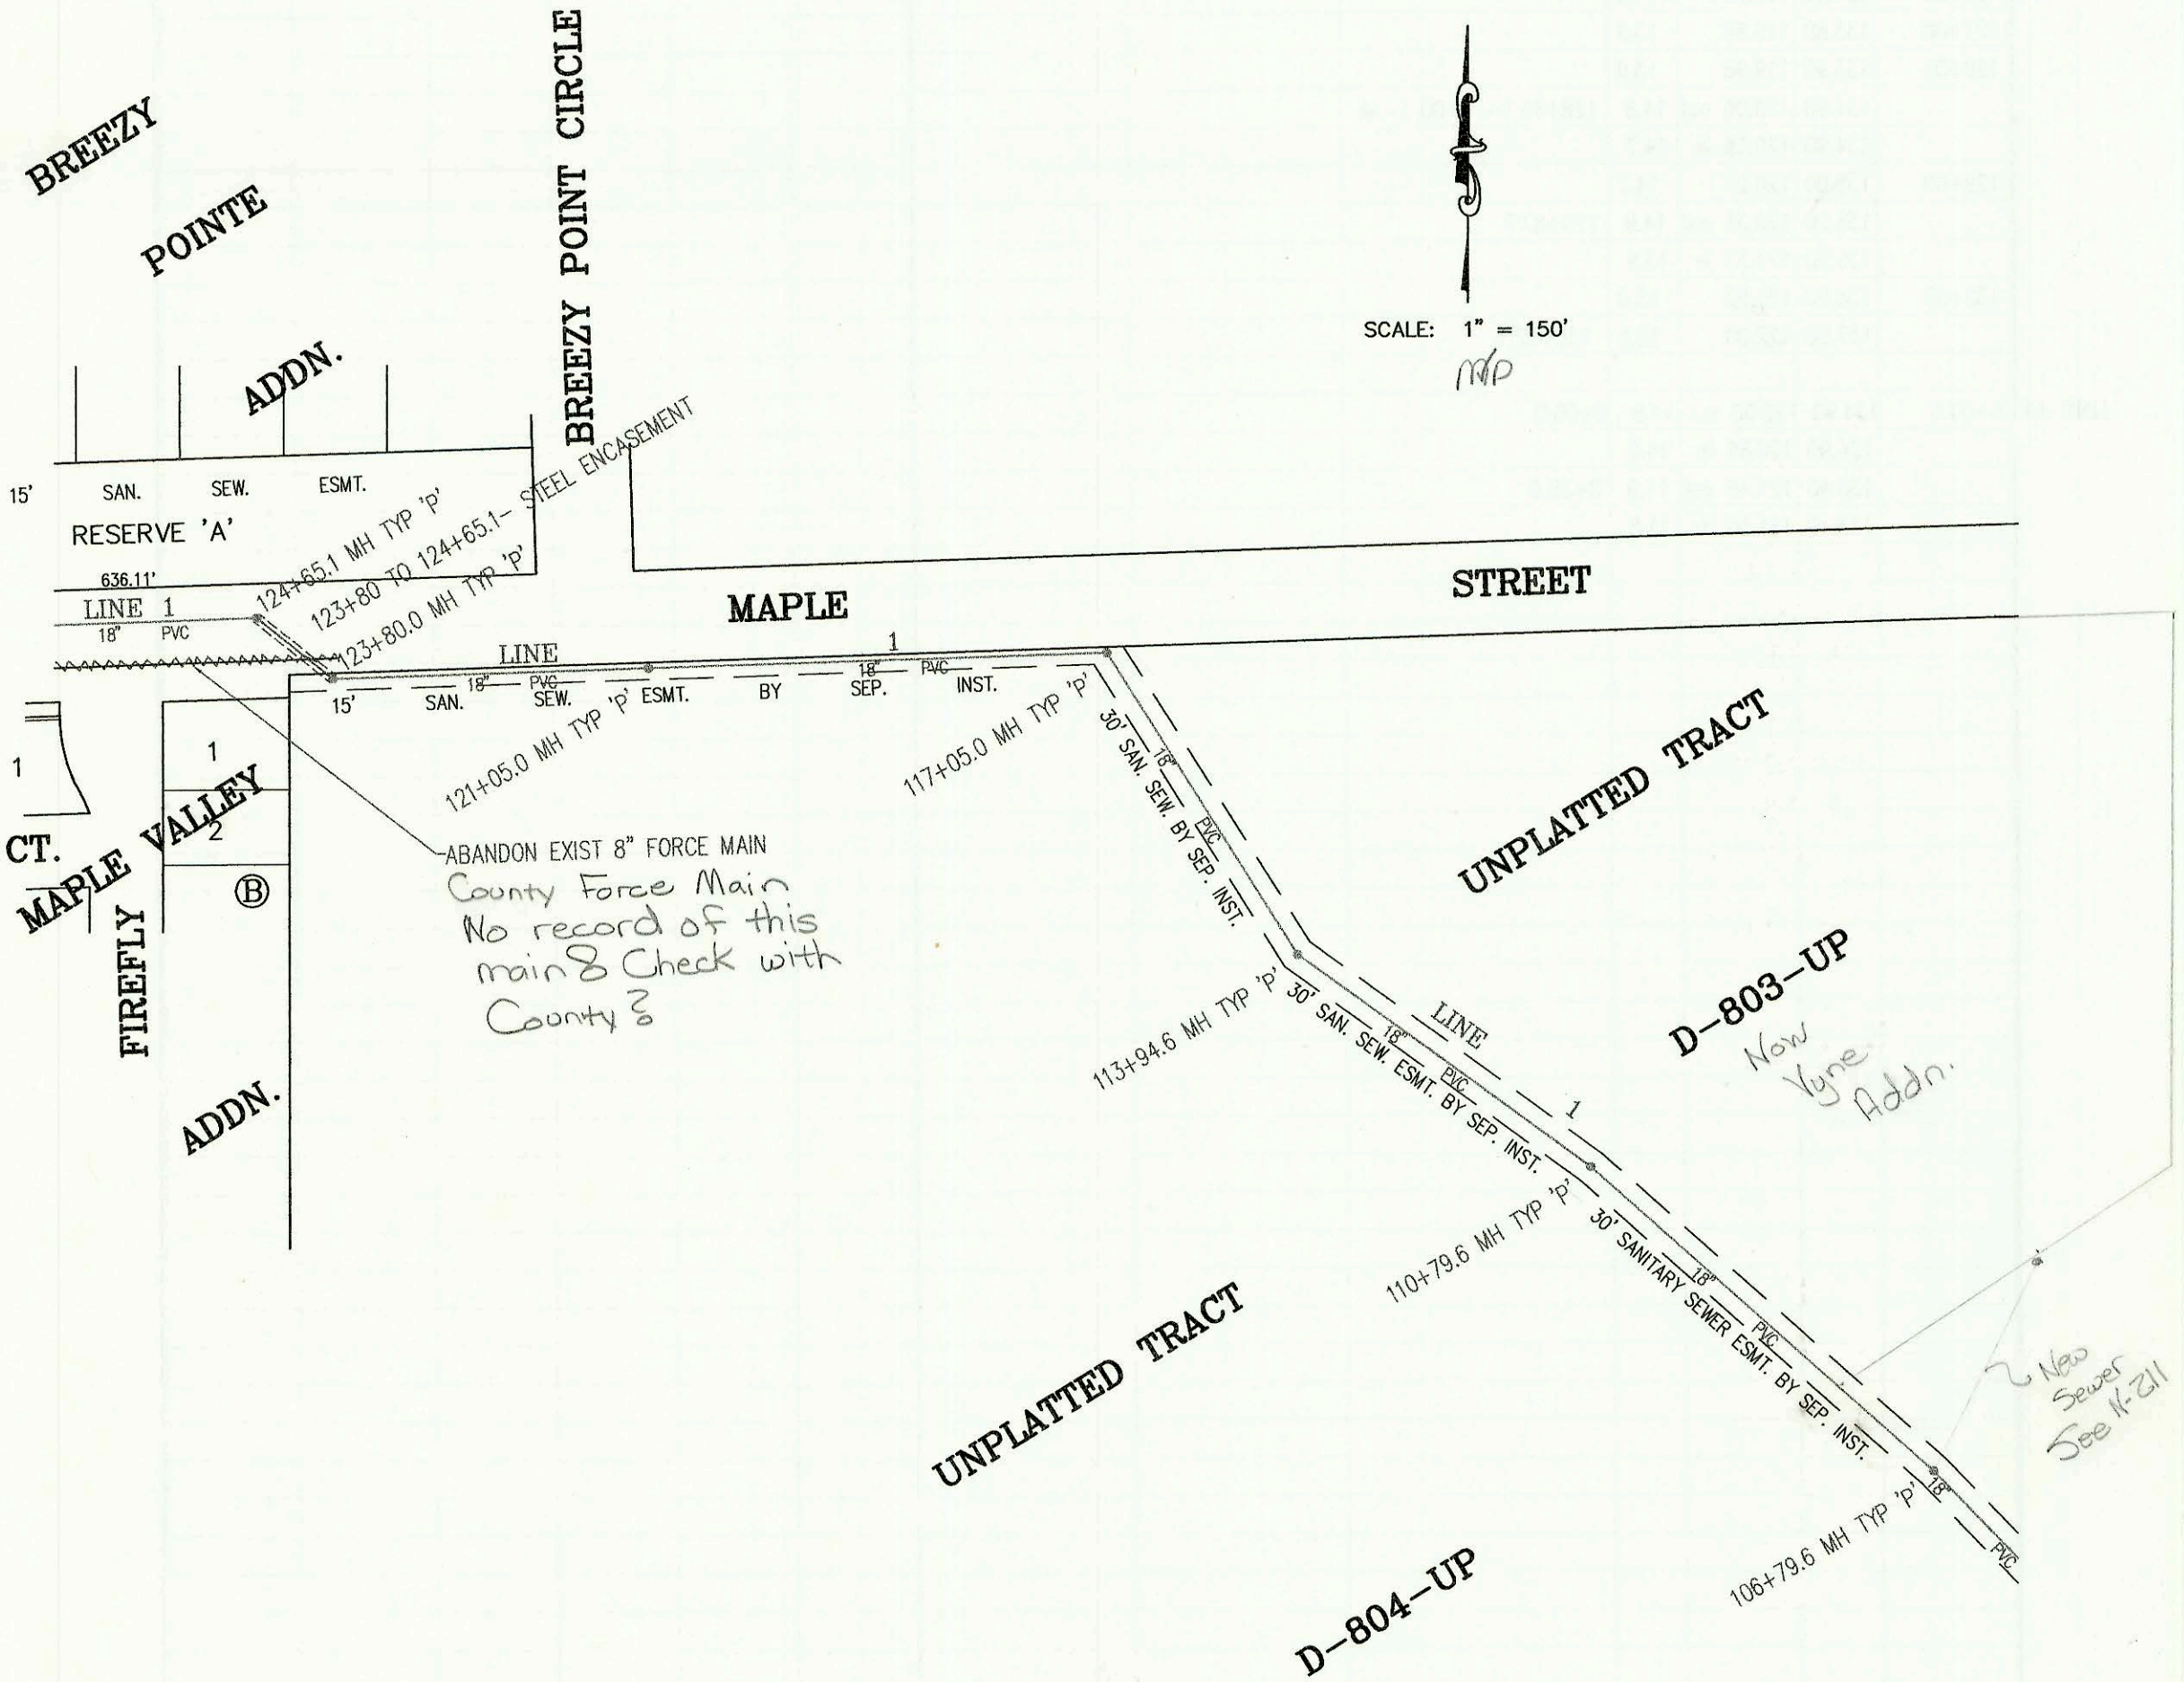