


MAIN 1, COWSKIN INTERCEPTOR SEWER- PHASE V
PROJECT NO. 468-82001 (725028)
BUILT BY UTILITY CONSTRUCTION CO.
BOOKED 03/06/95 AS PER PLAN

SCALE: 1" = 150'
m/p

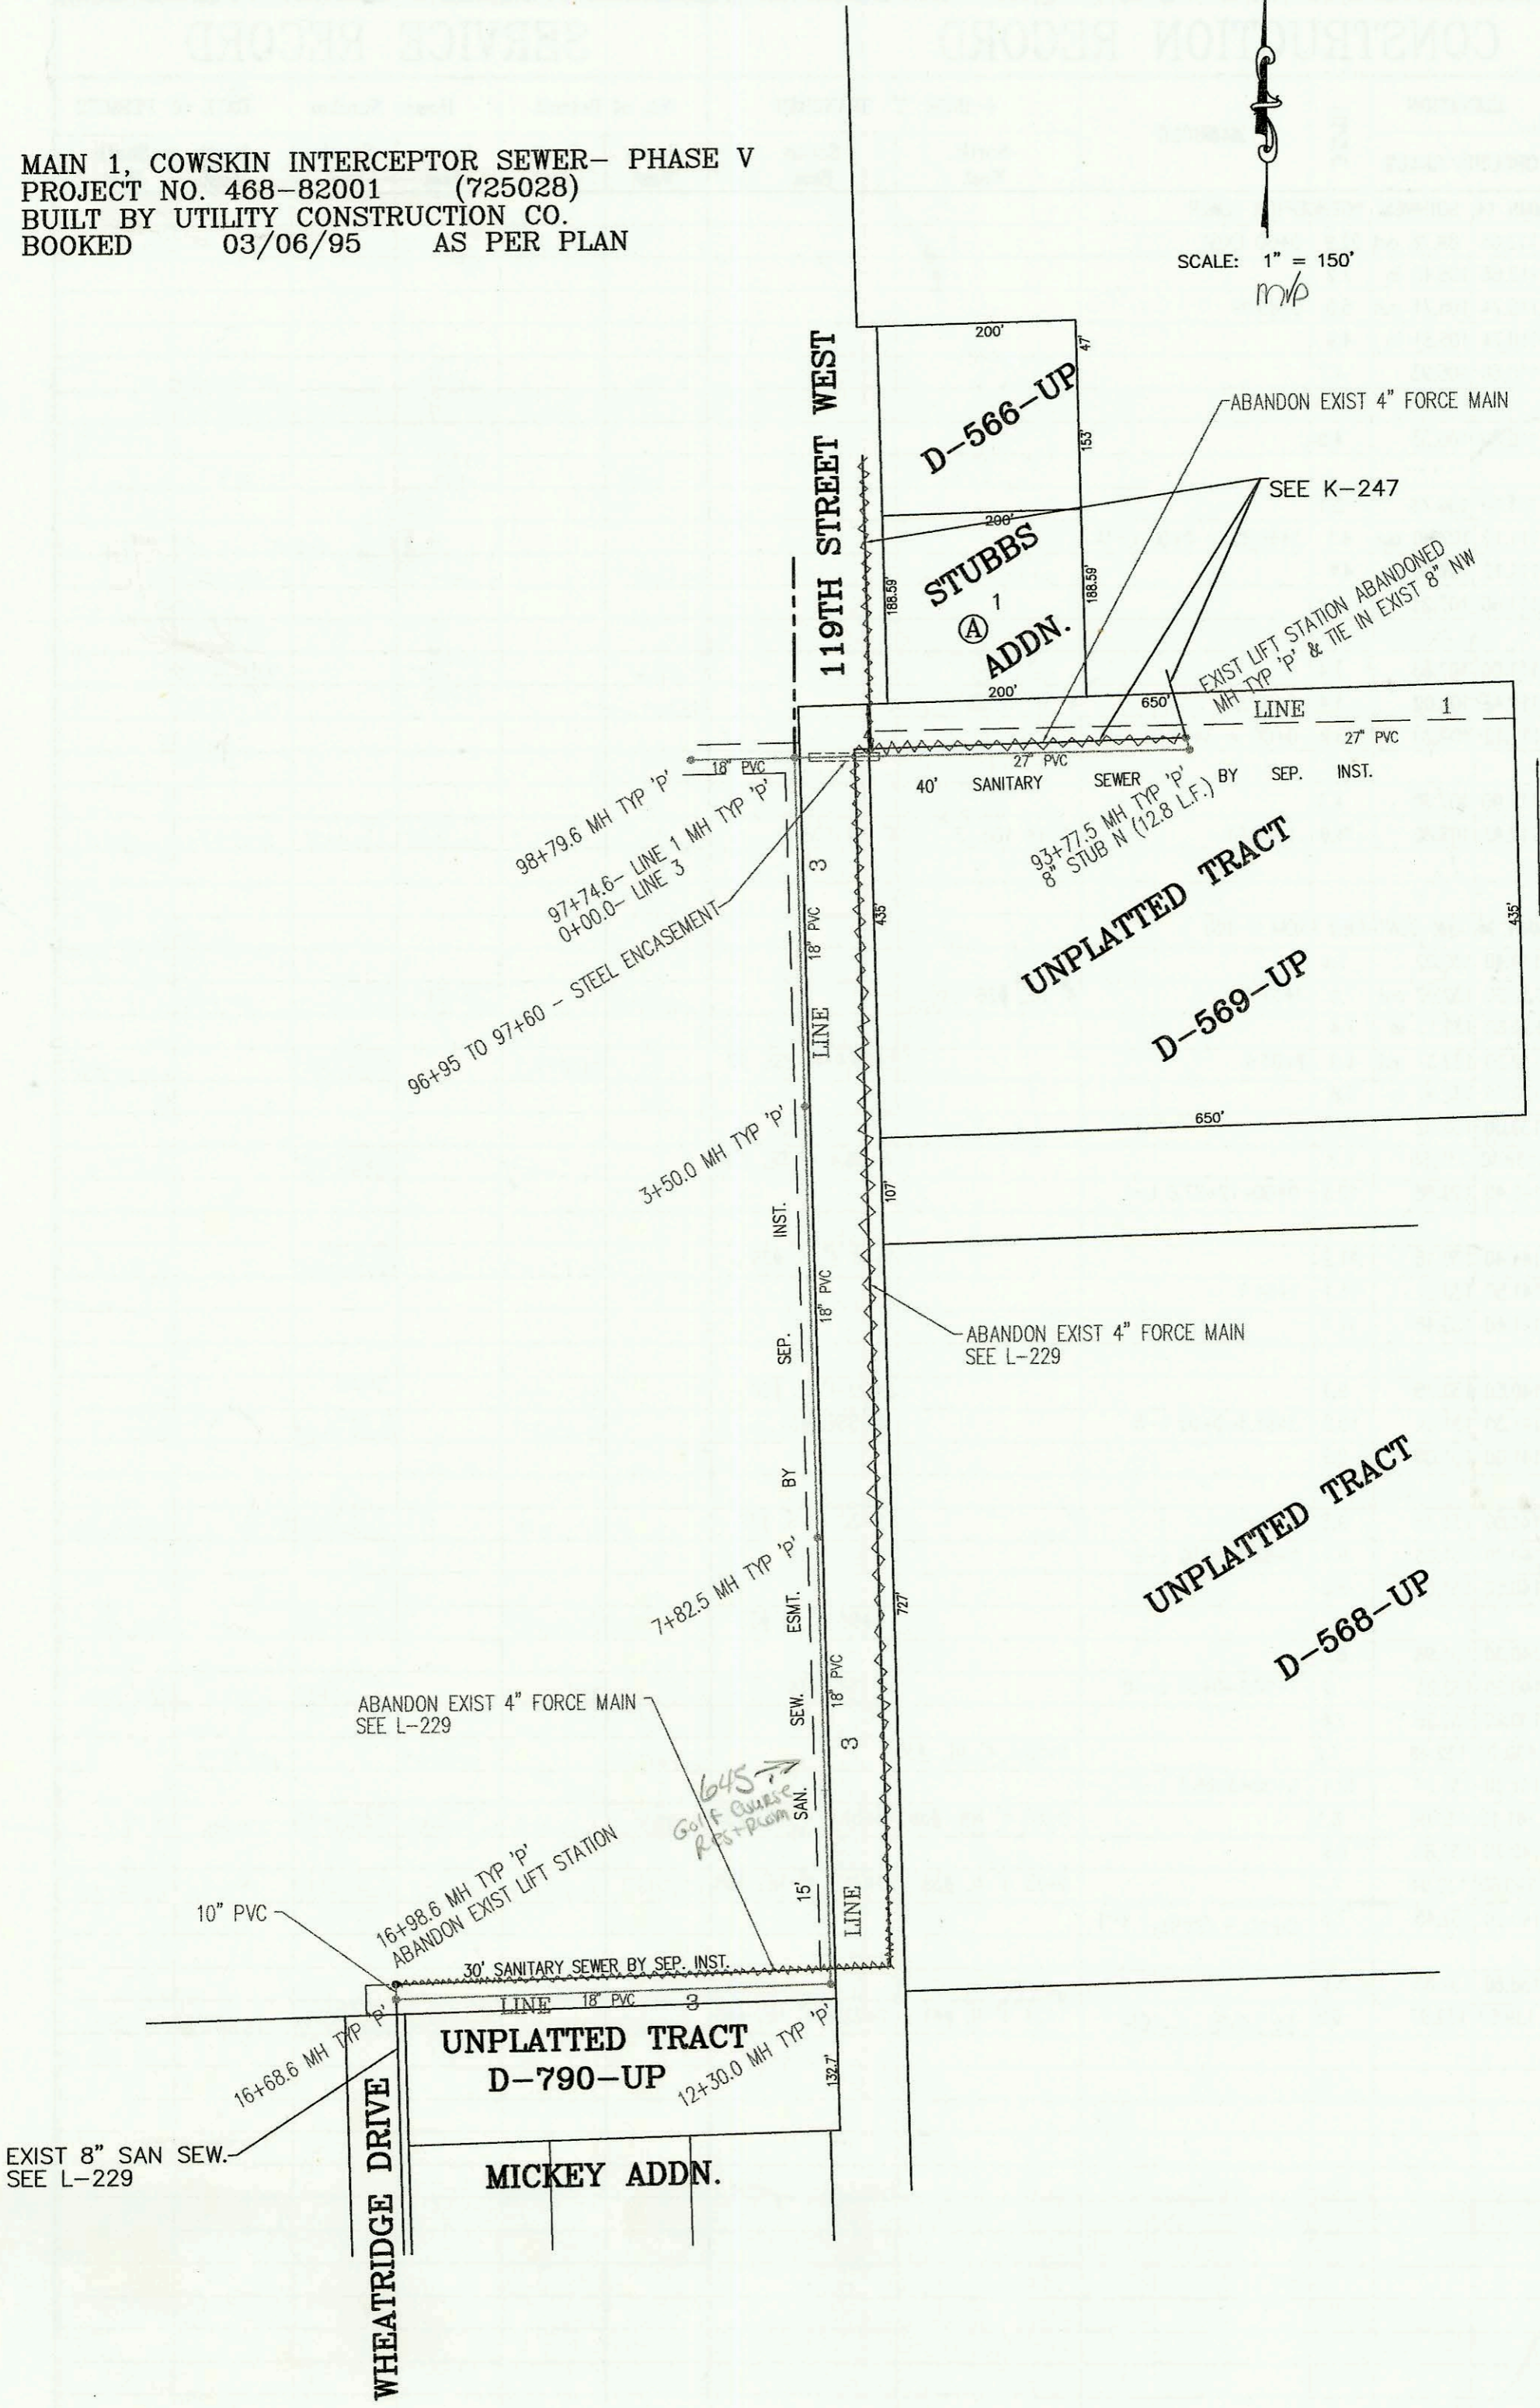

CONSTRUCTION RECORD					SERVICE RECORD							
STATION	ELEVATION		DEPTH	MANHOLE	4-INCH "Y" BRANCHES		No. of Permit		House Number		DATE OF PERMITS	
	GROUND	GRADE			North West	South East	North West	South East	North West	South East	North West	South East
LINE 3	MAIN 1, COWSKIN INTERCEPTOR SEWER (PHASE V)											
	0+00.0	129.40	113.39 out	16.0	0+00= 97+74.6 L-1							
		129.40	114.14 in	15.3								
	1+00	129.40	114.26	15.1								
	2+00	129.20	114.38	14.8								
	3+00	127.00	114.50	12.5								
		129.00	114.56	14.4	3+50.0							
	4+00	125.50	114.62	10.9								
	5+00	127.90	114.74	13.2								
	6+00	128.20	114.86	13.3								
	7+00	128.40	114.98	13.4								
		128.90	115.08	13.8	7+82.5							
	8+00	128.20	115.10	13.1								
	9+00	128.30	115.22	13.1								
	10+00	128.00	115.34	12.7								
					4" SCH 40 DL 10+34 TAP		2001- 00167		645 S. 114th St W		1-24-01	
11+00	128.50	115.46	13.0									
12+00	128.50	115.88	12.6									
	129.10	115.62	13.5	12+30.0								
13+00	127.50	115.70	11.8									
14+00	127.60	115.82	11.8									
15+00	128.40	115.94	12.5									
16+00	128.30	116.06	12.2									
	127.50	116.14 out	11.4	16+68.6								
	127.50	116.55 in	10.9									
	125.90	116.61	9.3	16+98.6								