


LATERAL 57, MAIN 22, WAR INDUSTRIES SEWER  
PROJECT NO. 468-82052 (742296)  
BUILT BY NOWAK CONSTRUCTION CO.  
BOOKED 8/15/95 PER PLAN



SCALE: 1" = 100'

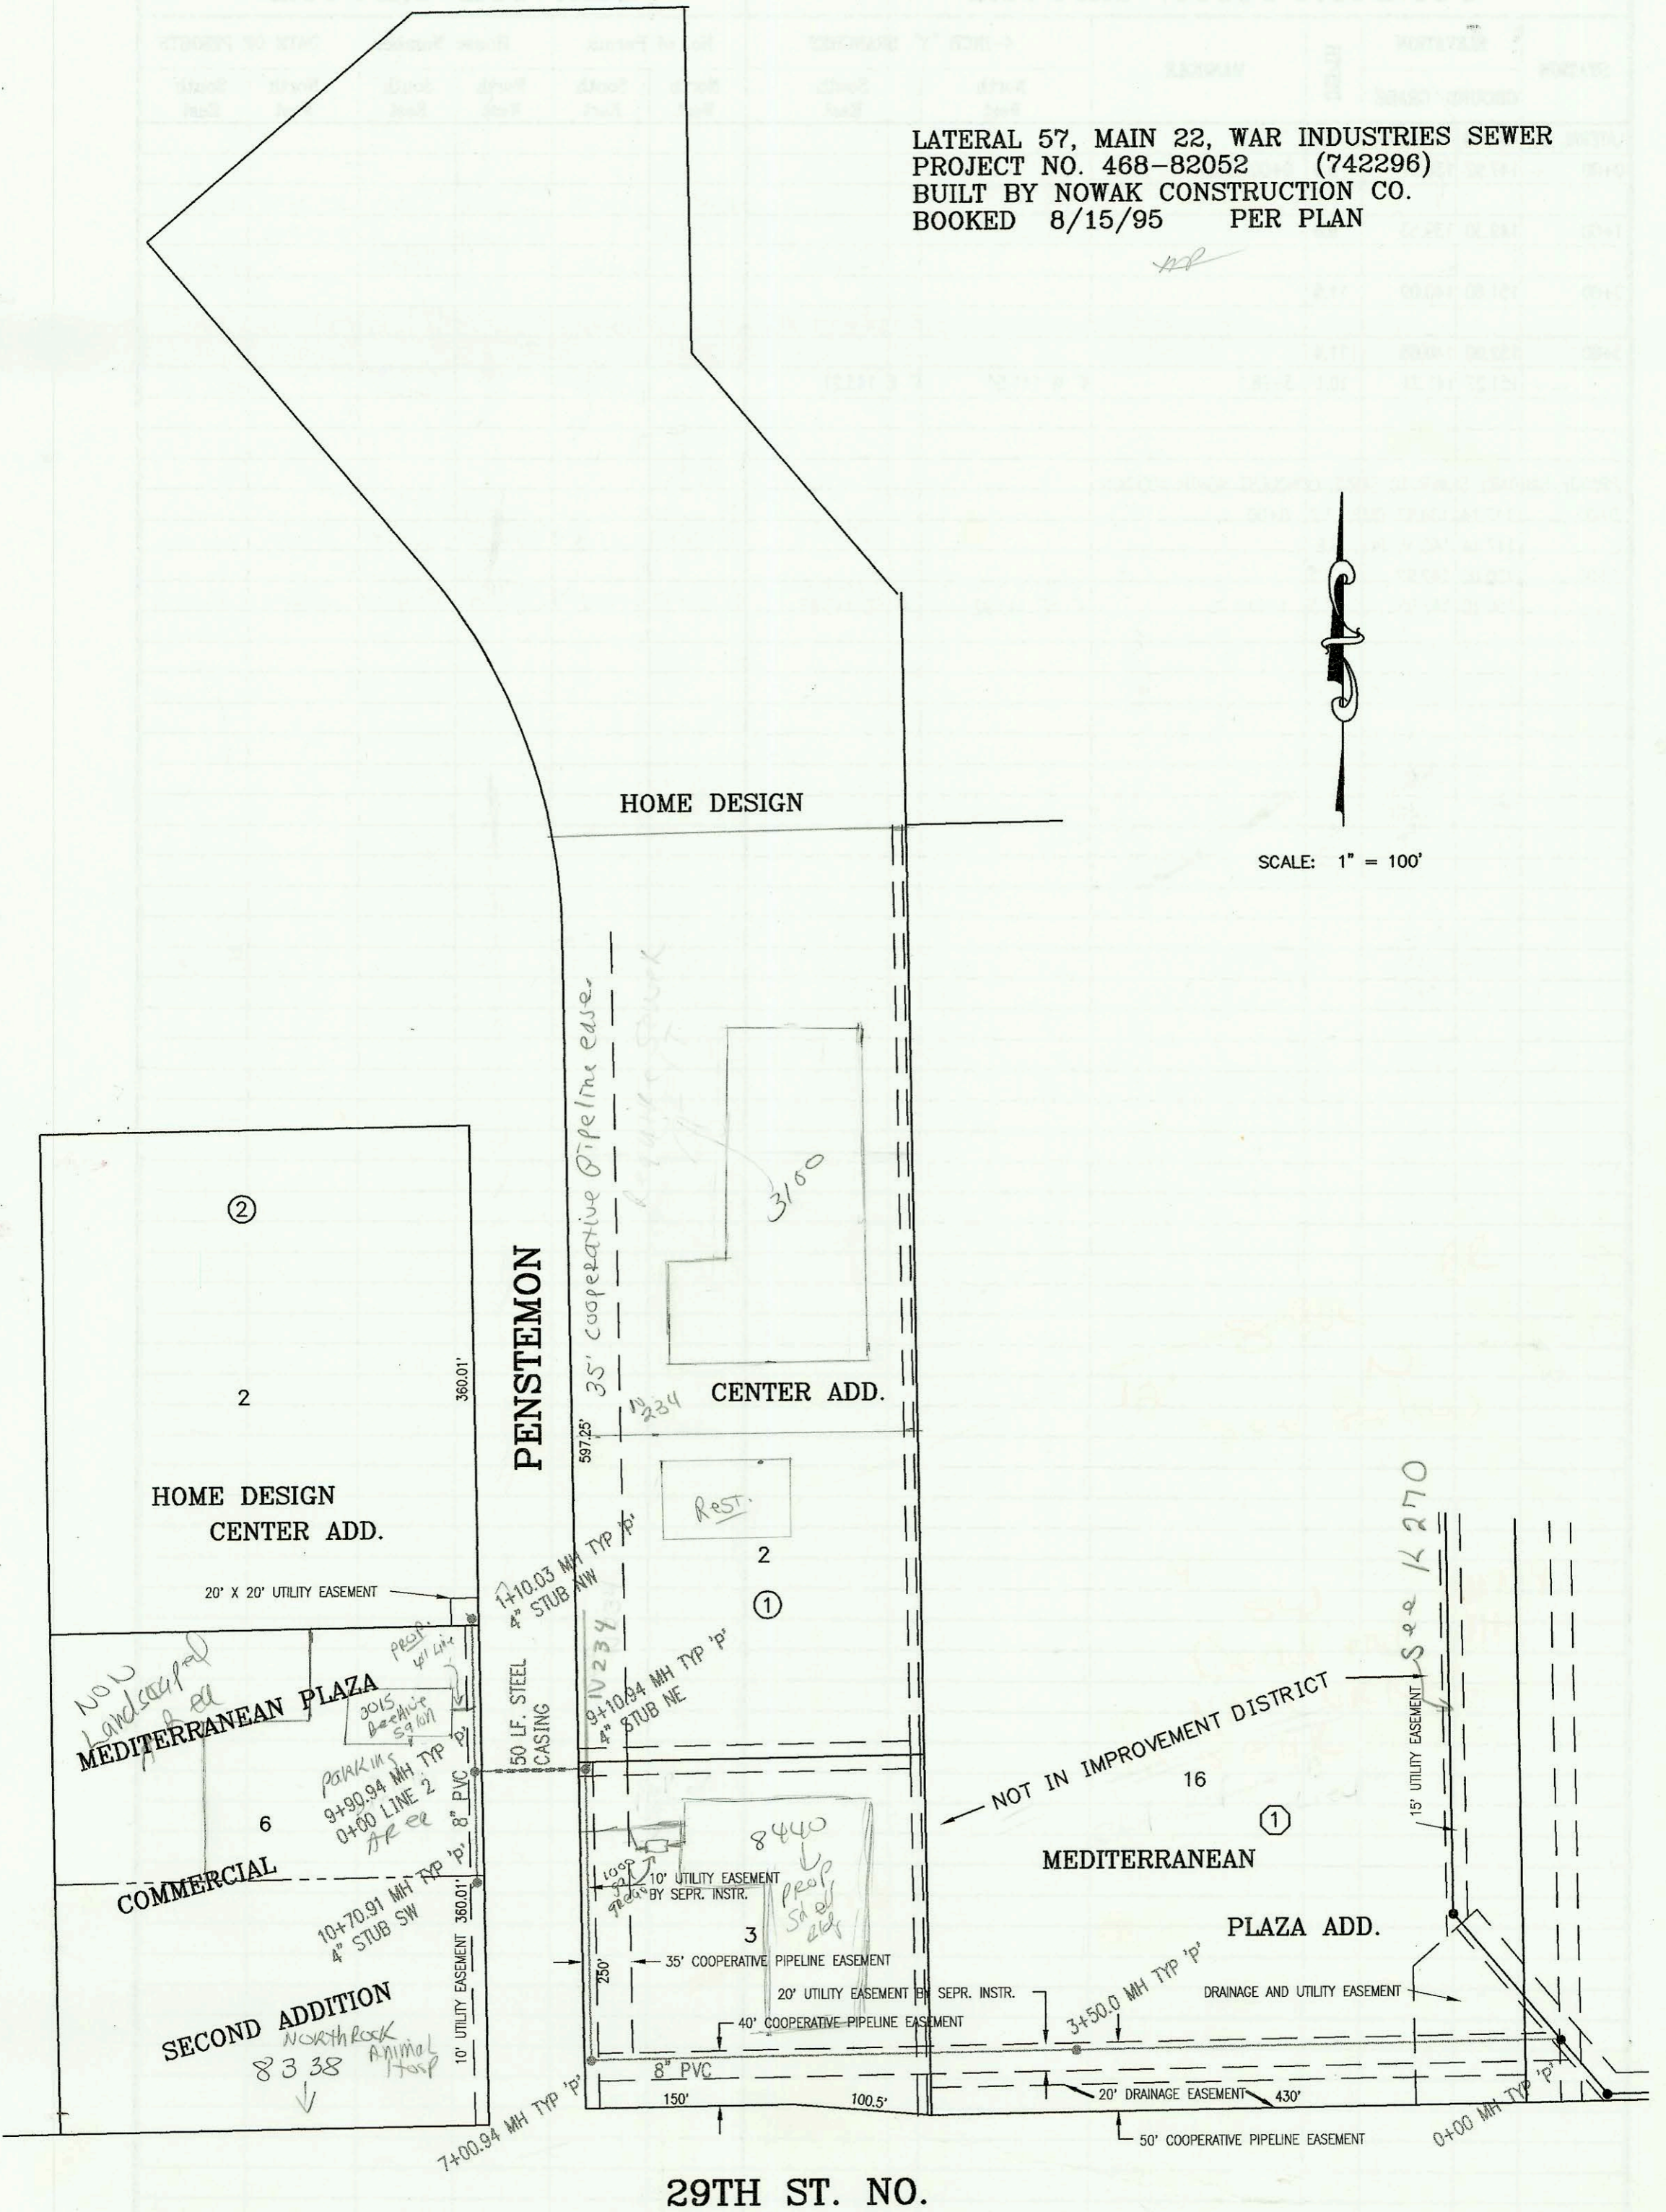

29TH ST. NO.

CONSTRUCTION RECORD						SERVICE RECORD						
STATION	ELEVATION		DEPTH	MANHOLE	4-INCH "Y" BRANCHES		No. of Permit		House Number		DATE OF PERMITS	
	GROUND	GRADE			North West	South East	North West	South East	North West	South East	North West	South East
LATERAL 57, MAIN 22, WAR INDUSTRIES SEWER												
0+00 L-1A	215.50	202.44 out	13.1	0+00								
	215.20	202.94 in	12.3									
1+00	215.00	204.19	10.8									
2+00	217.00	205.44	11.6									
3+00	217.60	206.70	10.9									
	219.25	207.33 out	11.9	3+50.0								
	219.25	207.43 in	11.8									
4+00	219.60	207.73	11.9									
5+00	221.20	208.33	12.9									
6+00	222.50	208.93	13.6									
7+00												
	222.66	209.54 out	13.1	7+00.94								
	222.66	209.64 in	13.0									
8+00	223.20	210.23	13.0									
9+00	223.50	210.83	12.7									
	224.01	210.90 out	13.1	9+70.94	4" NE 211.33							
	224.01	211.00 in	13.0									
	224.27	211.48 out	12.8	9+90.94 = 0+00 L-2								
	224.27	211.58 in	12.7									
10+00	223.80	211.67	12.1									
	224.36	212.38	12.0	10+70.91	4" SW 212.71							
0+00 L-2	224.27	211.58	12.7	0+00 = 9+90.94 L-1								
1+00	223.70	212.18	11.5									
	224.15	212.24	11.9	1+10.03	4" NW 212.77							

4" SW 212.71

35-7099-7

8338  
E 29th N

5-16-95