


MAIN 16, SOUTHWEST INTERCEPTOR SEWER  
PROJECT NO. 468-82235 (741629)  
BUILT BY WILDCAT CONSTRUCTION CO.  
BOOKED 09/11/95 AS PER PLAN

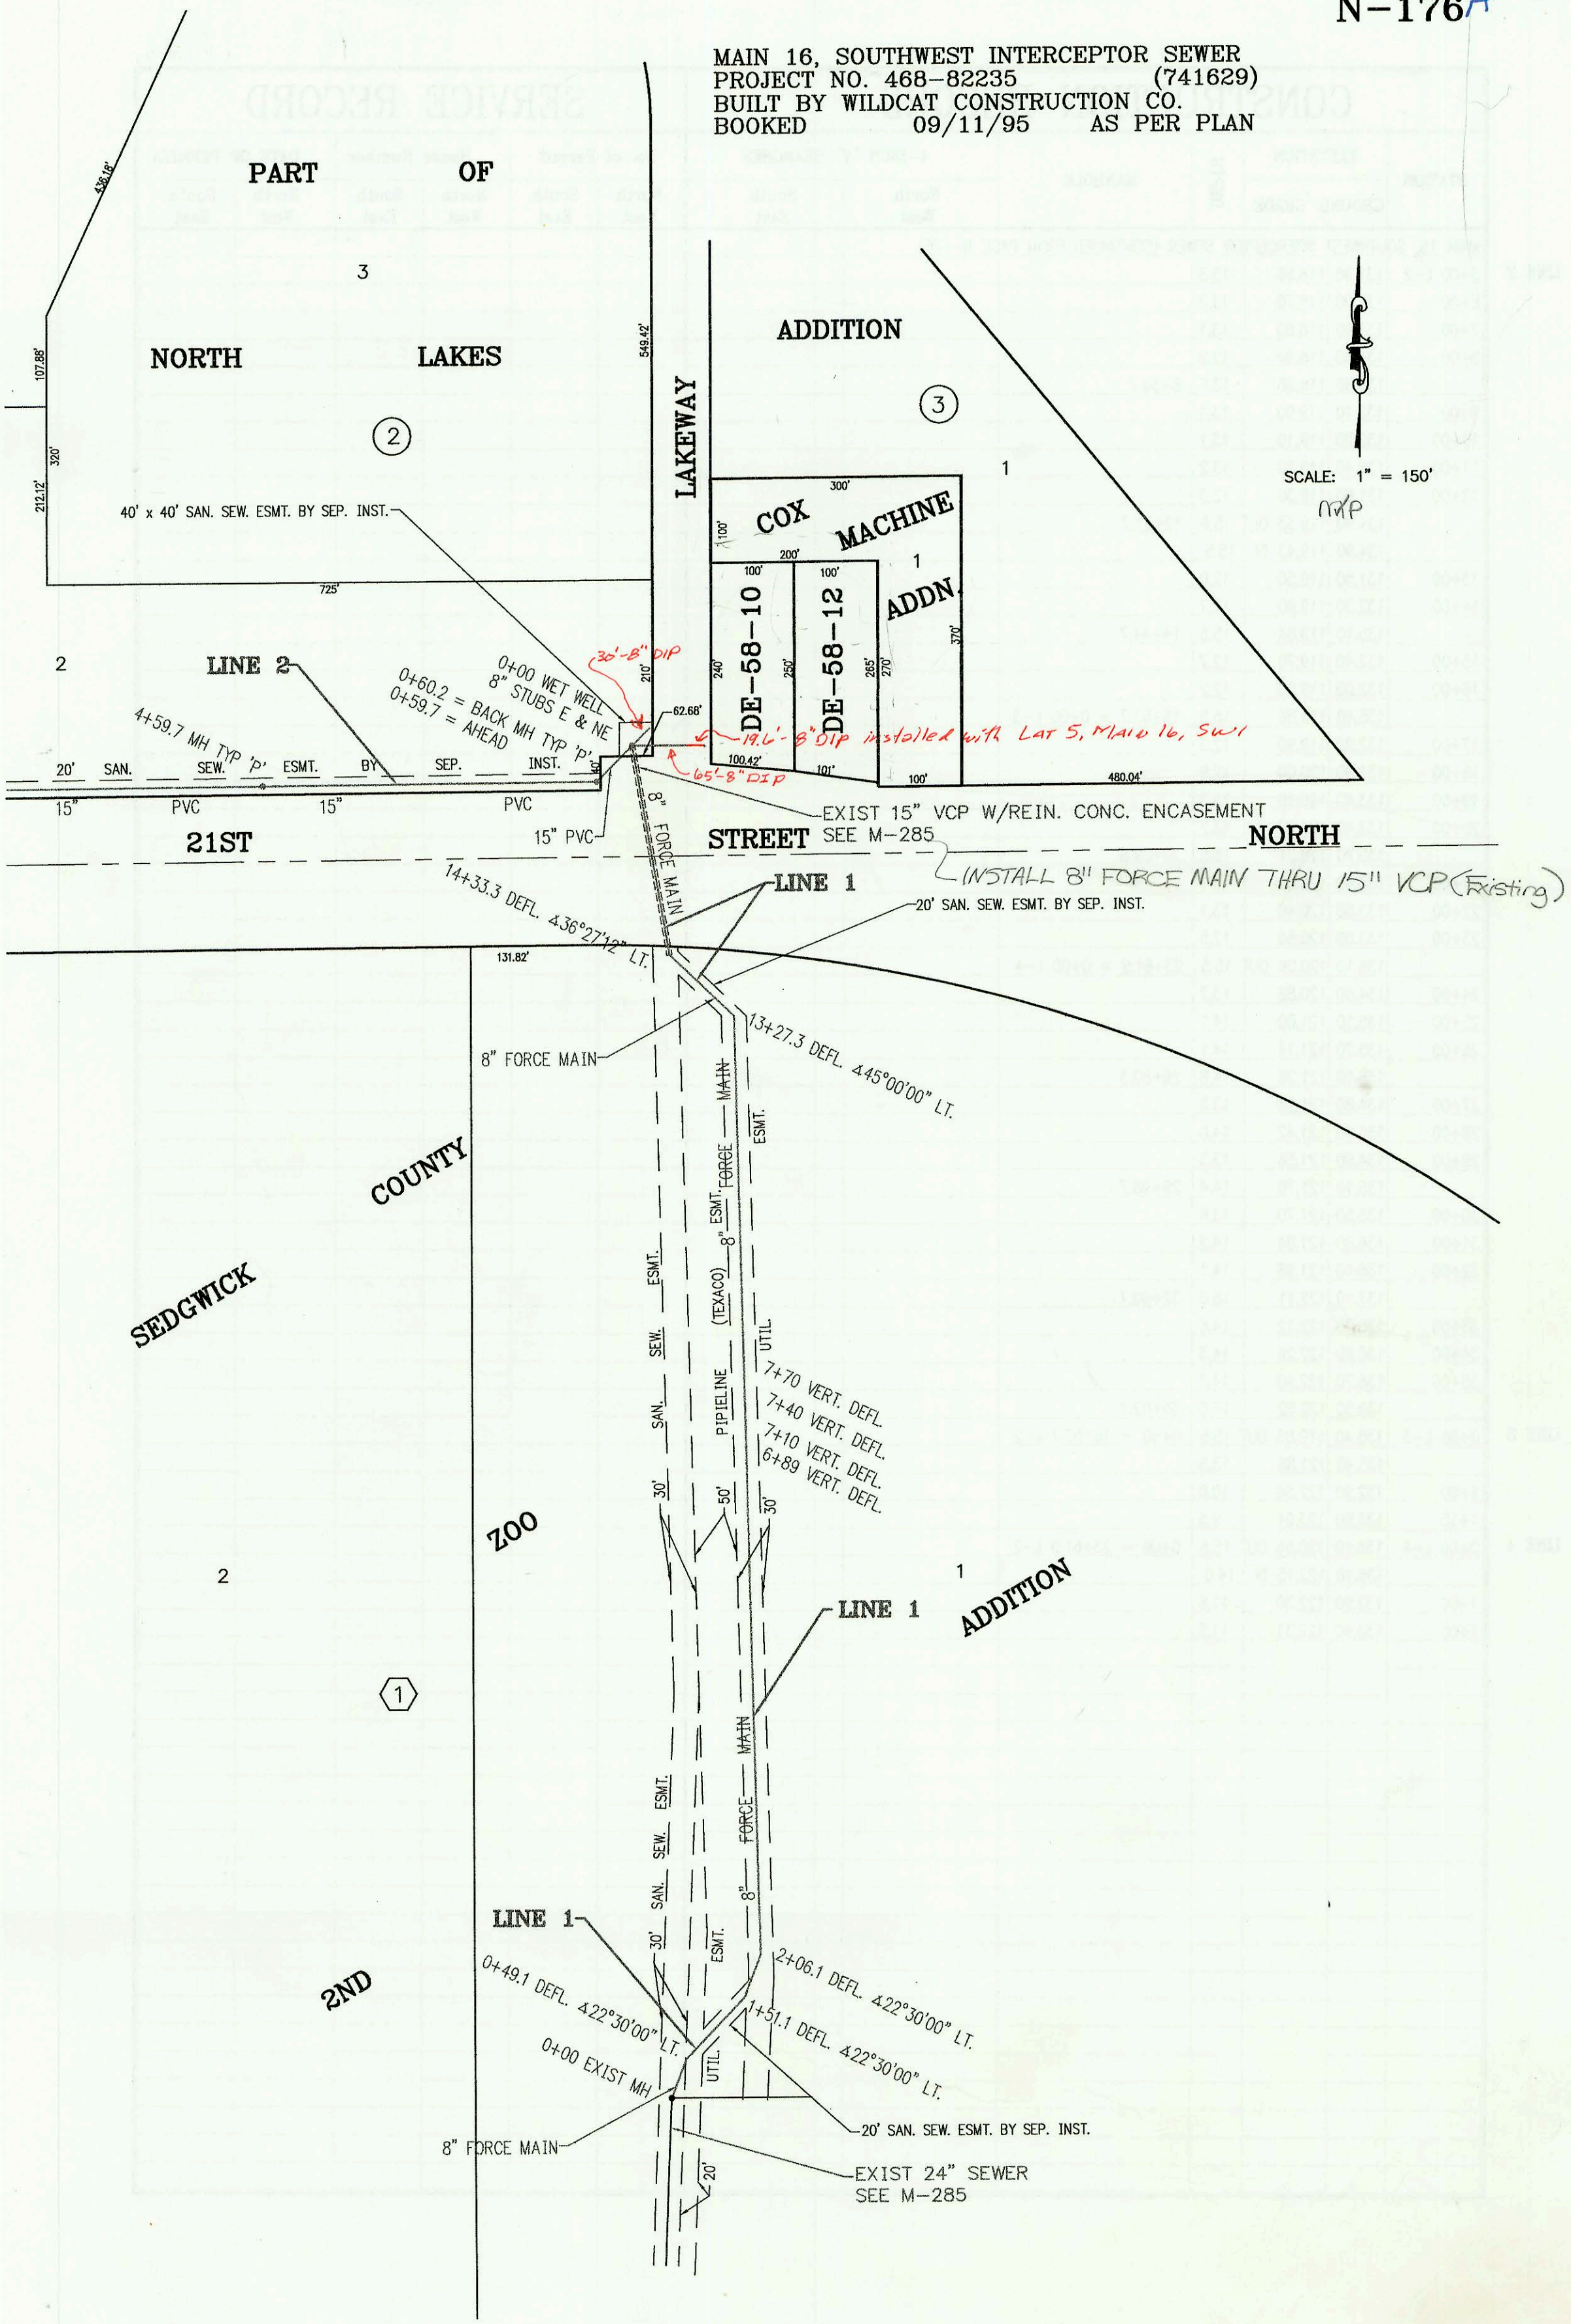

SCALE: 1" = 150'  
NXP

CONSTRUCTION RECORD					SERVICE RECORD							
STATION	ELEVATION		DEPTH	MANHOLE	4-INCH "Y" BRANCHES		No. of Permit		House Number		DATE OF PERMITS	
	GROUND	GRADE			North West	South East	North West	South East	North West	South East	North West	South East
MAIN 16, SOUTHWEST INTERCEPTOR SEWER												
LINE 1	0+00 L-1	132.38	119.18 OUT	13.2	0+00							
		132.38	127.00 IN	5.4								
	0+49.1	131.20	126.96	4.2								
	1+00	131.80	126.93	4.9								
	1+51.1	133.10	126.89	6.2								
	2+00	133.00	126.85	6.2								
	2+06.1	133.00	126.85	6.2								
	3+00	133.00	126.78	6.2								
	4+00	132.40	126.71	5.7								
	5+00	132.50	126.64	5.9								
	6+00	132.60	126.56	6.0								
	6+89	132.50	126.50	6.0								
	7+00	132.60	124.40	8.2								
	7+10	132.60	122.50	10.1								
	7+40	132.50	122.50	10.0								
	7+70	133.00	128.50	4.5								
	8+00	133.30	128.43	4.9								
	9+00	132.60	128.20	4.4								
	10+00	132.50	127.97	4.5								
	11+00	132.90	127.74	5.2								
	12+00	133.20	127.51	5.7								
	13+00	133.10	127.28	5.8								
	13+27.3	132.50	127.22	5.3								
	14+00	132.60	127.06	5.5								
	15+00	131.00	127.07	3.9								
	16+00	135.10	127.23	7.9								
	16+87.2	134.80	127.36	7.4	16+87.2 = 0+00 L-2							
LINE 2	0+00 L-2	134.80	127.36 OUT	7.4	0+00 = 16+87.2 L-1	8" NNE 118.00	8" E 118.00					
		132.40	118.06 OUT	14.3	0+59.7 BACK=0+60.2 AHEAD							
		132.40	118.16 IN	14.2								
	1+00	131.40	118.20	13.2								
	2+00	131.00	118.30	12.7								
	3+00	131.30	118.40	12.9								
	4+00	131.30	118.50	12.8								
		132.00	118.56	13.4	4+59.7							