


LATERAL 155, SANITARY SEWER NO. 22  
PROJECT NO. 468-82418 (742155)  
BUILT BY NOWAK CONSTRUCTION CO.  
9/26/95 PER AS BUILT PLAN

SCALE: 1" = 150'

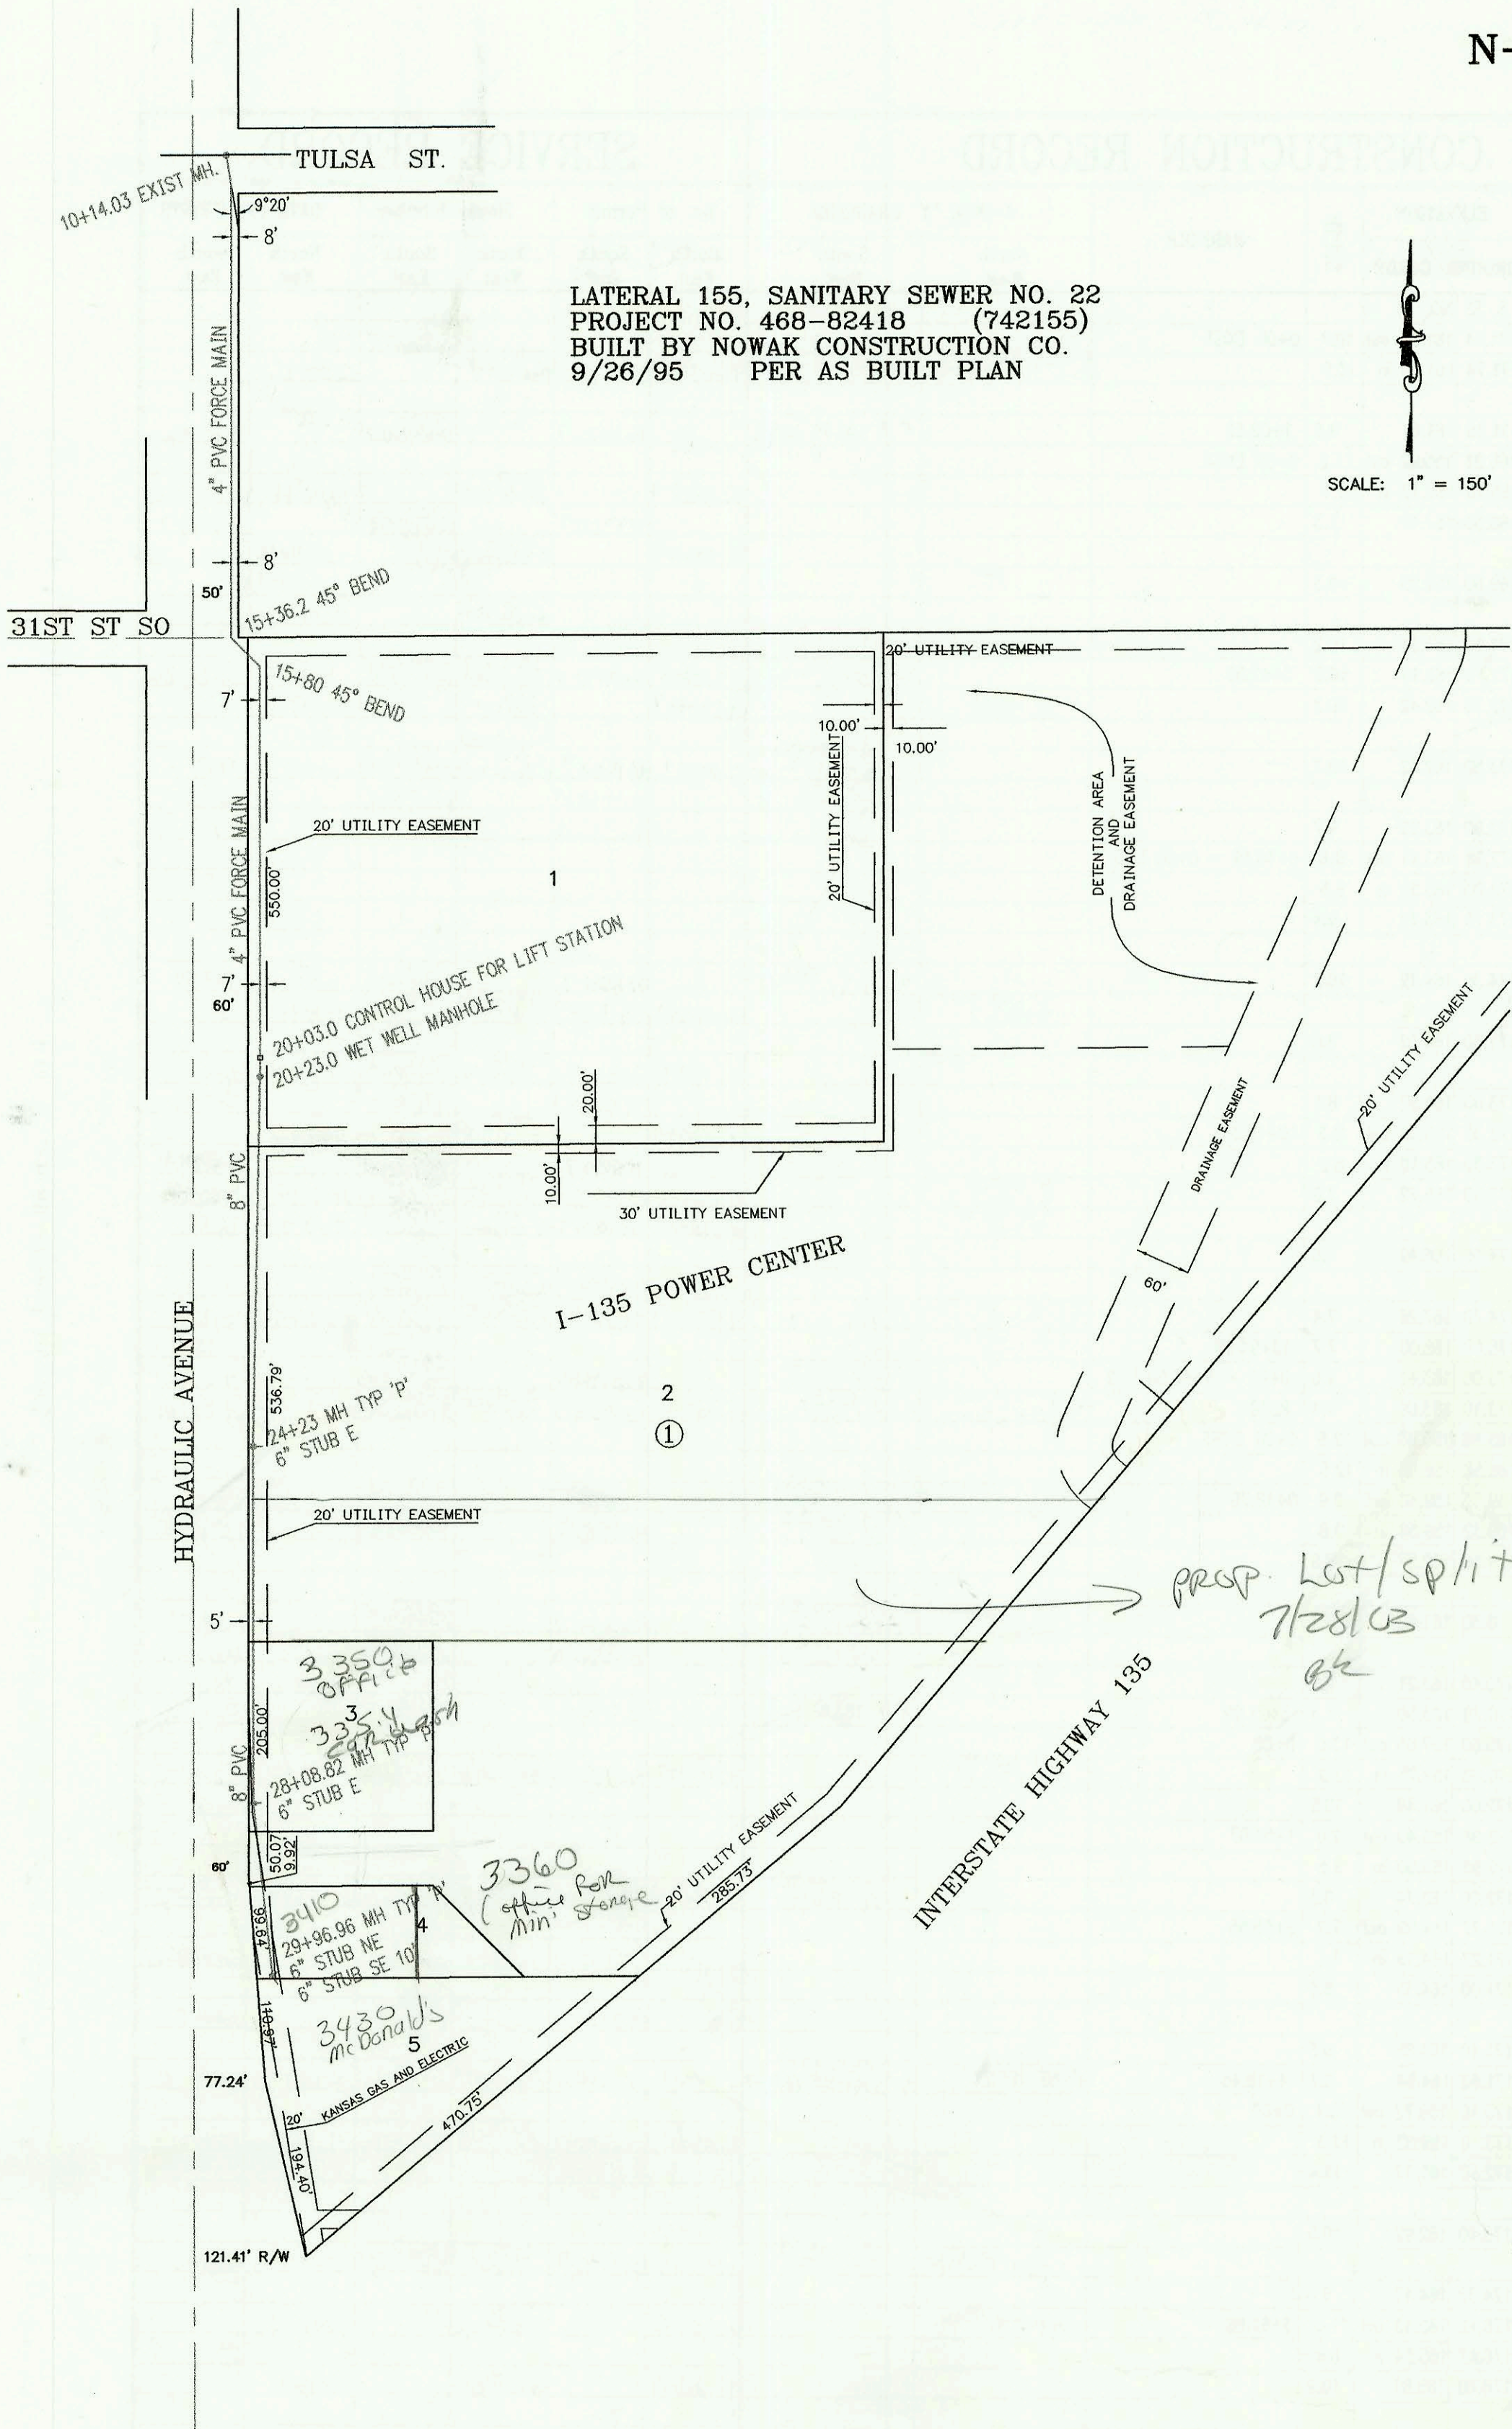

CONSTRUCTION RECORD						SERVICE RECORD						
STATION	ELEVATION		DEPTH	MANHOLE	4-INCH "Y" BRANCHES		No. of Permit		House Number		DATE OF PERMITS	
	GROUND	GRADE			North West	South East	North West	South East	North West	South East	North West	South East
LATERAL 155, S.S. NO. 22												
10+14.03	92.00	78.82 out	13.2	10+14.03 EXIST								
	92.00	87.00 in	5.0									
11+00	92.70	87.43	5.3									
12+00	92.20	87.28	4.9									
13+00	91.80	86.96	4.8									
14+00	91.80	86.75	5.1									
15+00	91.00	86.18	4.8									
16+00	88.30	83.63	4.7									
17+00	88.30	83.46	4.8									
18+00	88.20	83.19	5.0									
19+00	88.20	83.17	5.0									
20+00	87.80	83.17	4.6									
	88.50	83.17 out	5.3	20+23.0 WET WELL	8" NE 78.00							
	88.50	77.37 in	11.1									
21+00	88.20	77.73	10.5									
22+00	88.00	78.13	9.9									
23+00	88.10	78.53	9.6									
24+00	87.90	78.93	9.0									
	88.40	78.97 out	9.4	24+23.0	6" E 79.77							
	88.40	79.07 in	9.3									
25+00	87.40	79.33	8.1									
26+00	86.80	79.73	7.1									
27+00	86.40	80.13	6.3			27+06.3		2002 83210 2003 80319	3354 Hydraulic SID 3354 Hydraulic	11-25-02 2-5-03		
28+00	85.40	80.53	4.9									
	85.90	80.65 out	5.3	28+08.82	6" E 81.45							
	85.90	80.75 in	5.2					99-0110	3410 Hydraulic	11-4-84		
29+00	85.30	80.93	4.4									
	86.50	81.50	5.0	29+96.96	6" NE 81.60	6" sch 40 6" SE 81.60		95-50047	3430 S Hydraulic	4-12-95		
LAT 63, MAIN 5, S.S. NO. 23 (CONT. FROM N-179)												
5+00	177.00	166.09	10.9			4" sch 40 5106.8		75-4508-7	2714 Meadows Hydraulic	3-25-98		
6+00	177.90	166.49	11.4									
7+00	179.00	166.89	12.1									
	179.58	167.00	12.6	7+26.02	4" NW 167.33			96-7475-7	8796 Meadows Hydraulic	5-17-96		