



PRIVATE SANITARY SEWER EXTENSION TO SERVE L. R. JONES ADDITION  
 PRIVATE PROJECT NO. 552PPS (607861)  
 BUILT BY SCOTT CONSTRUCTION CO.  
 BOOKED 10/13/95 FROM AS BUILTS

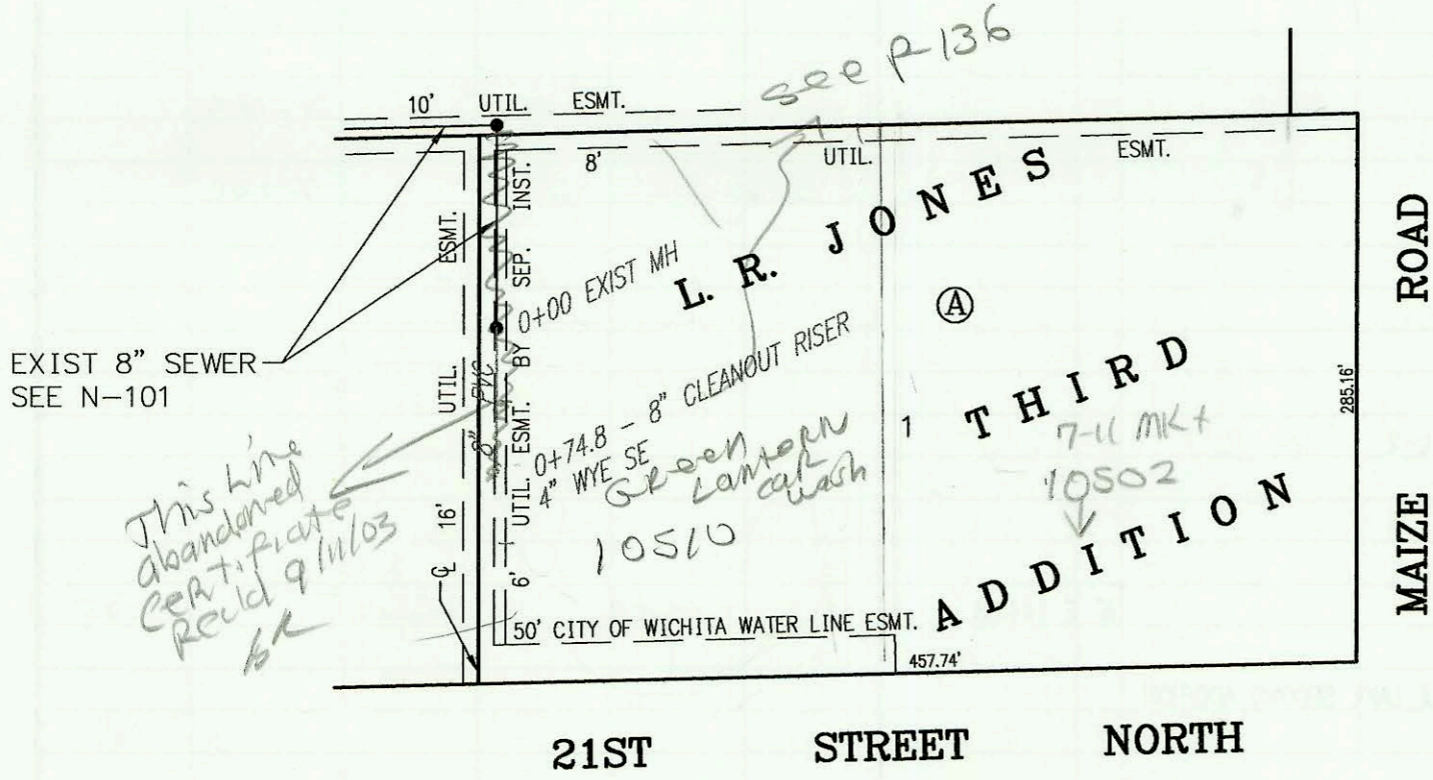

37th STREET NORTH

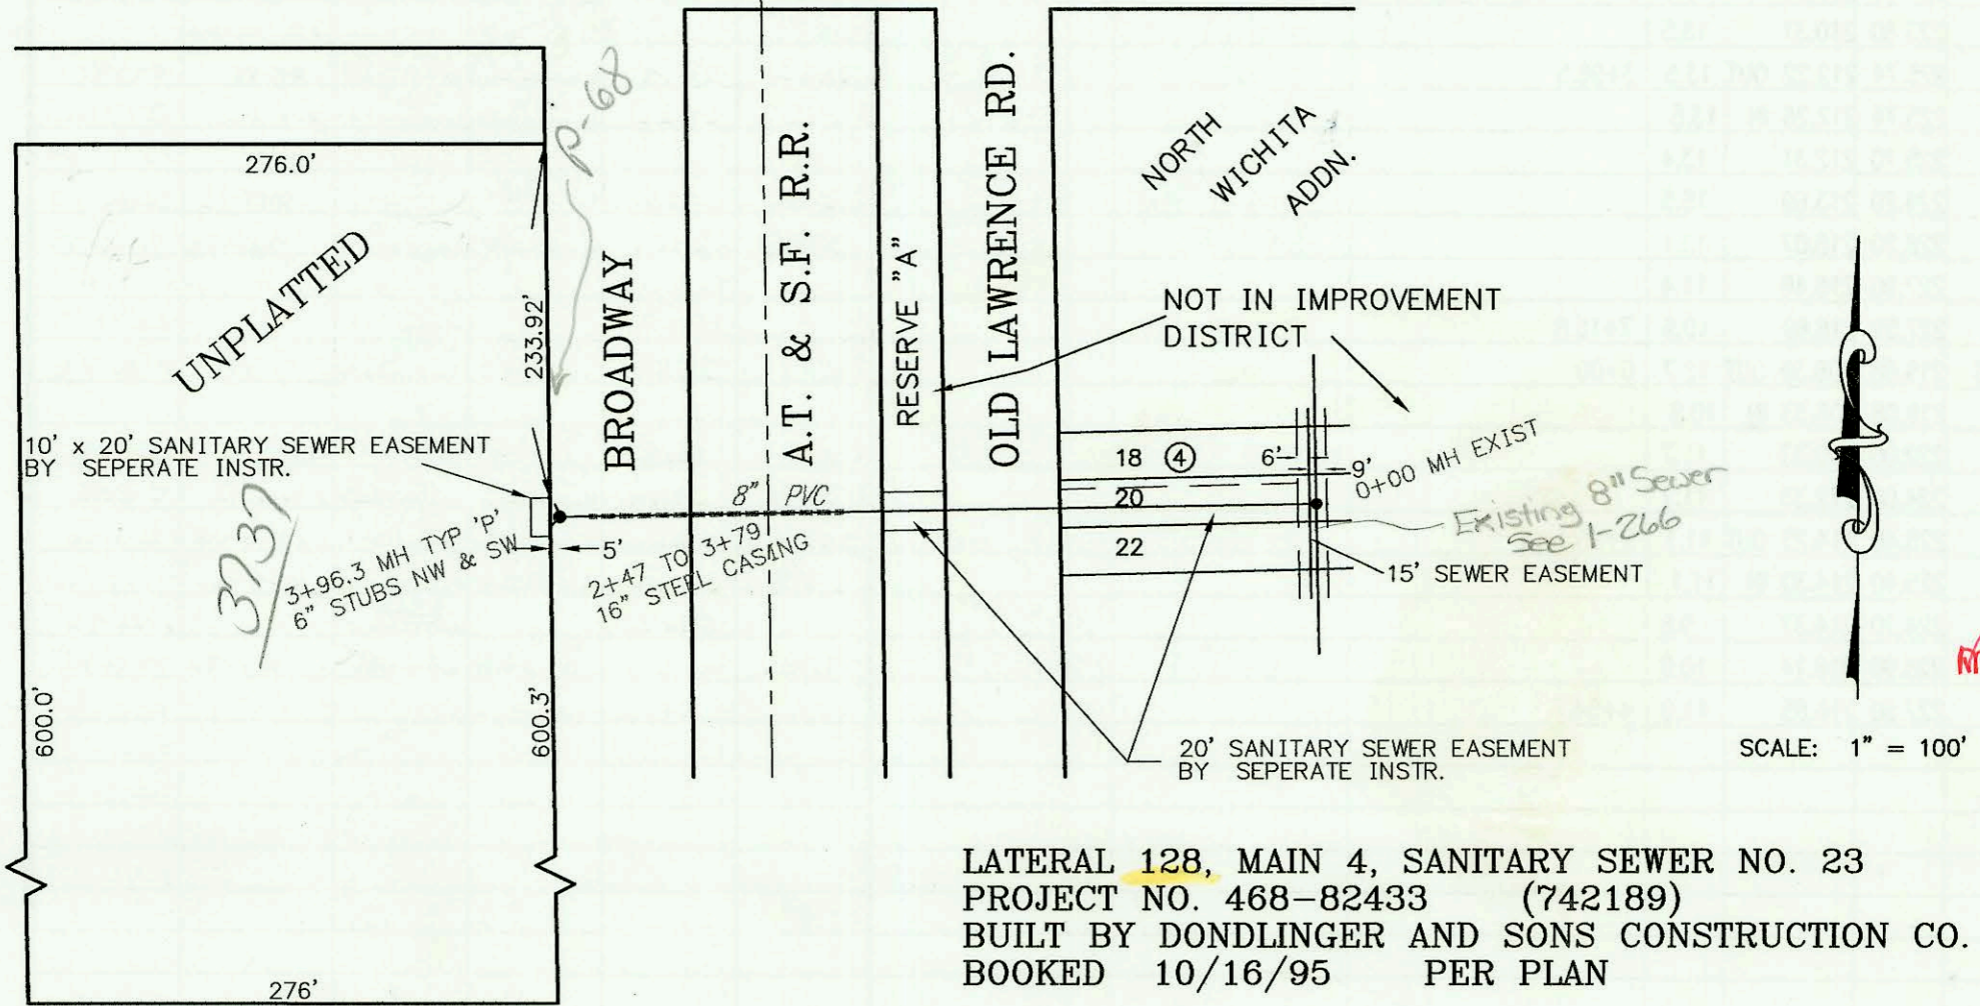

LATERAL 128, MAIN 4, SANITARY SEWER NO. 23  
 PROJECT NO. 468-82433 (742189)  
 BUILT BY DONDLINGER AND SONS CONSTRUCTION CO.  
 BOOKED 10/16/95 PER PLAN

CONSTRUCTION RECORD						SERVICE RECORD						
STATION	ELEVATION		DEPTH	MANHOLE	4-INCH "Y" BRANCHES		No. of Permit		House Number		DATE OF PERMITS	
	GROUND	GRADE			North West	South East	North West	South East	North West	South East	North West	South East
PRIVATE SANITARY SEWER EXTENSION TO SERVE L. R. JONES ADDITION												
0+00	163.70	154.43 OUT	9.3	0+00								
	163.70	154.70 IN	9.0					2005-03417 95-163787		10502 w 2157		11-7-95 10-17-95
0+74.80	163.20	154.86	8.3			0+72.8 4" WYE SE						
LATERAL 128, MAIN 4, SANITARY SEWER NO. 23												
0+00	133.69	125.04	8.7	0+00 EXIST								
1+00	132.70	125.34	7.4									
2+00	131.00	125.78	5.2									
3+00	131.80	125.93	5.9									
	132.70	126.22	6.5	3+96.3	6" NW 126.55	6" SW 126.55		95-16247		377 N Broadway		11-22-95